

6-26

8

106

PT -005
PT 27.25A.

009-26.84AC

~~008~~ 0.11
~~2.67A~~ 2.39AC

7288
APPROVED
LORAIN CO.
MAP DEPT.
DATE 8-14-73
75-6-26
BY L.H. Hall

14157.14

008 108AC 7

1419.86

12827' 1396.20 Taken water
Road Record Vol 4, Pg 58-82

PT -023
PT 6.17A


010
1.00A.

011
50A.

002
.35A.

7284
7288
2-003

TO KEEP
N.0°14'E.
28°

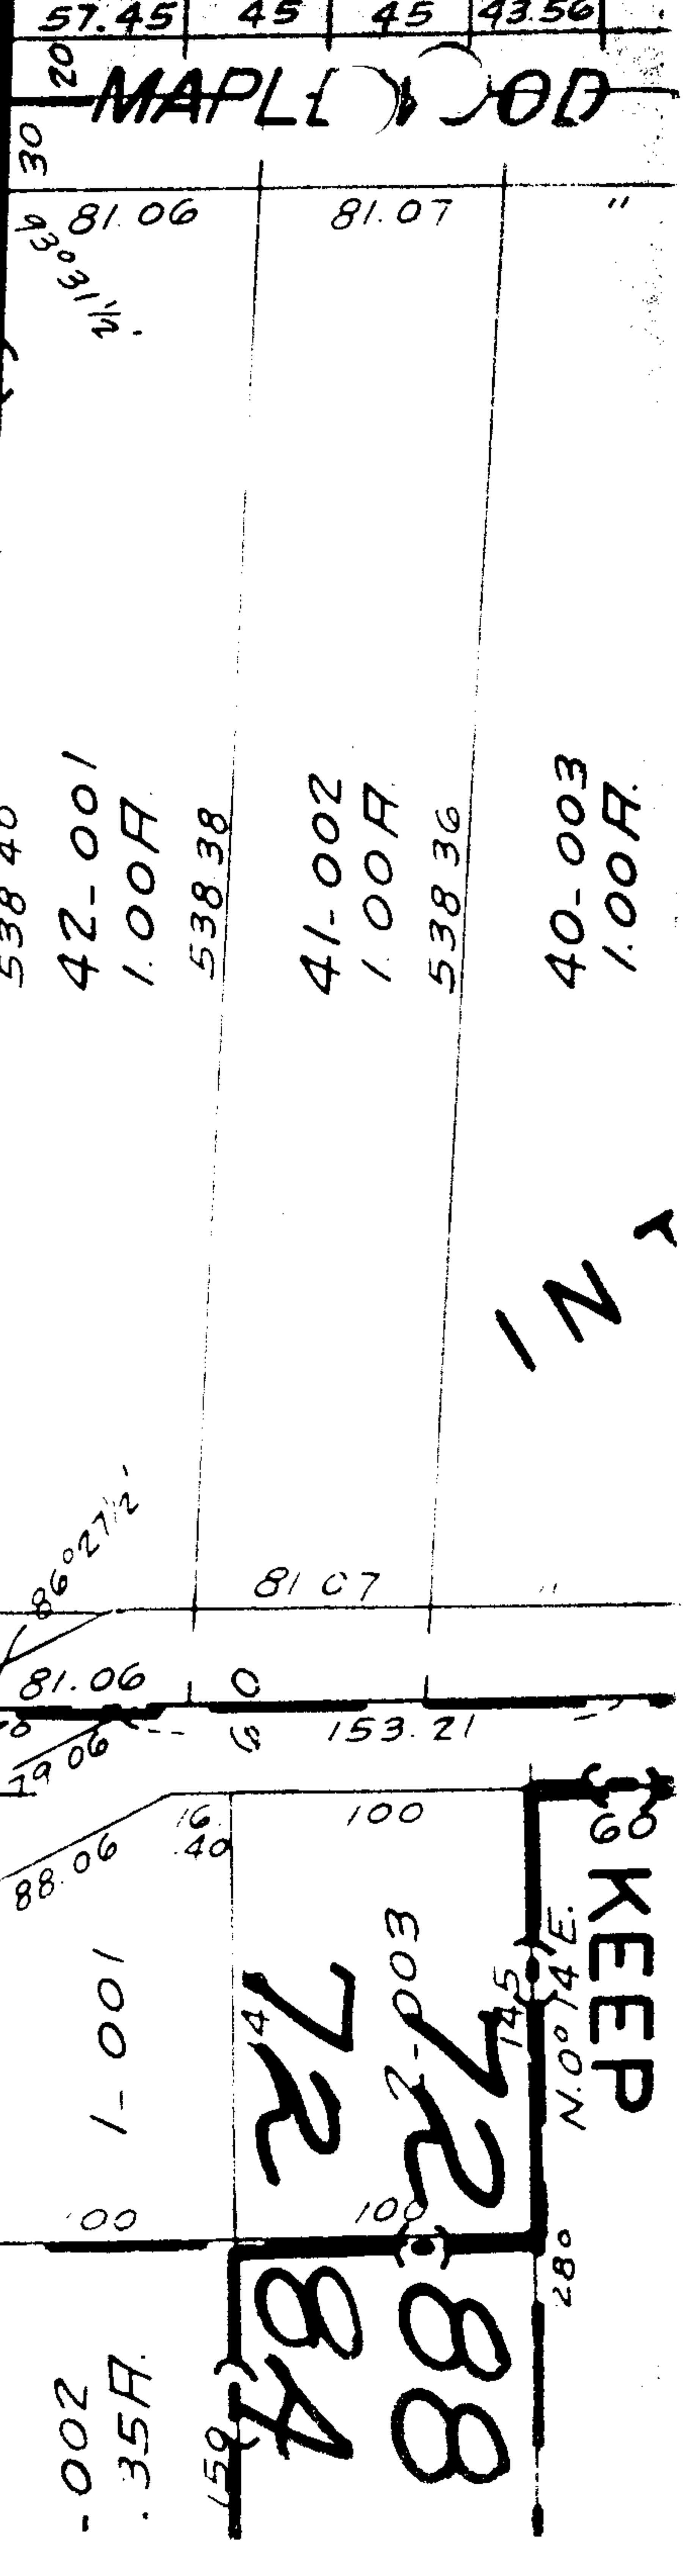

MAPLEWOOD

81.06
115°31'1/2"

81.07

299.86

1022.55

538.40

42-001
1.00A.

538.38

41-002
1.00A.

538.36

40-003
1.00A.

381.00

42-001
1.00A.

538.38

41-002
1.00A.

538.36

40-003
1.00A.

81.07

299.74

0.22AC

81.06

153.21

153.42'

193.45'

88.06

16.40

100

107.10

1-001

150.77

002
.35A.

159

7284
7288

28°