

7289

OK

7289

APPROVED
LORAIN CO.
MAR DEPT.

DATE 8-15-73

14-C

BY

[Signature]


7-29-86 k.k.

1814.53

37

-004
~~-002~~
~~104.01 F.~~
~~1.26~~
103.58 Ac

[Handwritten scribble]

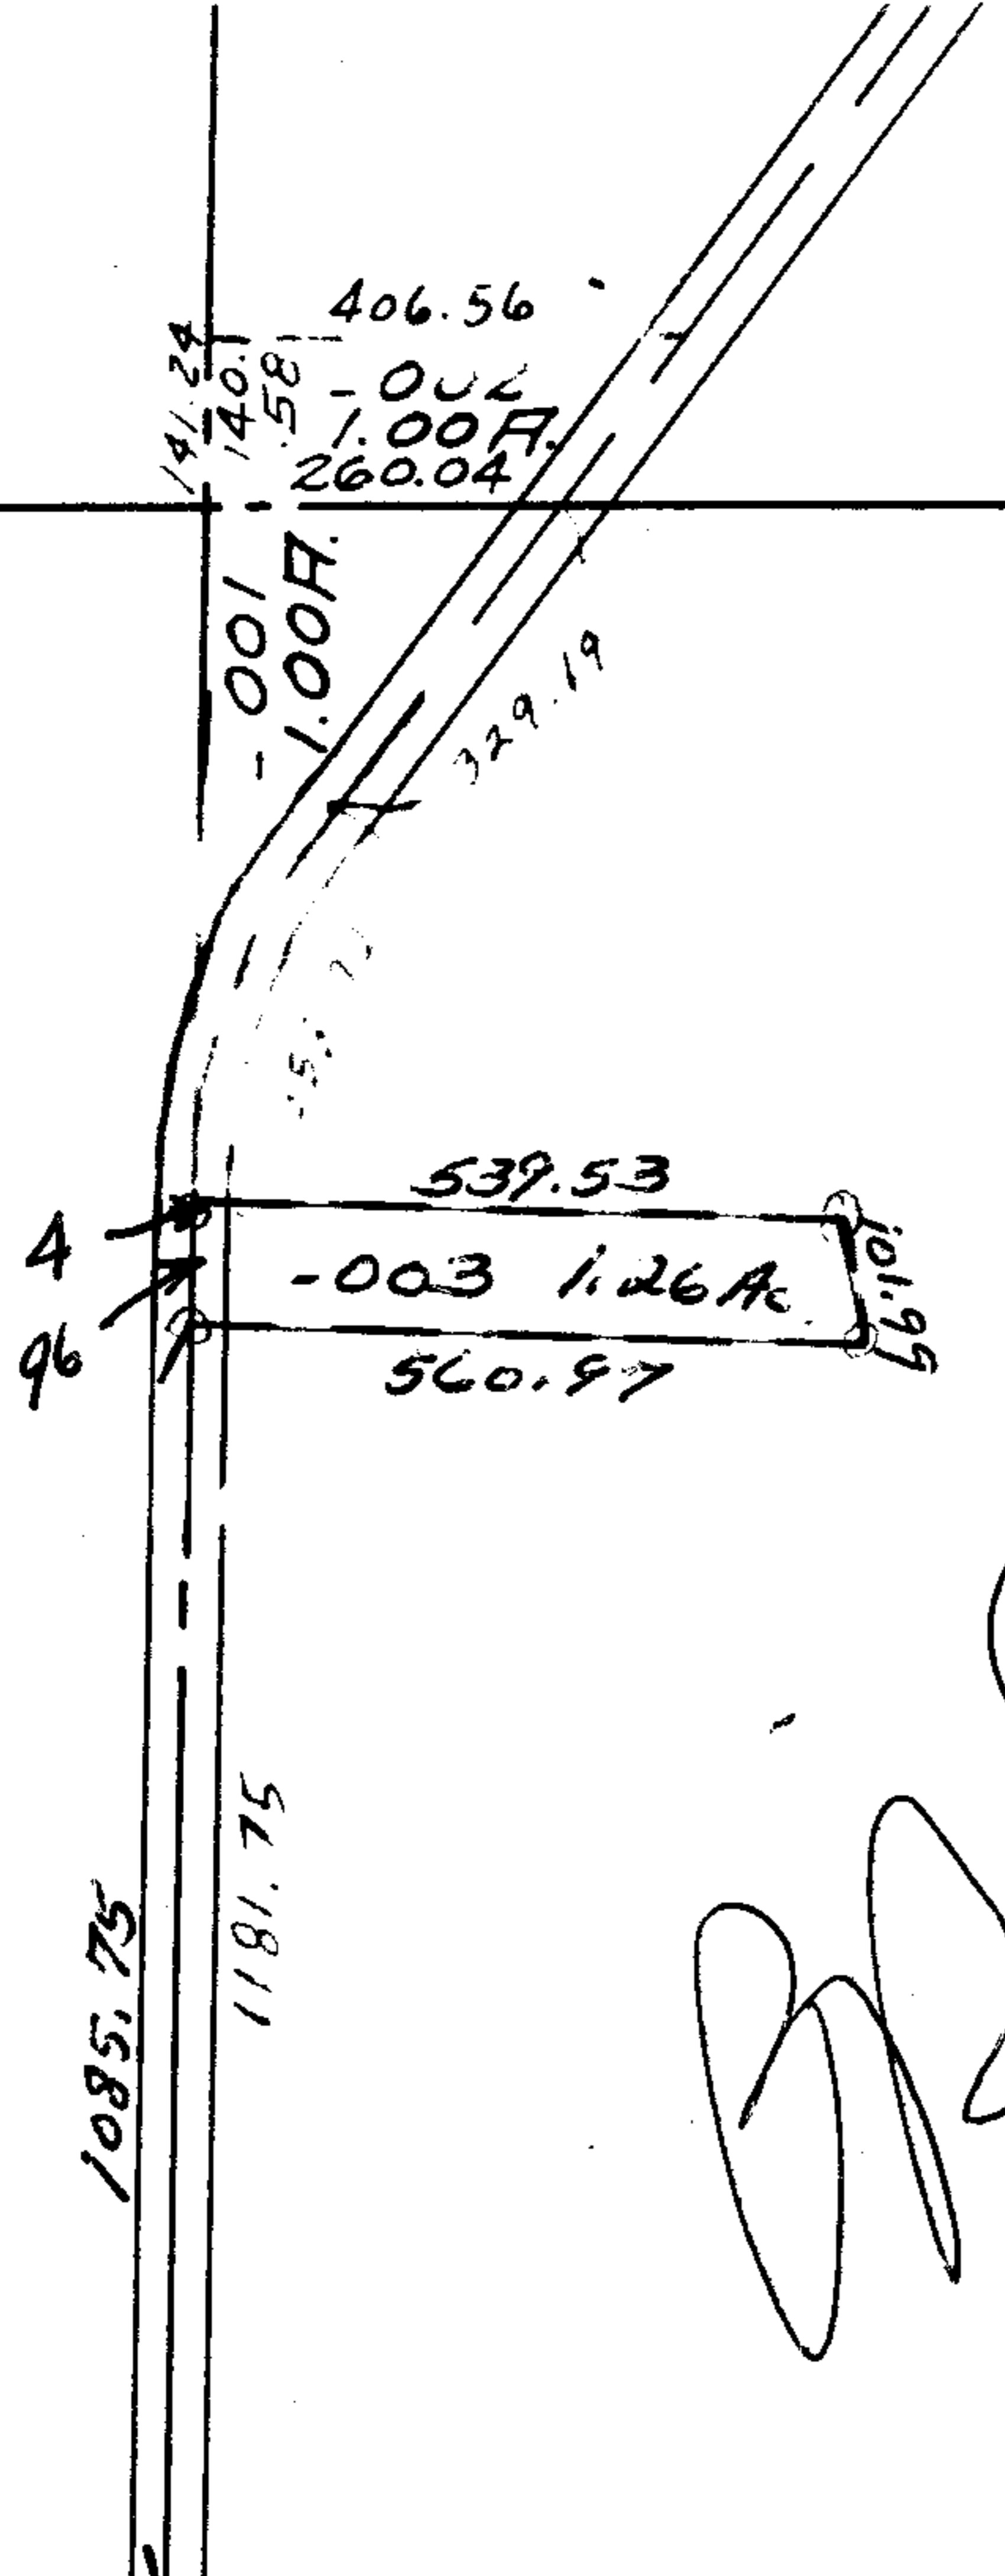

10.86
2.1
11.82

2592

160
-003
1.10F.
300

-001
13.33F.

-002
6.67F.

-003
30.00F.

44

-007
26.00A.

-004
23.00F.

7440.80

-001 7.00F.

-002
3.00F.

125
349
-004
1.00A
349

198
-003
1.00F.
220

-004
17.00F.

220.58
-006
1.00A
220.58

1613.04