


7302

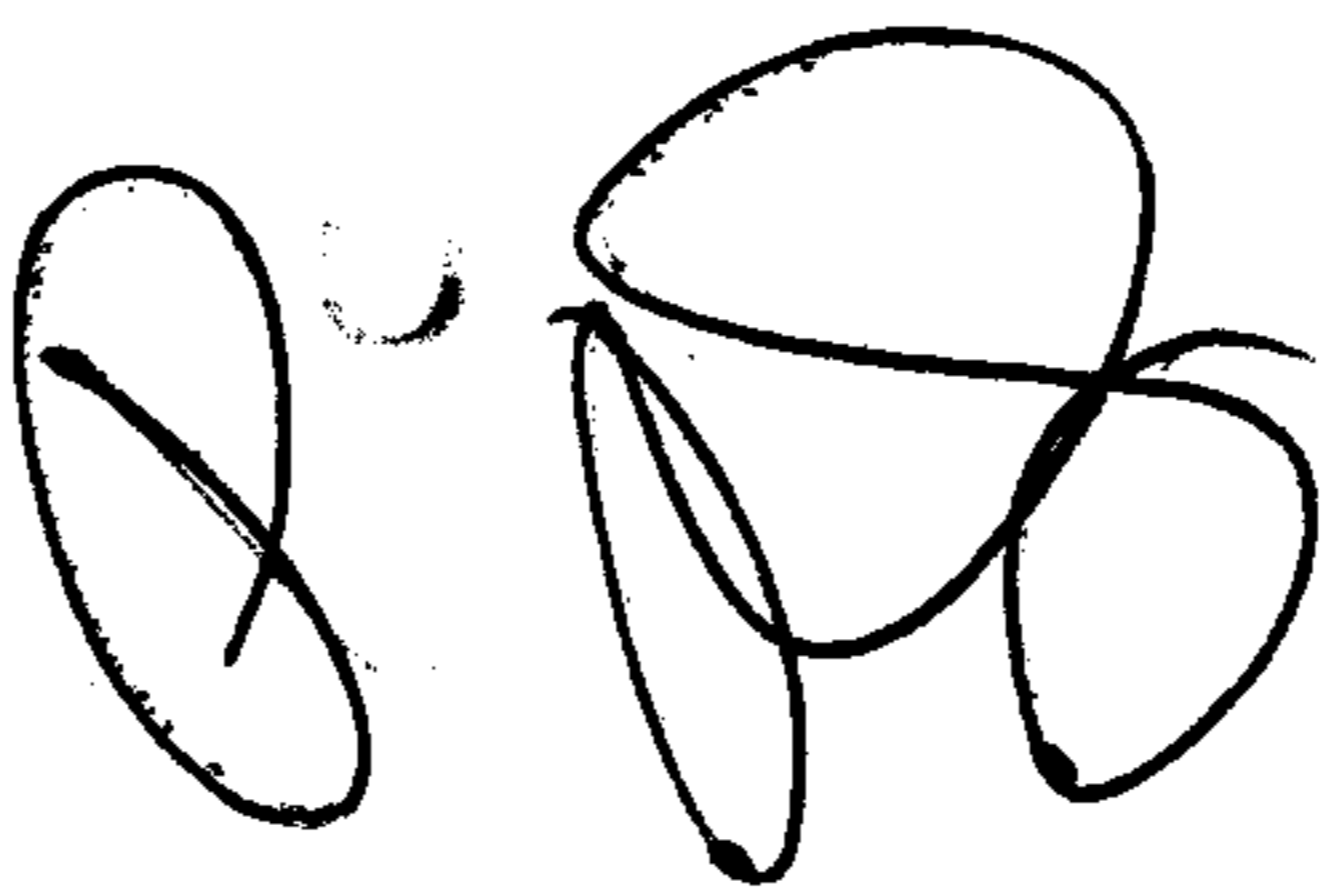

-009
48.32 A.

300
-008
1.27R

WHITNEY

150
230
-007
.79A
230

185

300 (60)

817.03D

396

1318.02
- 544.58 ✓
773.44
187.00 ✓
586.44 ✓

OK

-002
47.00A

7302

APPROVED
LORAIN CO.
MAP DEPT.
DATE 8-15-73
15E
BY LWHall

7-29-86 L.H.

187
1318.02R
-010
1.00AC
187
233

011
~~007~~
24.72A
23.72 AC

1318.02D
1320

-208
12.00A

1320

817.03D
-007
3.87A
817.08

396

79

-006
15.13 A

-009
28.28A

SEE
SURVEY

-005
29.00A

-004
40.00A

-001
39.00A

5-00-064-500-001 Pt. 34.95A