


7312

SEE 12-D

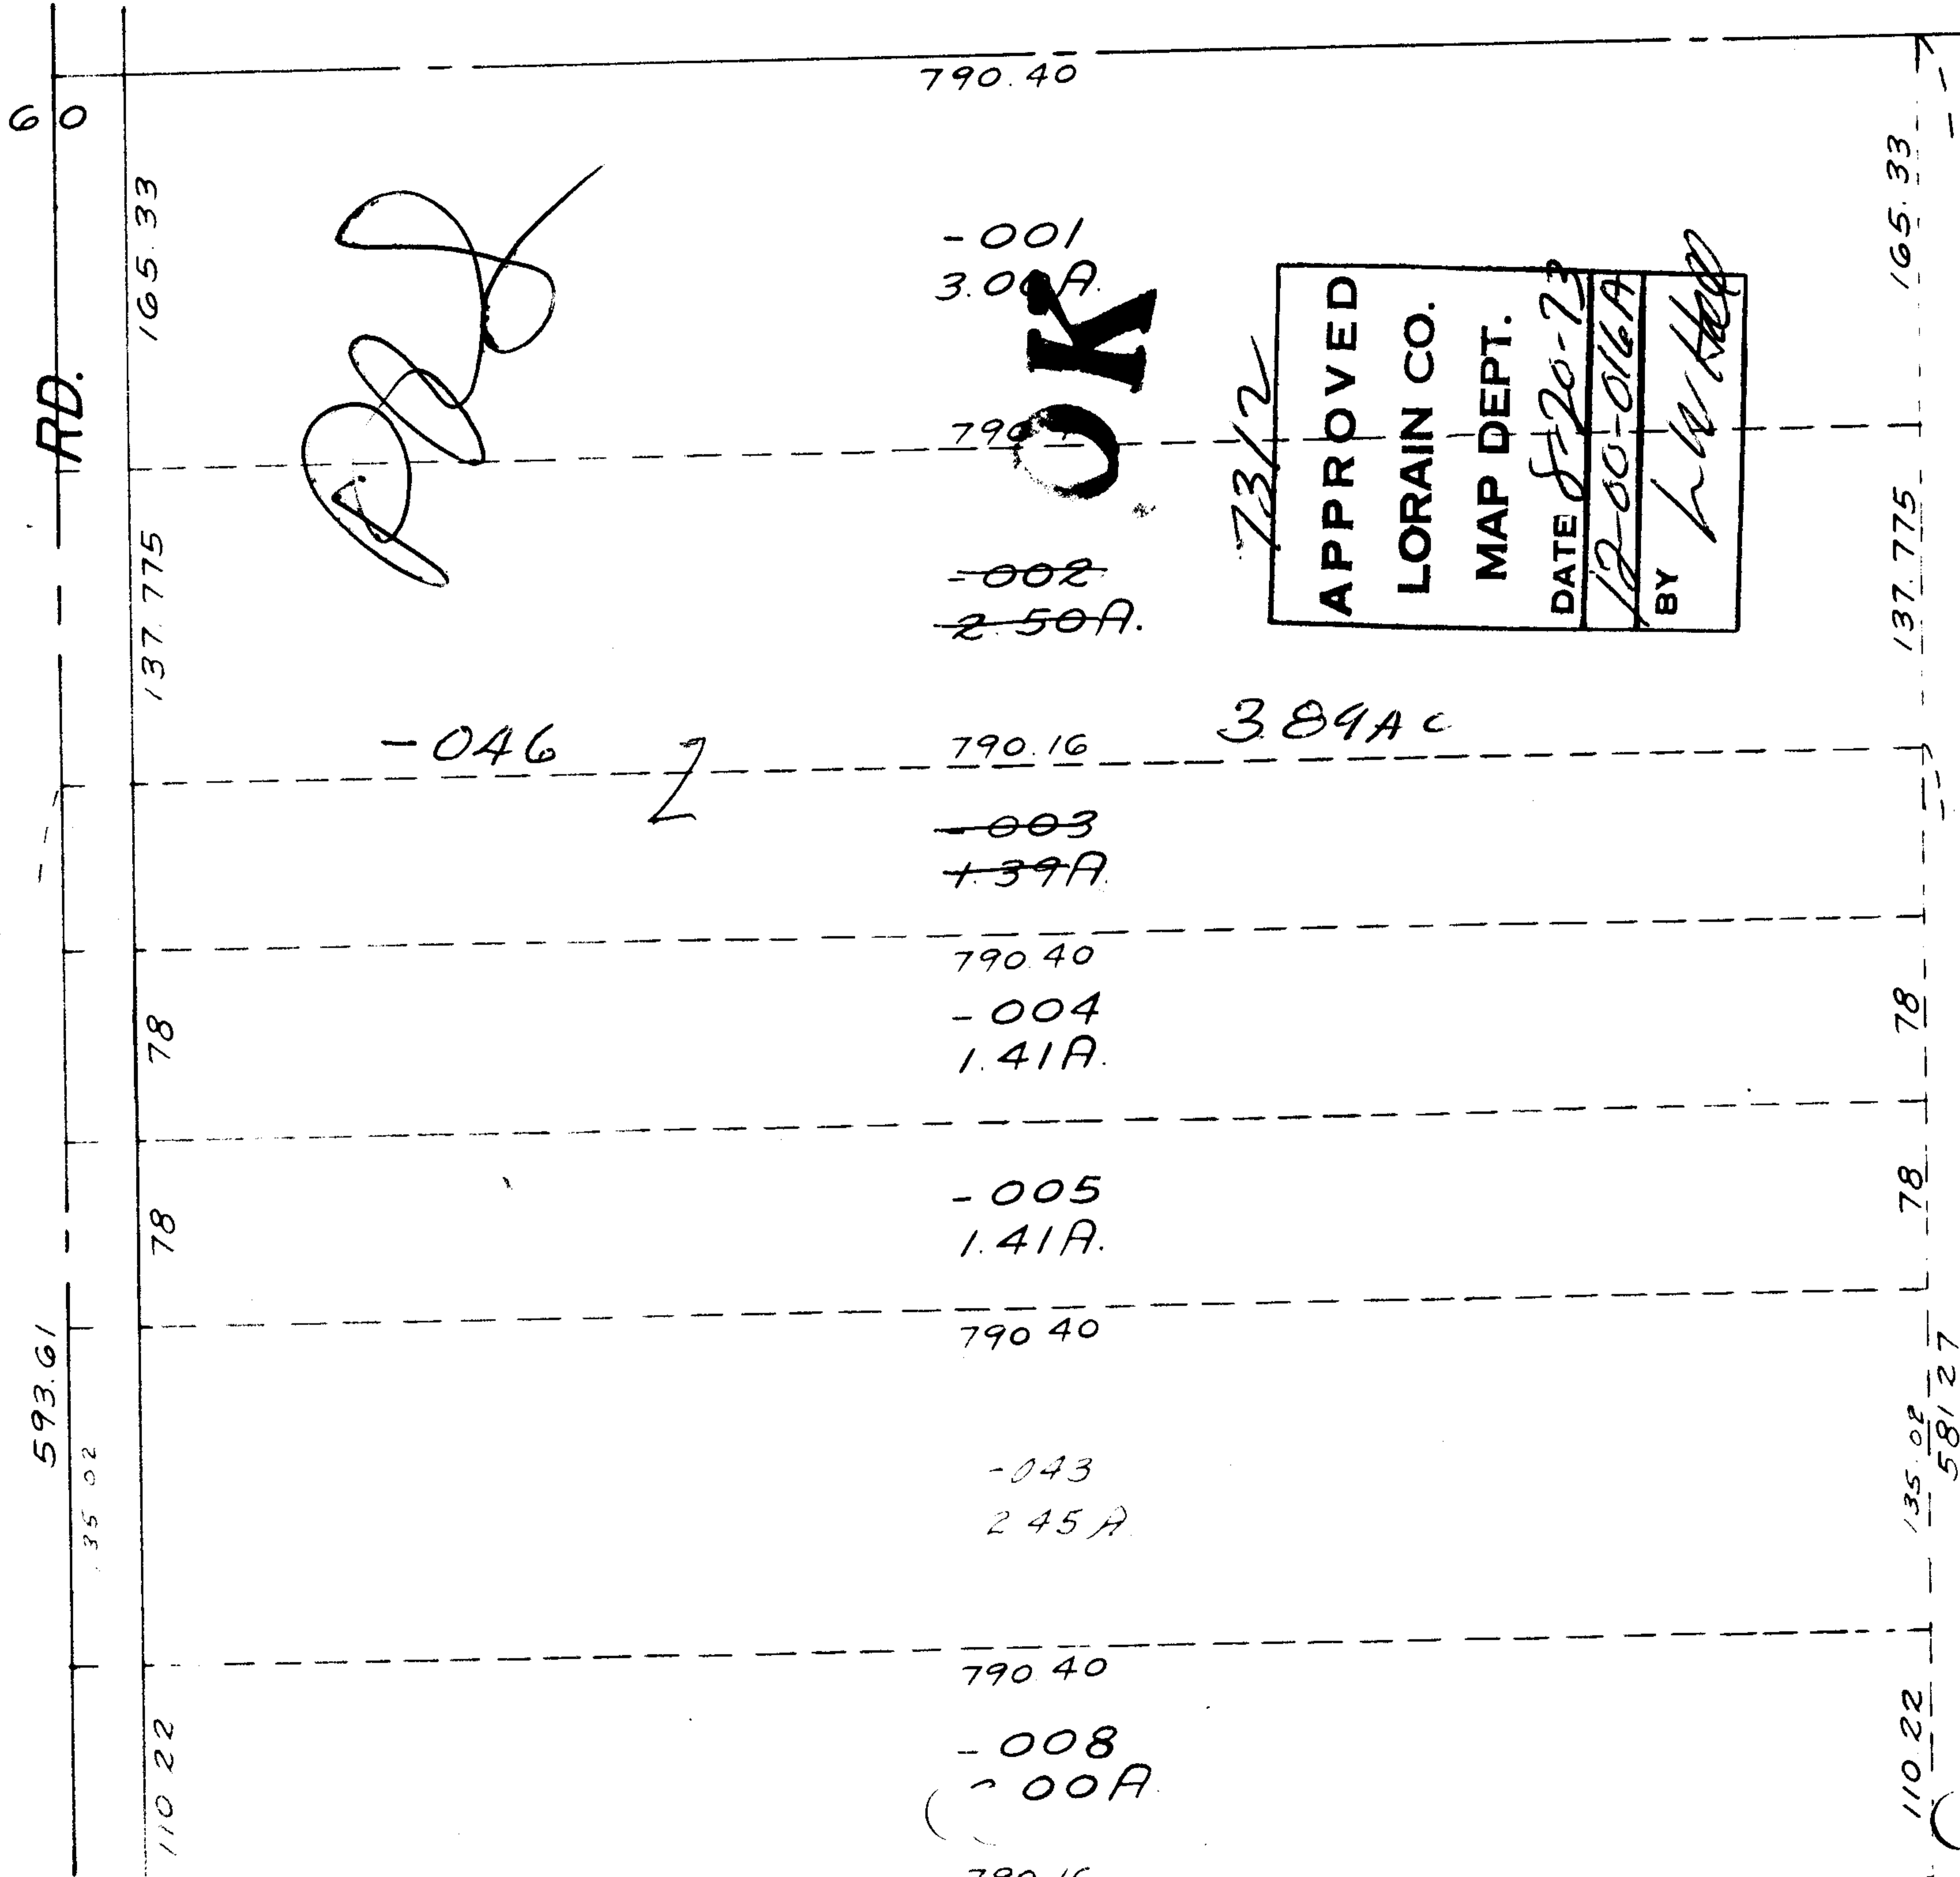

[Large scribble]

-001
3.00A

OK

7312

APPROVED
LORAIN CO.
MAP DEPT.
DATE 8-20-73
12-00-016A
BY h w h

~~-002~~
2.50A

-046 2

790.16 3.89AC

~~-003~~
+39A

790.40
-004
1.41A

-005
1.41A

790.40

-043
2.45A

790.40

-008
2.00A

790.16