

BLK. C" - 026

370.07
BLK. D" - 027
371.58

376.72

SEE 12-A

OK

91.22

1463.42

303.43

100.01

342.27

350.04

109.82

-036
.75 Ac.

105.26

-034 .82 A.

303.40

7328

APPROVED
LORAIN CO.
MAP DEPT.
DATE 8-24-73
11-00-007-B
BY *[Signature]*

~~035~~
~~9.18 A.~~


-037
8.43 Ac.

~~Change
Next Year~~

S.S.
8-5-86

1462

-028
8.50 A.

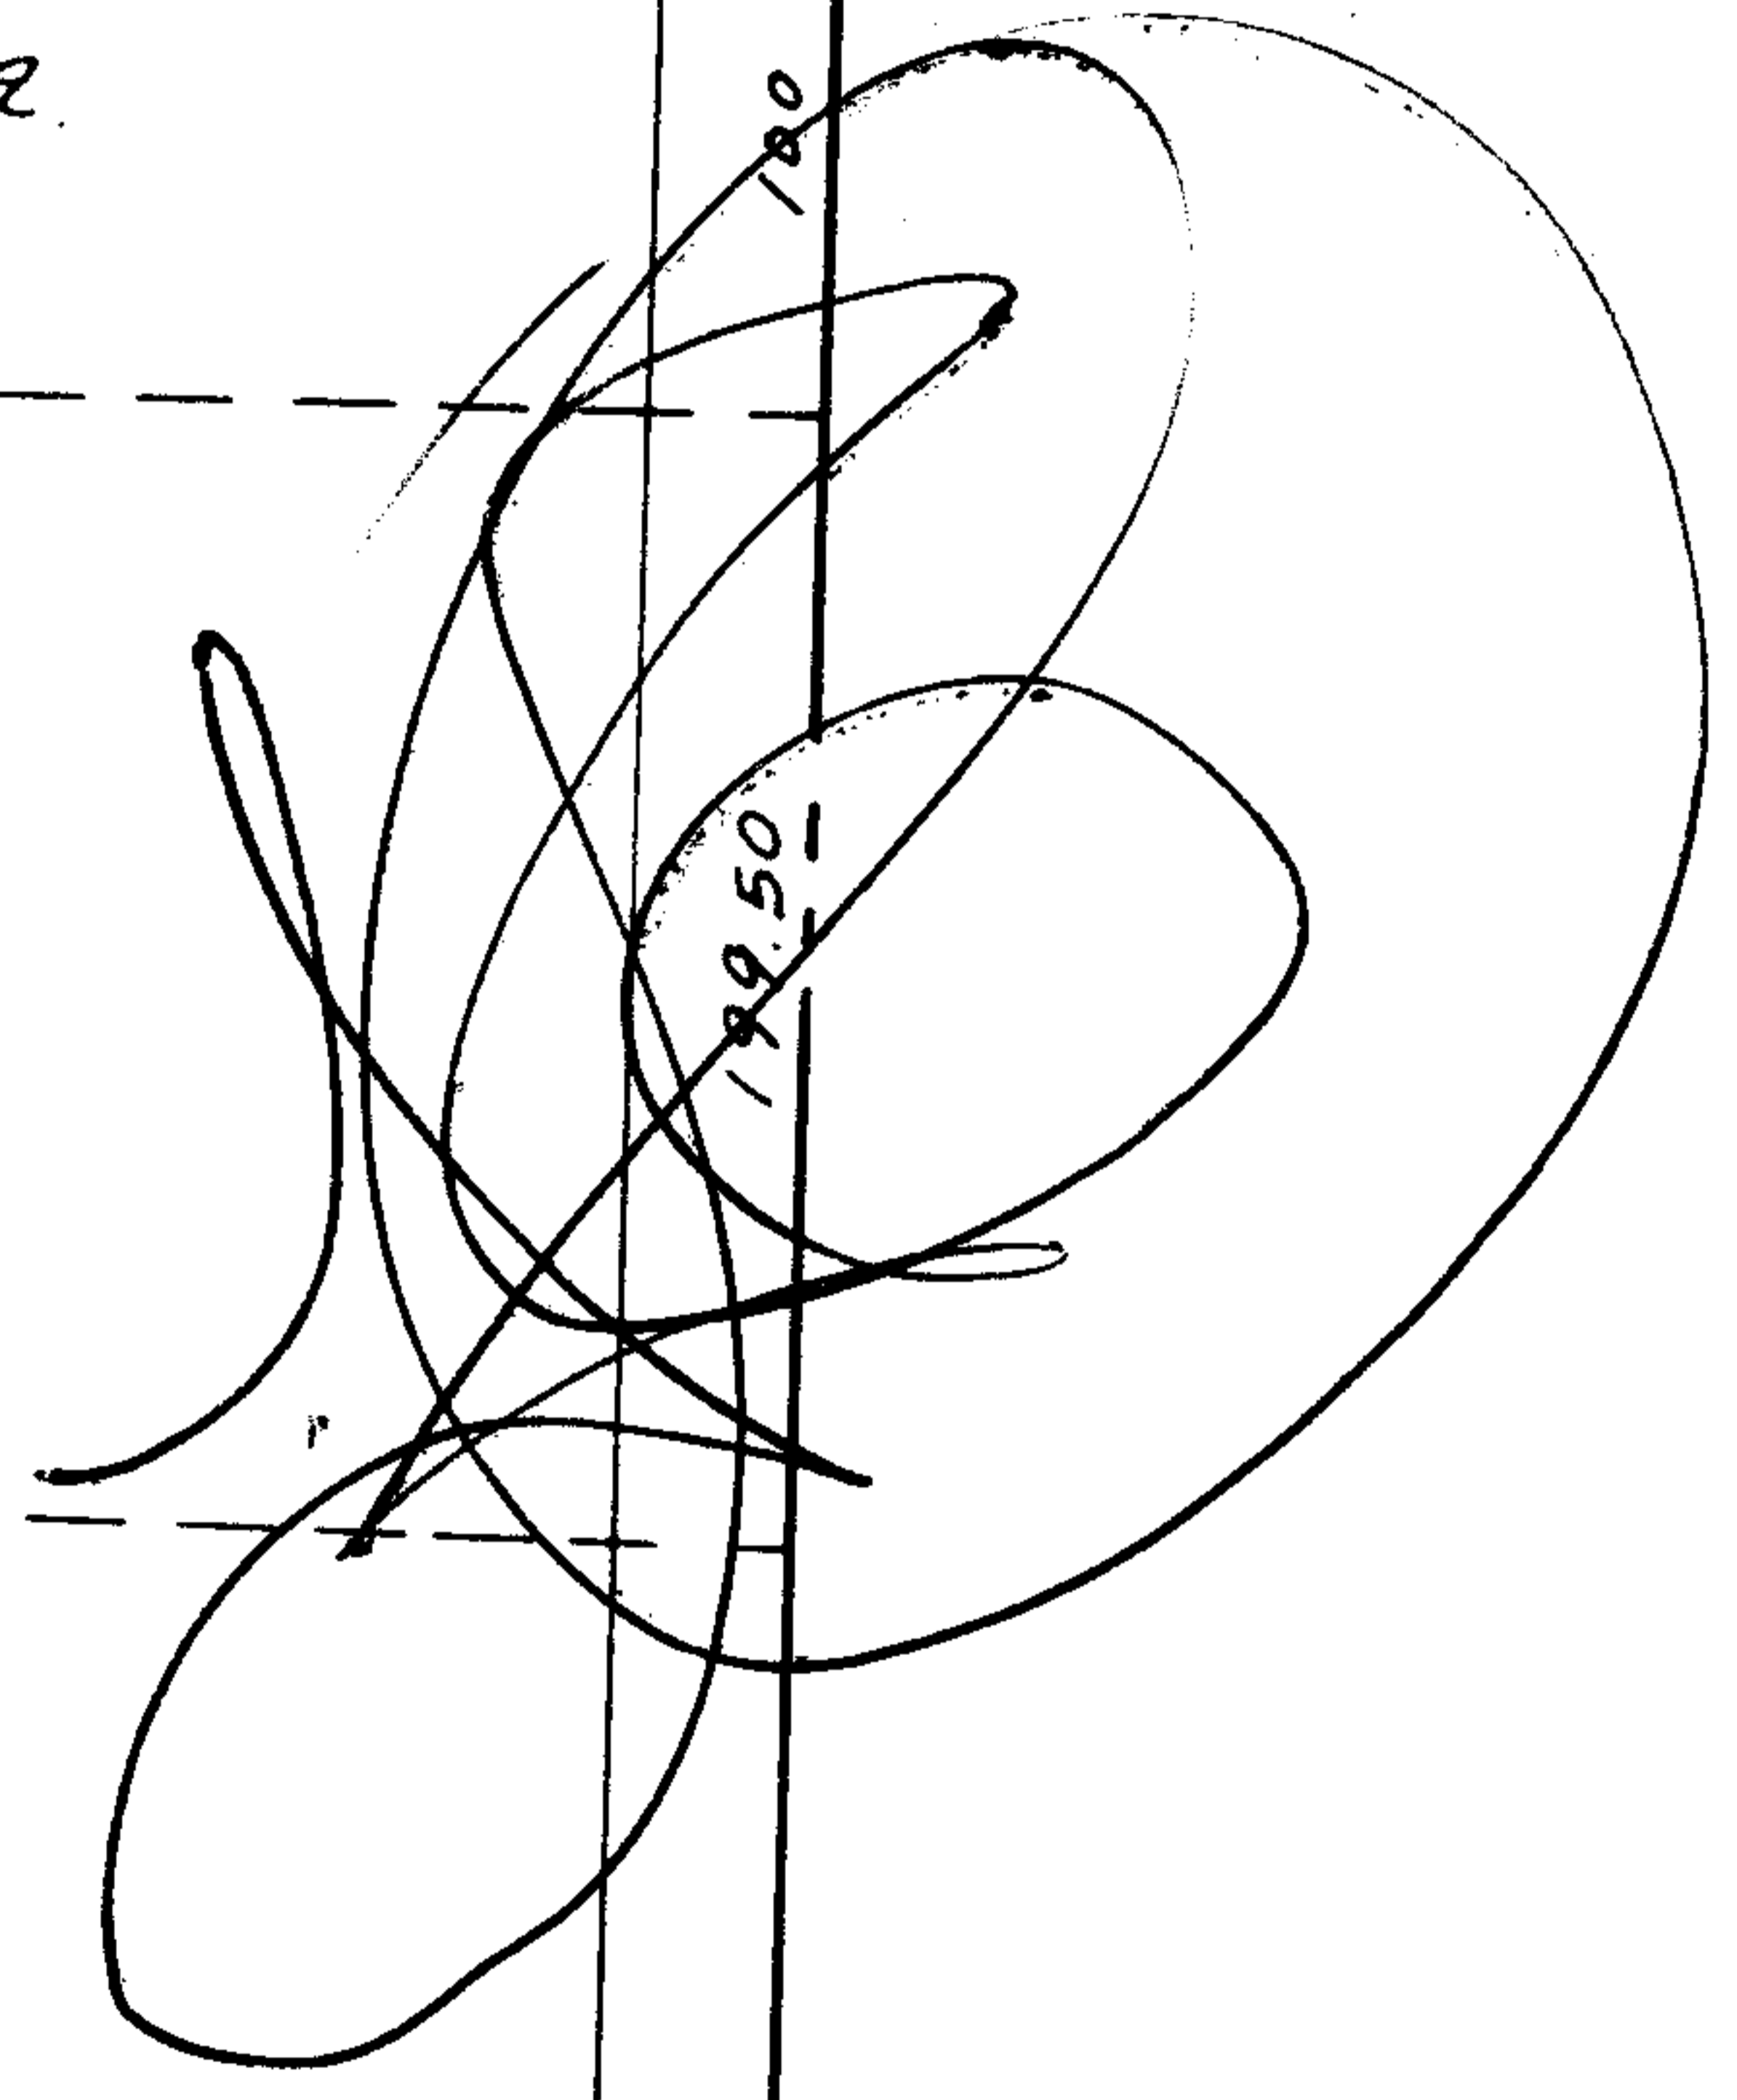

7328