


7330

E 3-H

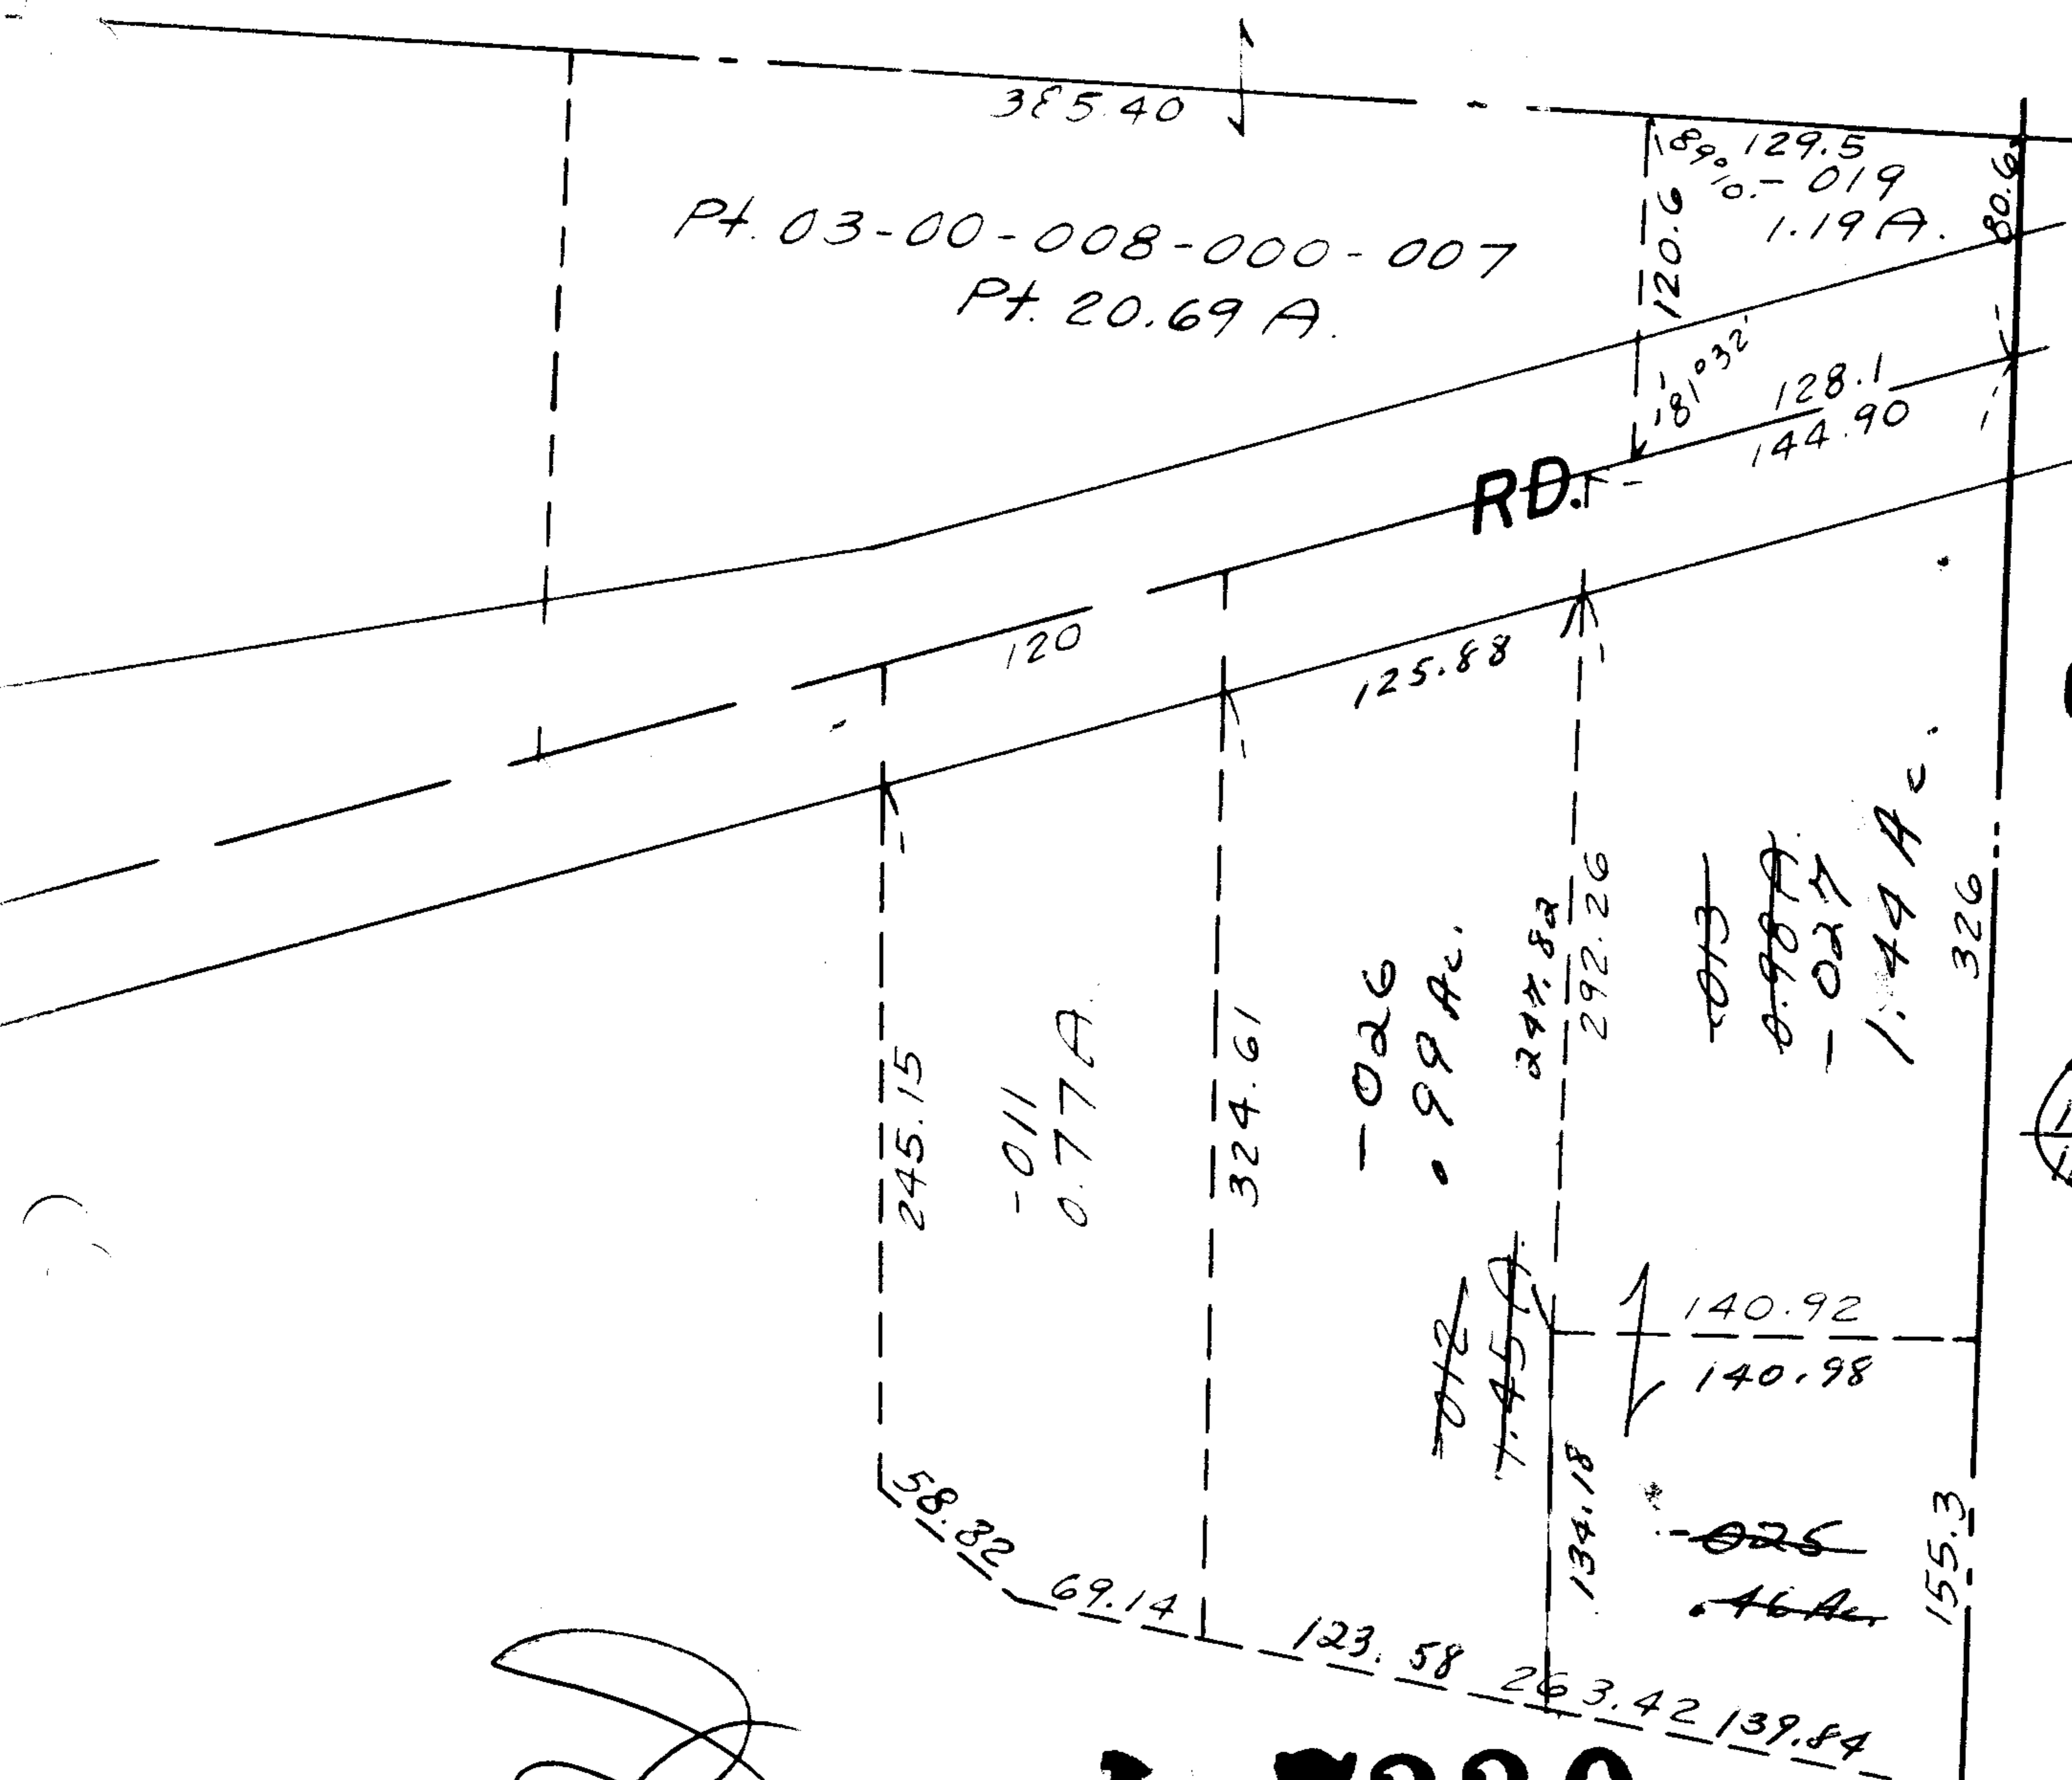

OK

~~263.42~~  
~~139.84~~  
~~123.58~~  
~~1.45~~  
~~46~~  
~~99~~

*[Handwritten signature]*

7330

APPROVED
LORAIN CO.
MAP. DEPT.
DATE 8-24-23
3-00-007-B
BY <i>[Signature]</i>

S. S. S-5-5