


OK

S/L 353

7-24-86 k.l.

7365
APPROVED
LORAIN CO
MAP DEPT.
DATE 9-7-73
 4-00-019B
BY L.W. Hall

[Handwritten signature]

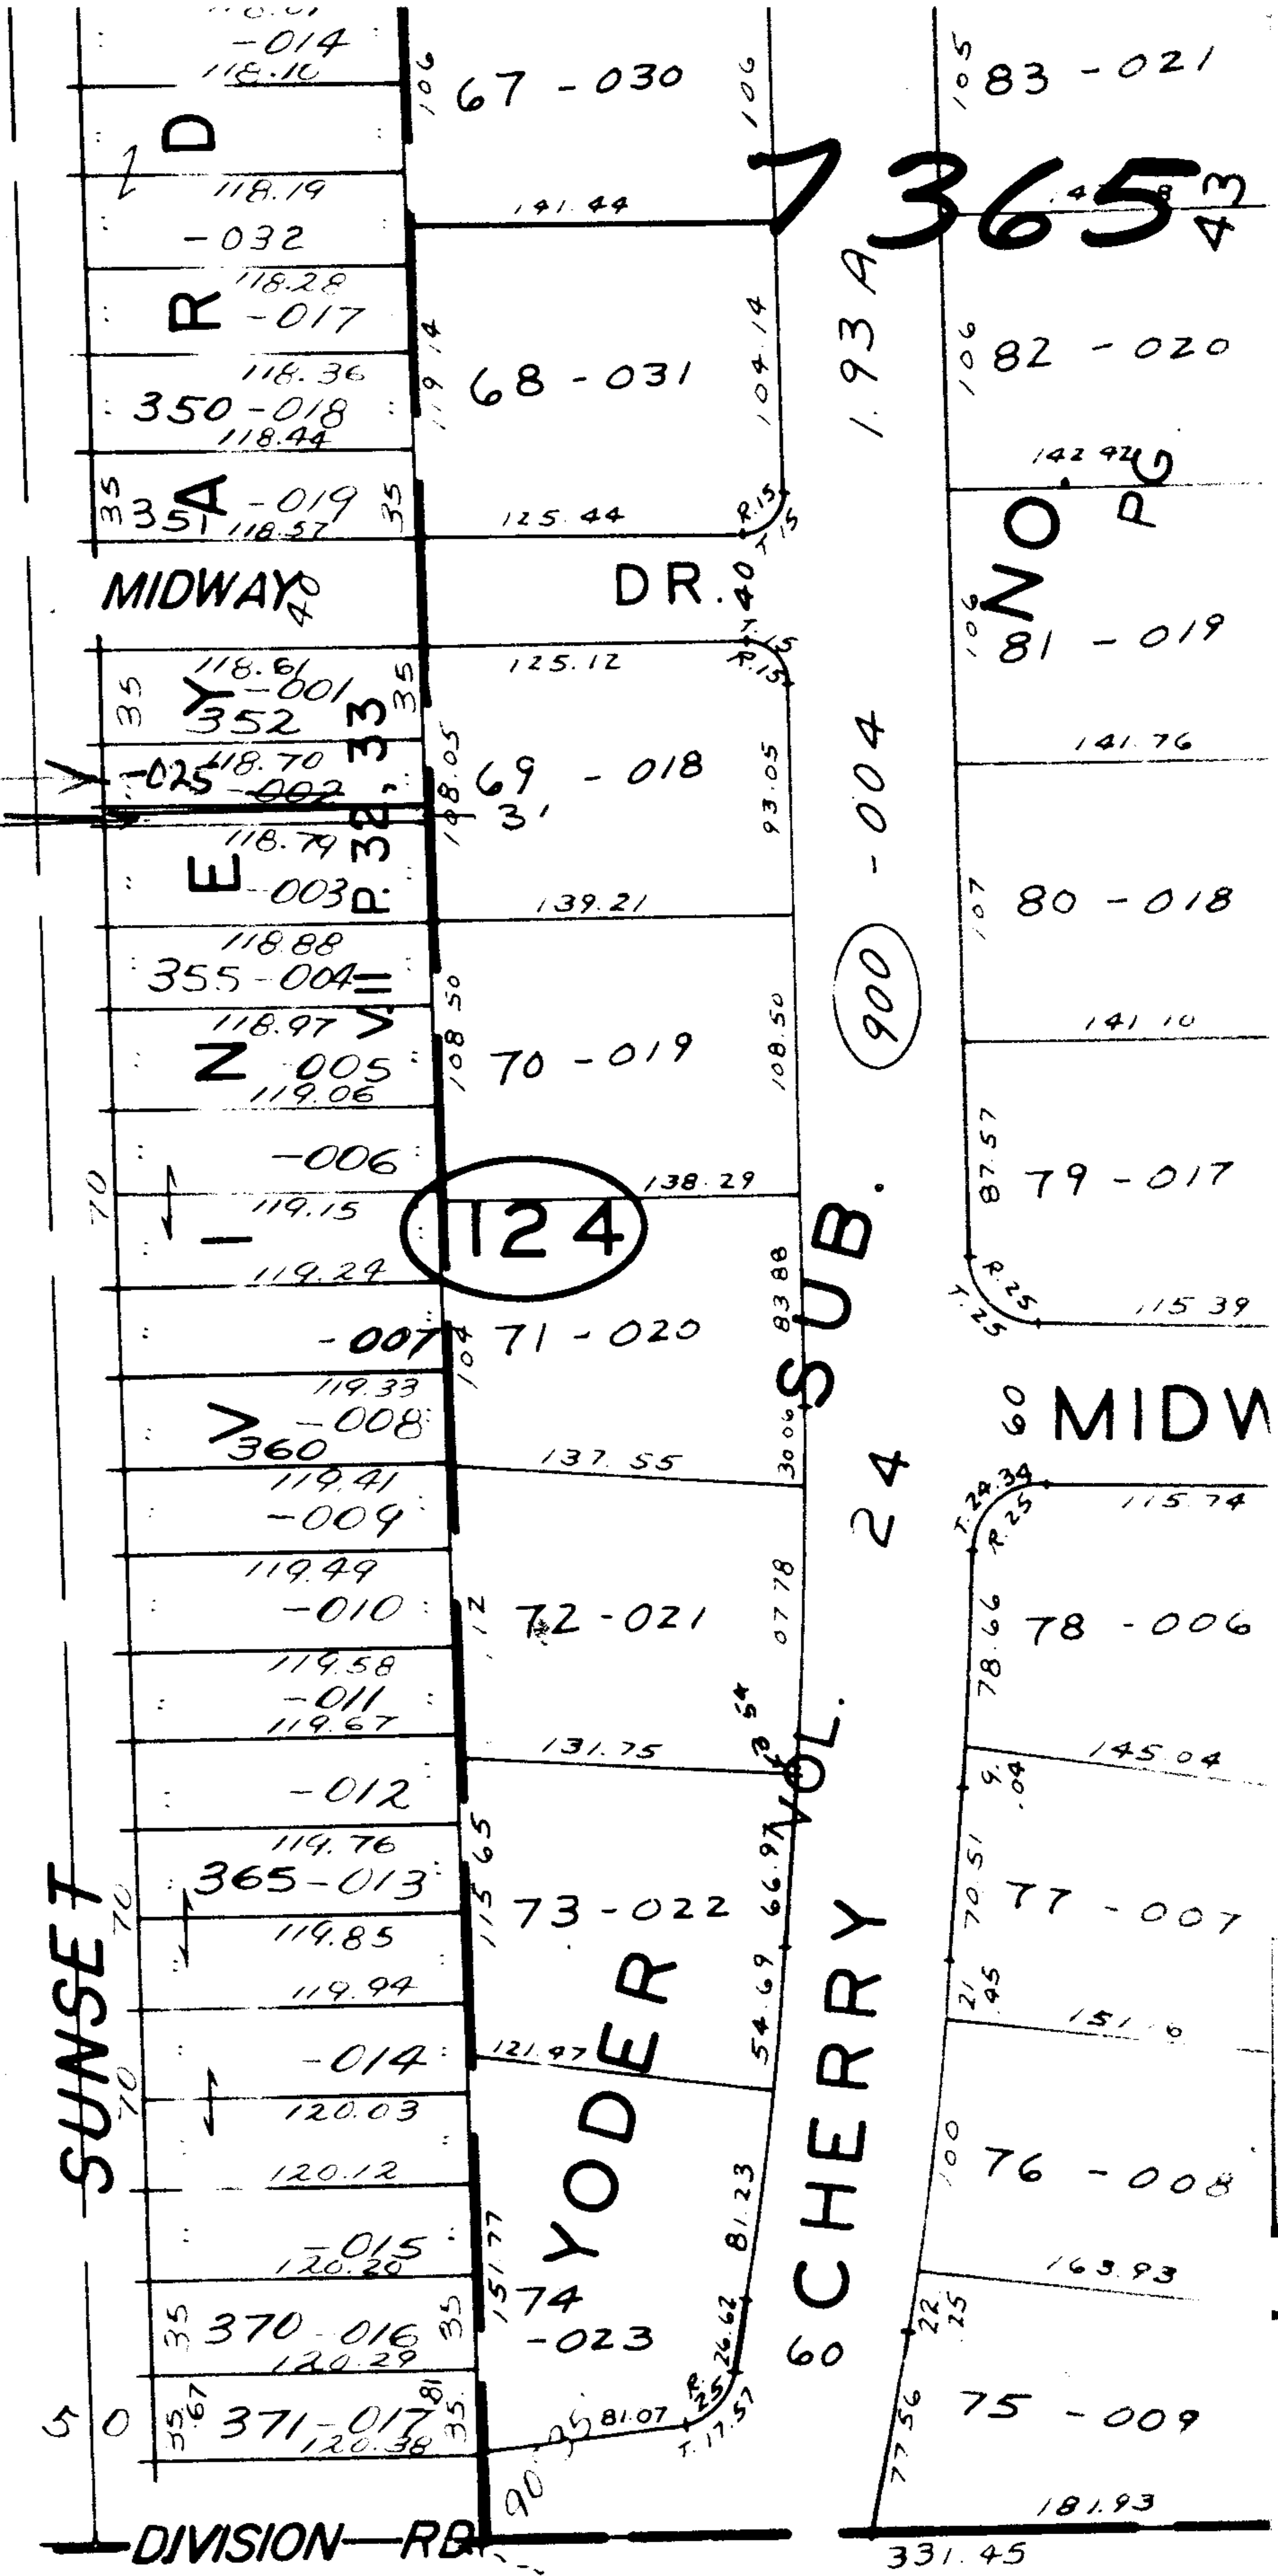

365

124

900

SUNSET

DIVISION RD.

YODER

60 CHERRY VOL. 24

SUB. 900-004

1.93 A