


7376
SEE 11-C

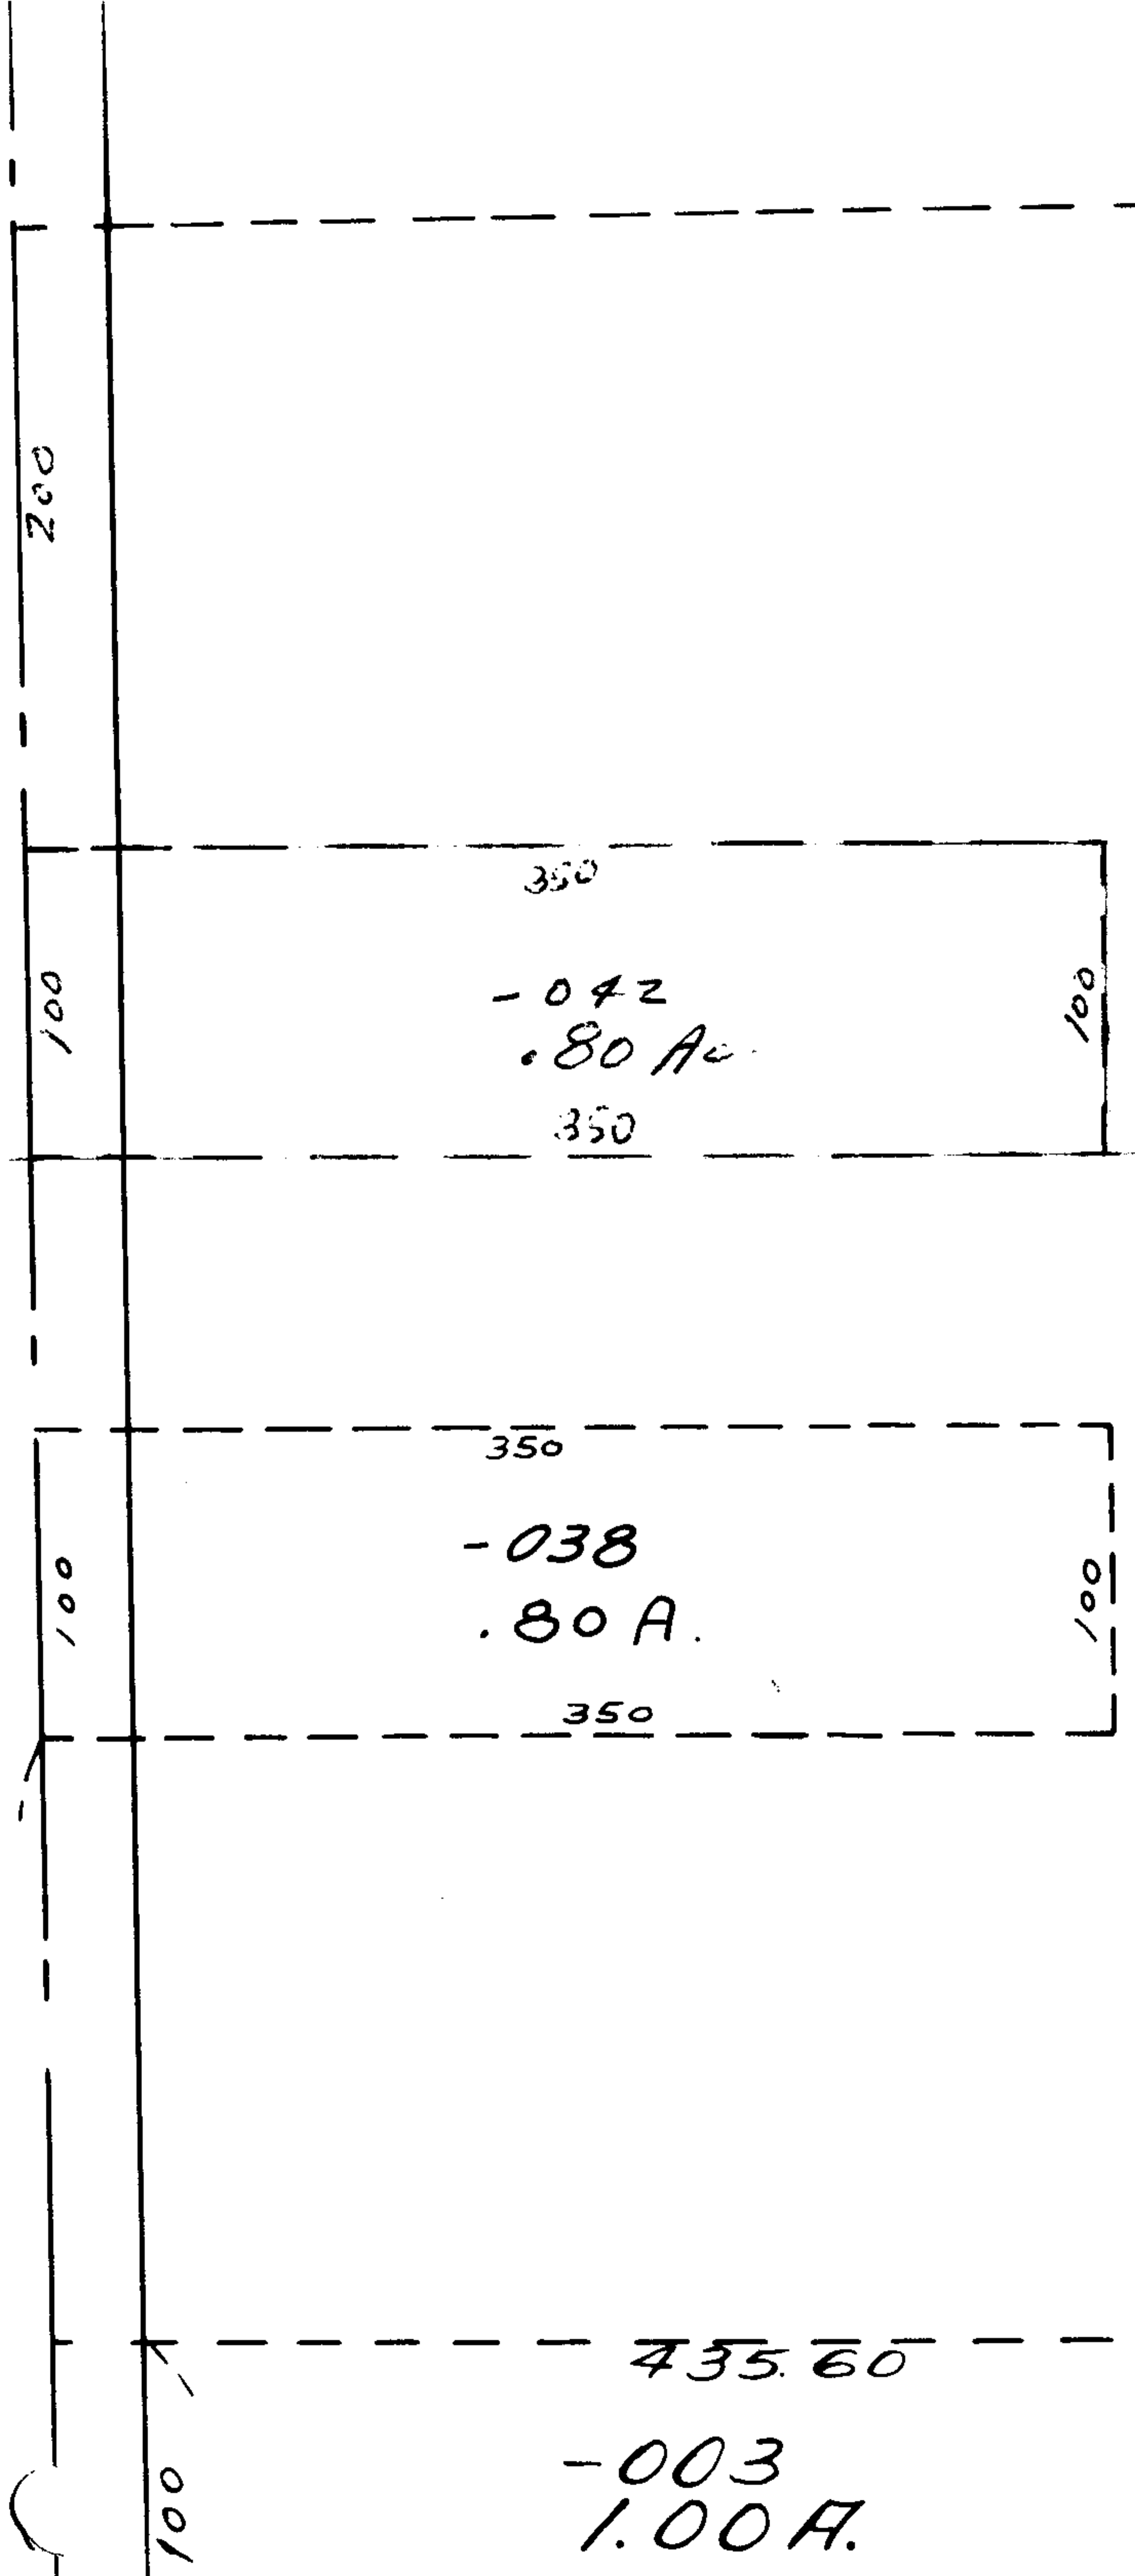

7376
 APPROVED
 LORAIN CO.
 MAP DEPT.
 DATE 9-10-73
 11-00-028-A+B
 BY *[Signature]*

88-5-8

[Handwritten scribbles]

Paul →

Pt. -043
 Pt. ~~-039~~
 44.20 A.
 43.40 A.

OK

106.01	100				
--------	-----	--	--	--	--