

~~020~~

~~5493Ac~~

03-00-019-000-019


22.03 Ac Remainder ↑

7385

~~001~~

~~62.90A.~~

1157.87

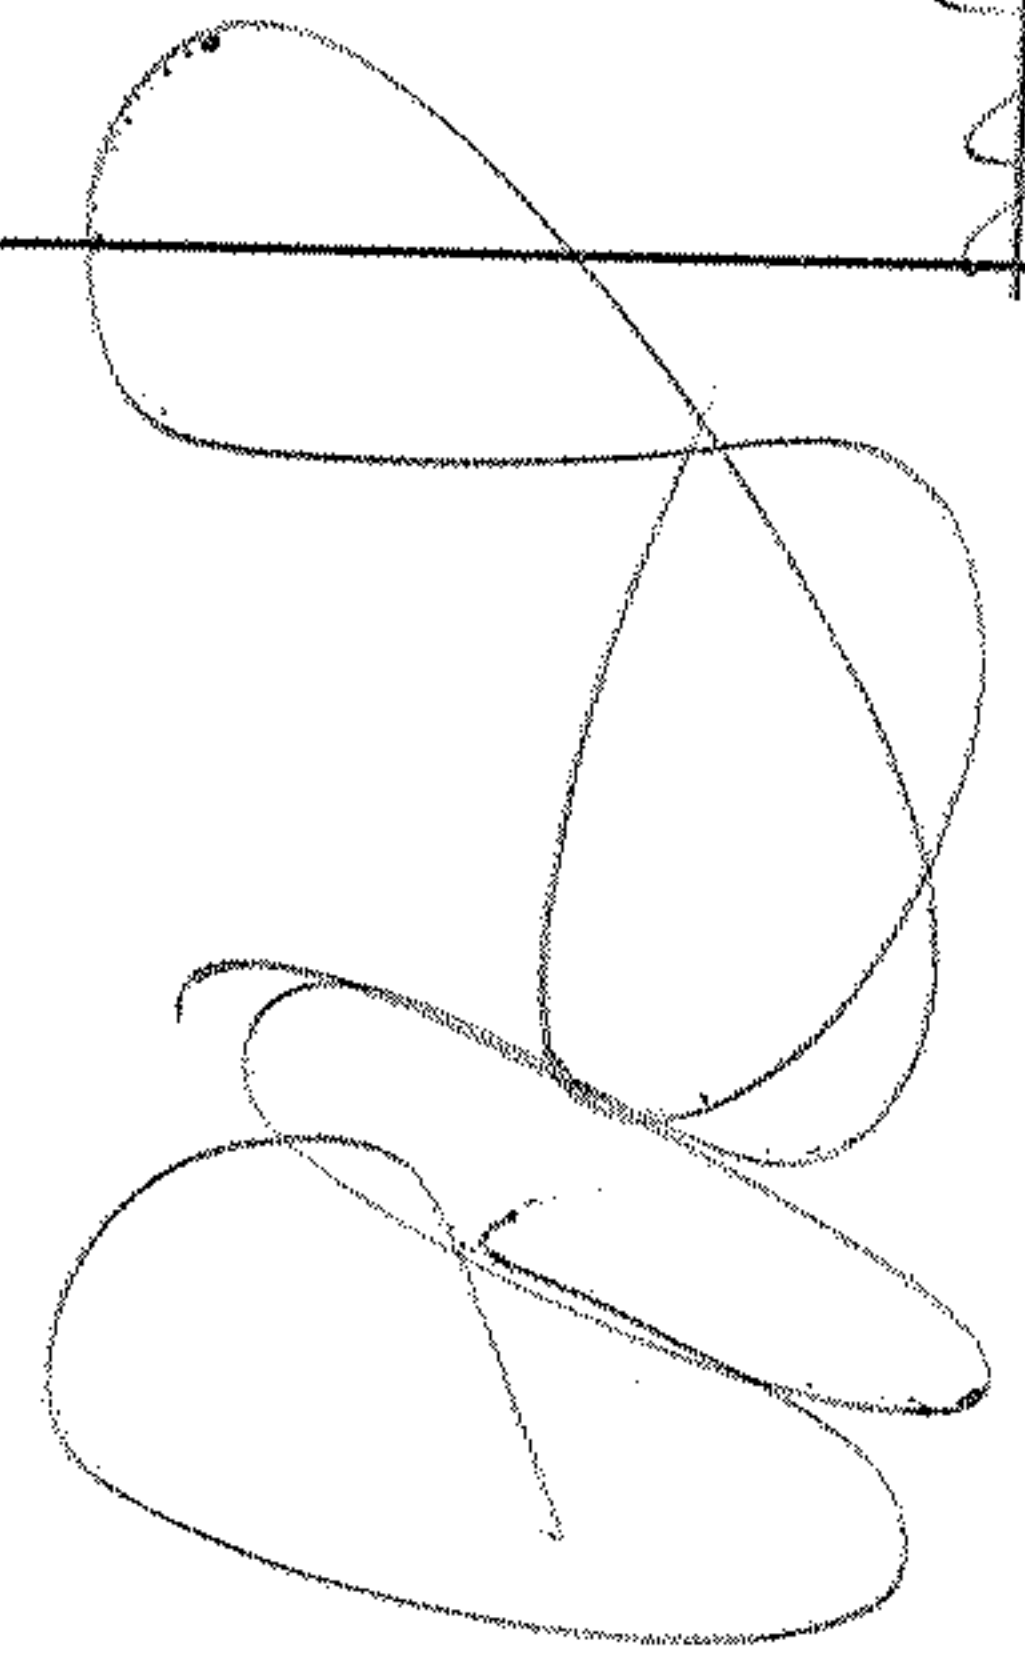

03-00-019-500-001

7.97Ac

OK

1156.95

300

300.05

N. Y. C.

(500)

Pt. 03-00-024-500-001

Pt. 7.752A.

R. R. ↑

03-00-019-500-002

32.90Ac

~~Pt 020~~

~~Pt 54.93Ac~~

see survey.

see Map

(2/2)

SEE 1385 3-00-019-B

12