


25.09  
24.12  
49.31  
7388

*OR*

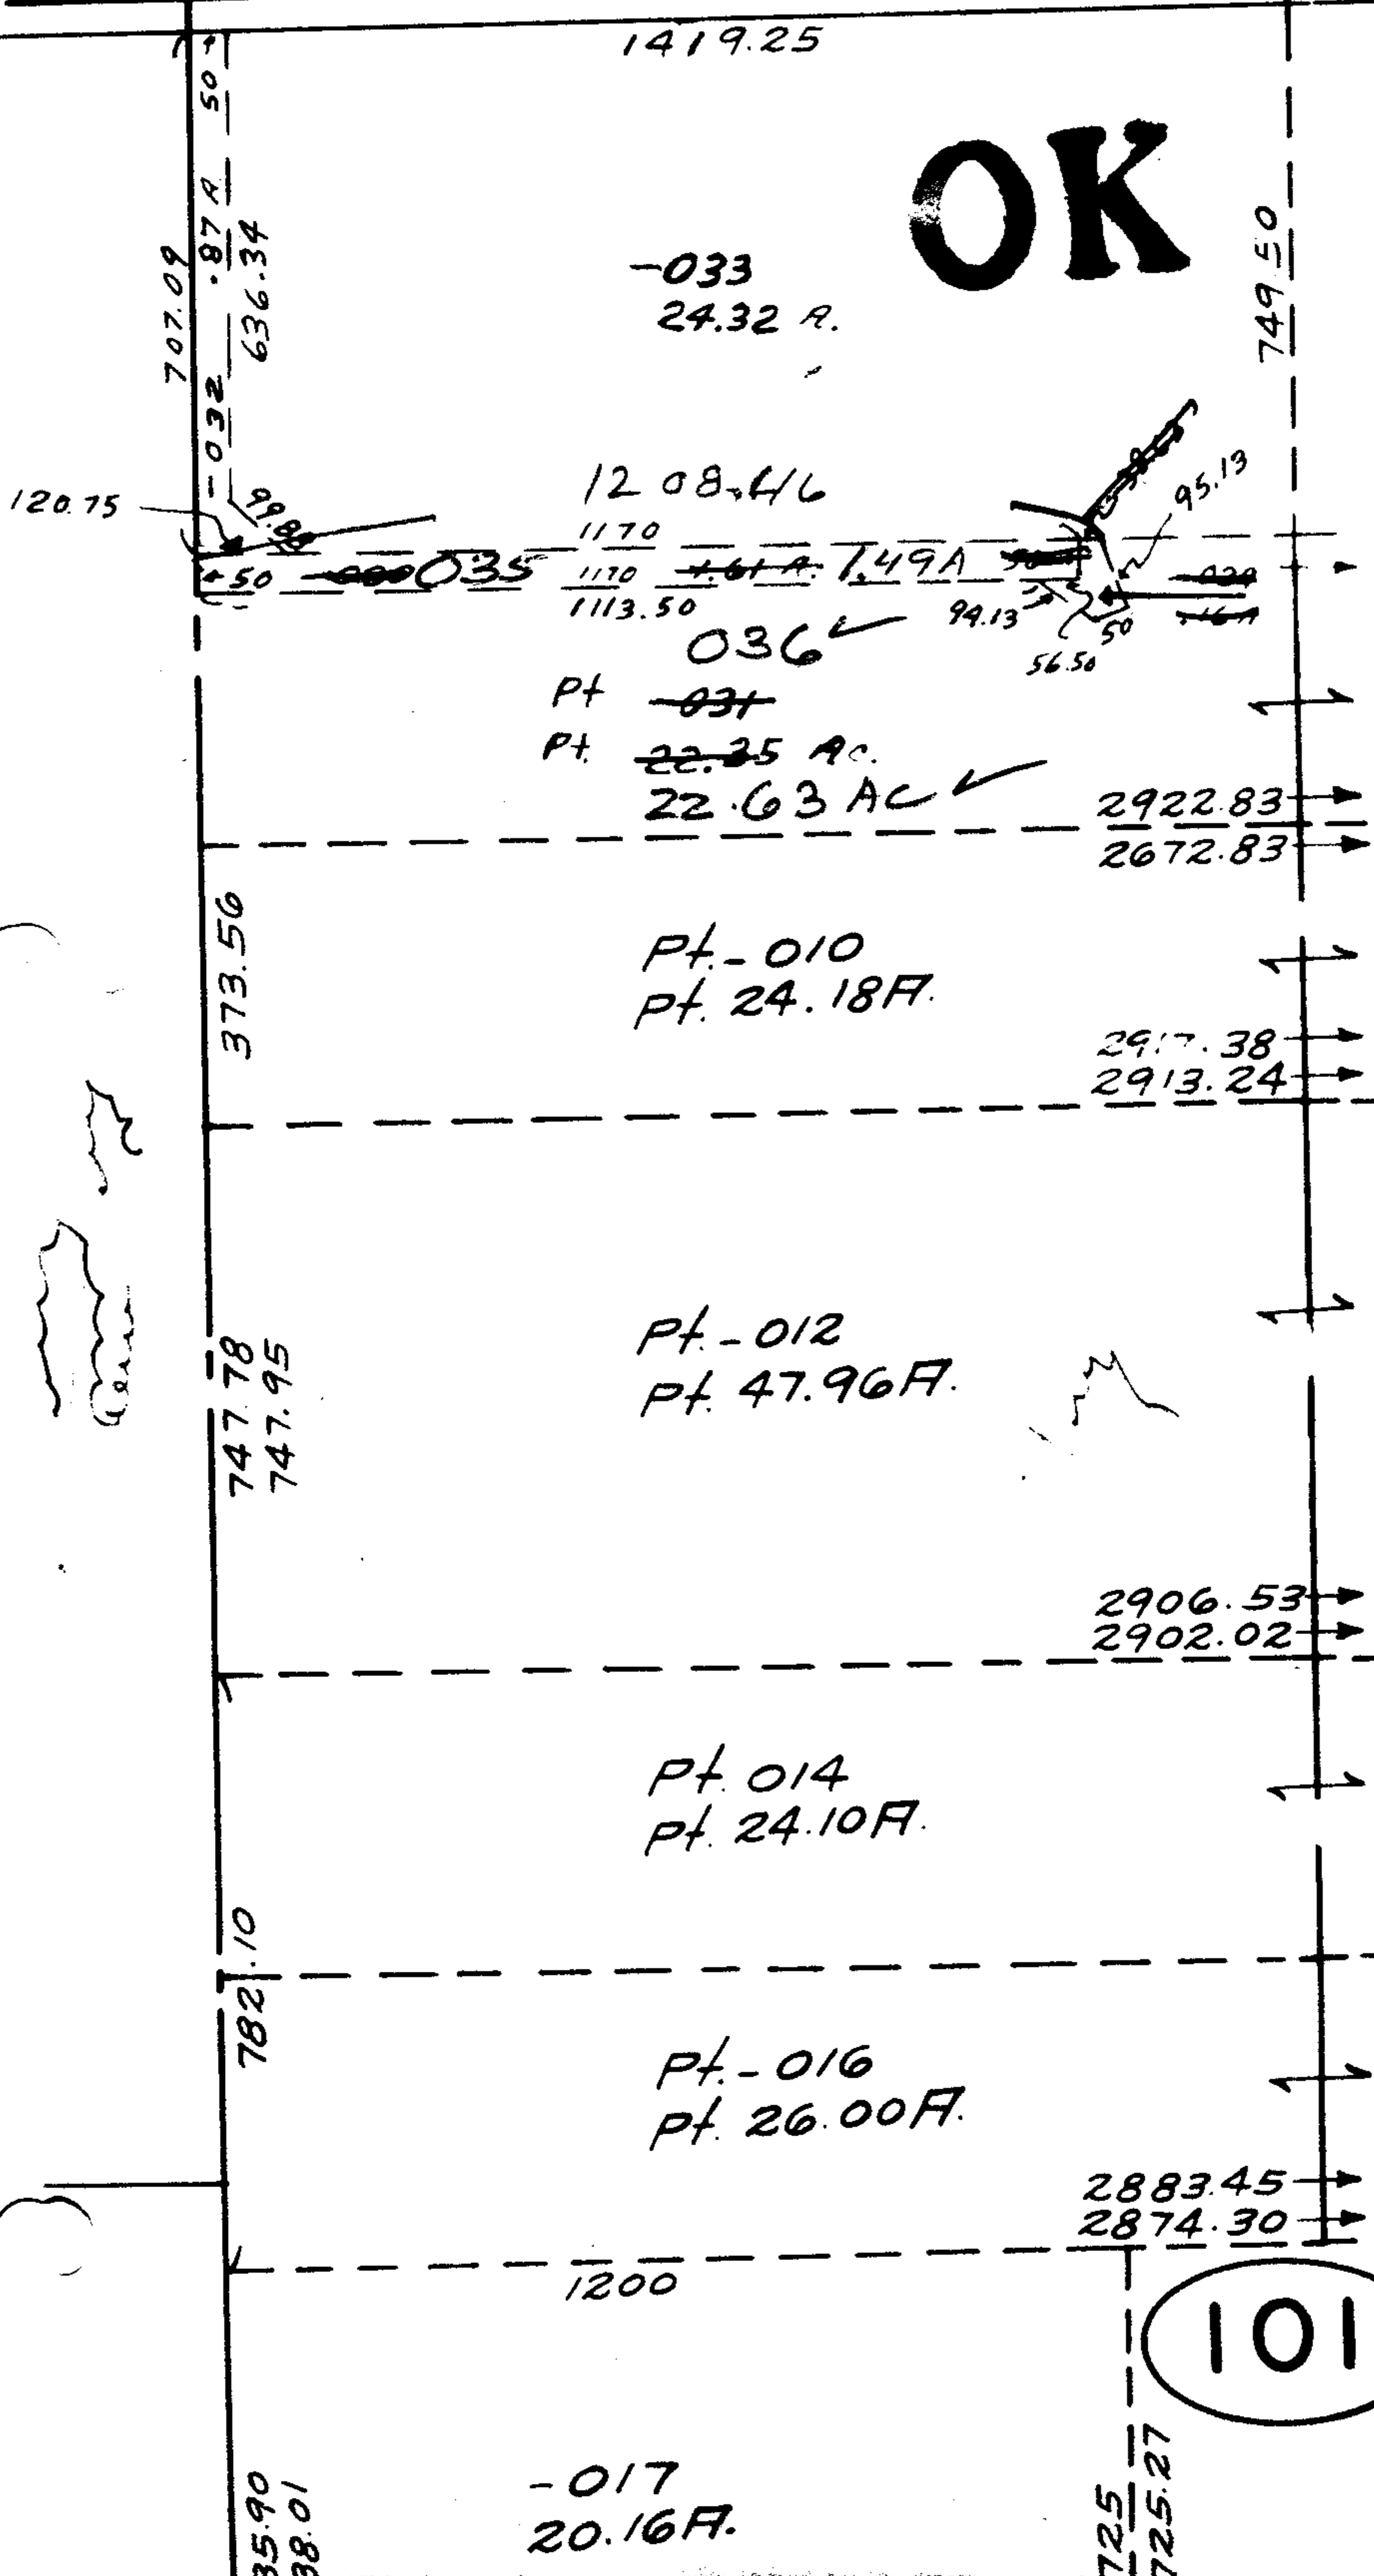

OK

See Also  
4-00-020B

7-29-86  
7388  
7-29-86  
7388  
4-00-020-B

APPROVED	
LORAIN CO. MAP DEPT.	
DATE	10-2-73
PAGE	4-C 4-00-020B
BY	L. Hall
VOID AFTER	

SEE SURVEY  
SEE MAP # 7022  
20

216	121	374
154	1.77A	-027
154	346	346
154	118	118
216	273.66	216