

SEE 3-00-007-A

2201





JK

7391


APPROVED  
 LORAIN CO.  
 MAP DEPT.  
 DATE 9-14-78  
 3-00-007B  
 BY L. W. Hall

~~-024~~  
14.97A

-029  
14.14AC

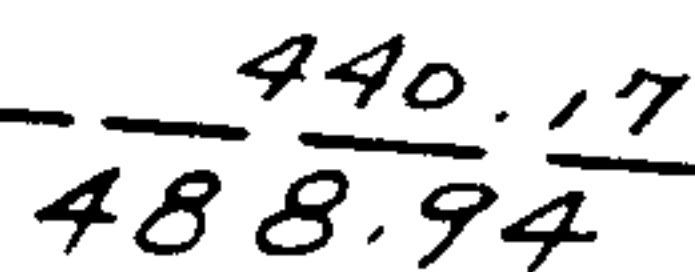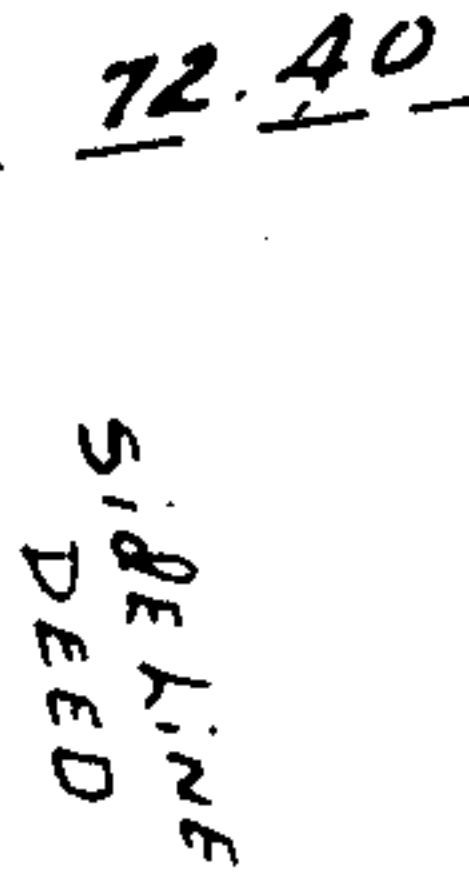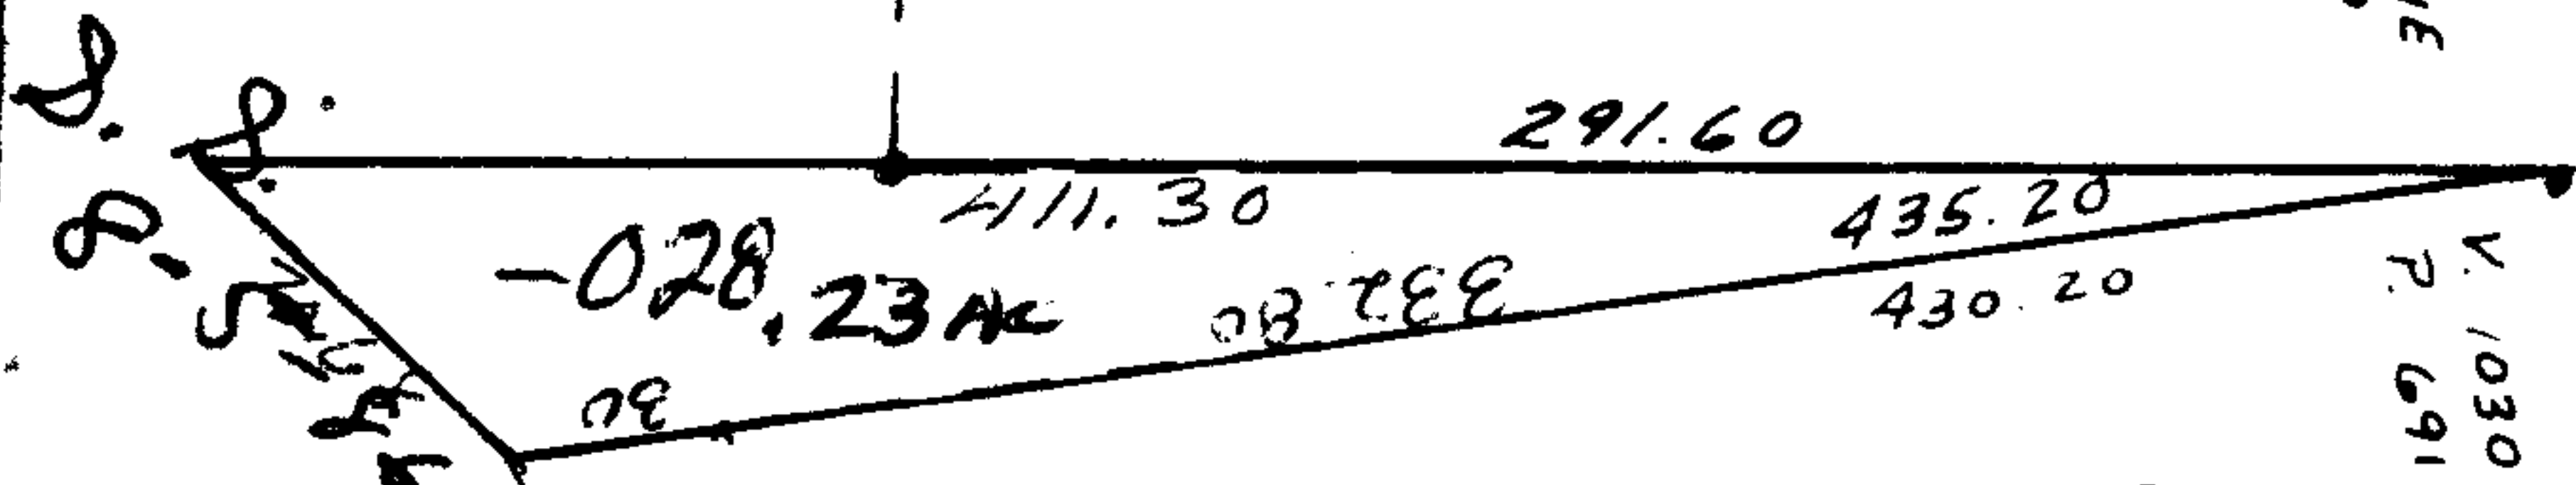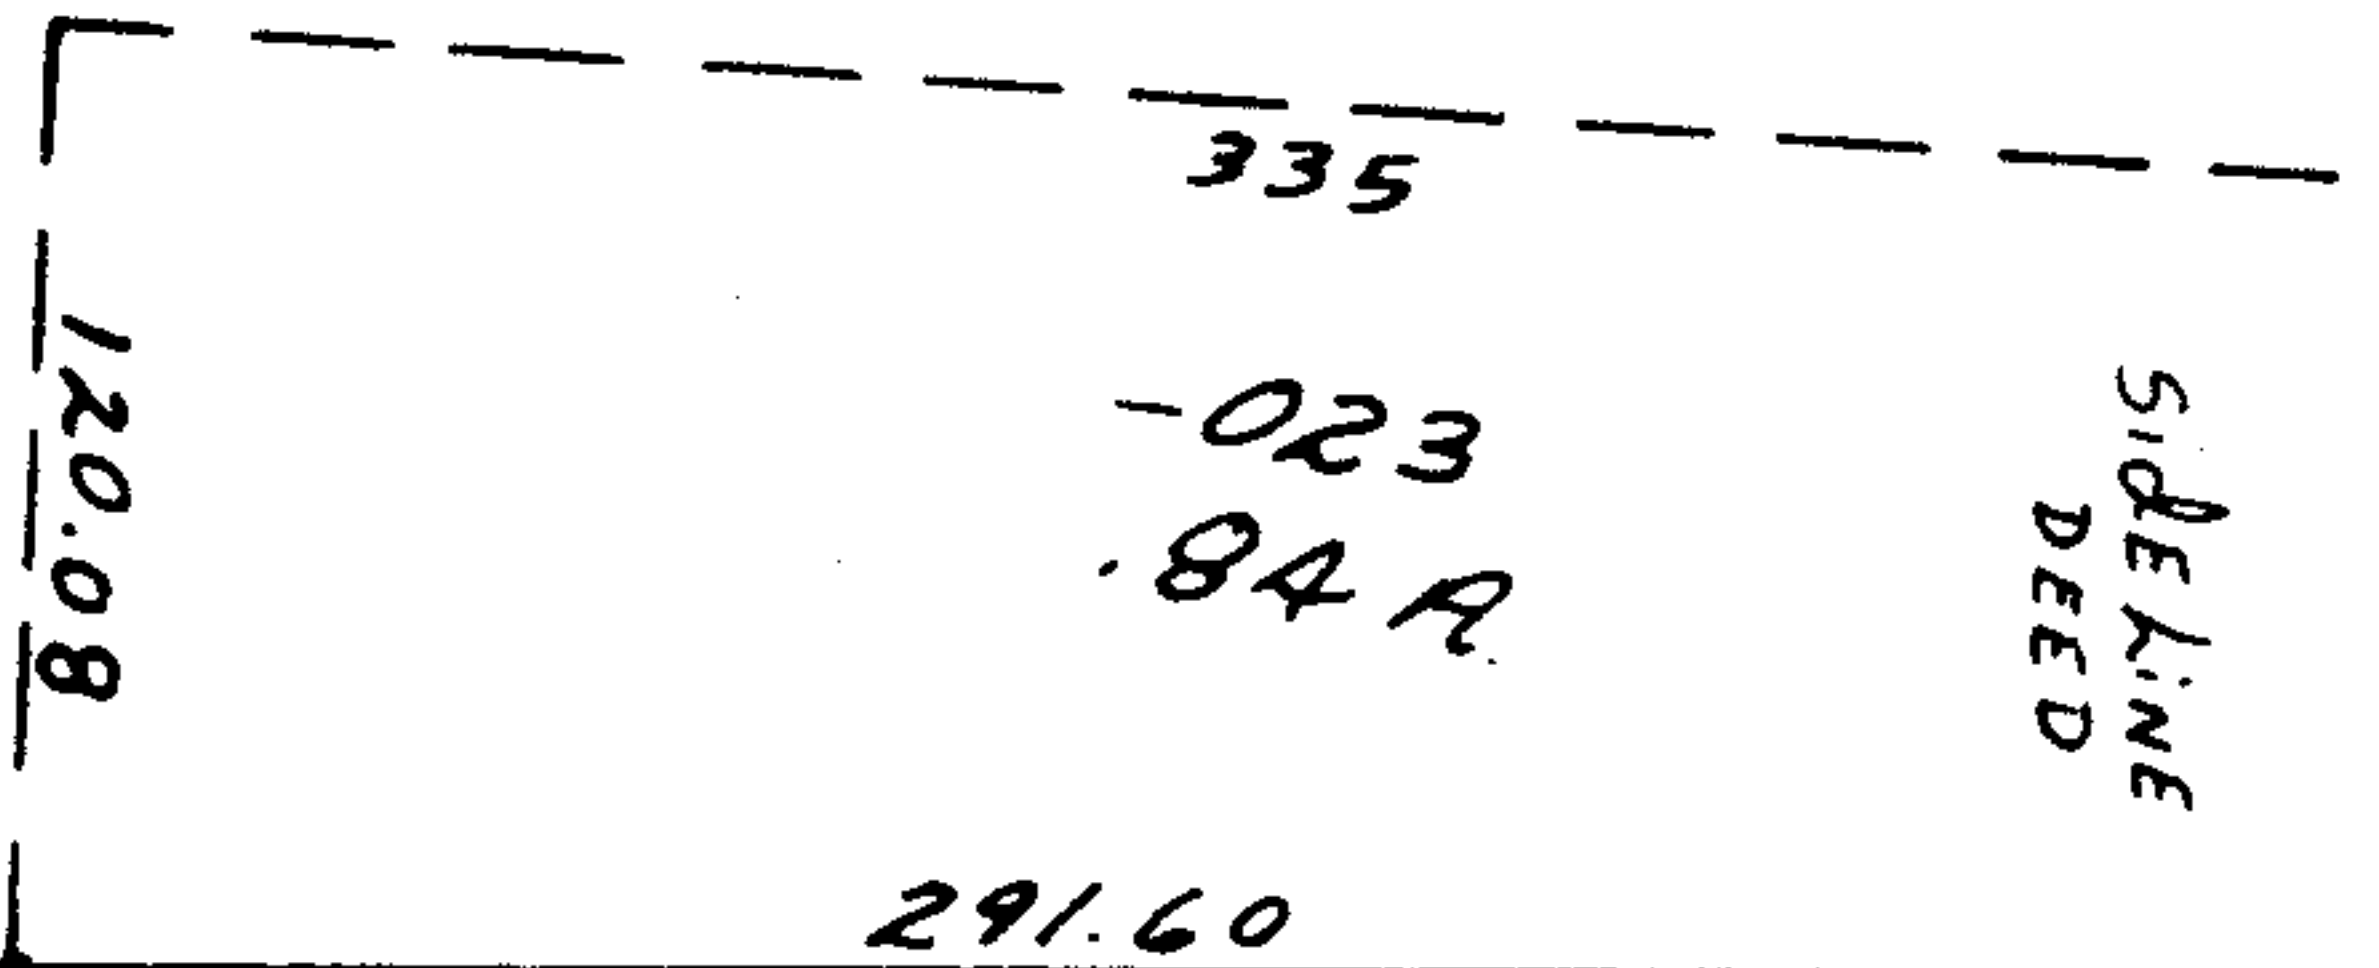

-009  
1.42A.

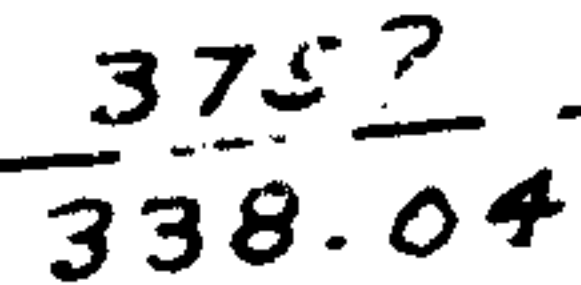

-017  
.85A.

RIDGEVILLE - LORAIN  
210.  
148.69  
109.67  
21.10

*[Handwritten signature]*

601