

7403

OK


OK

OK

OK

OK

[Handwritten signature]

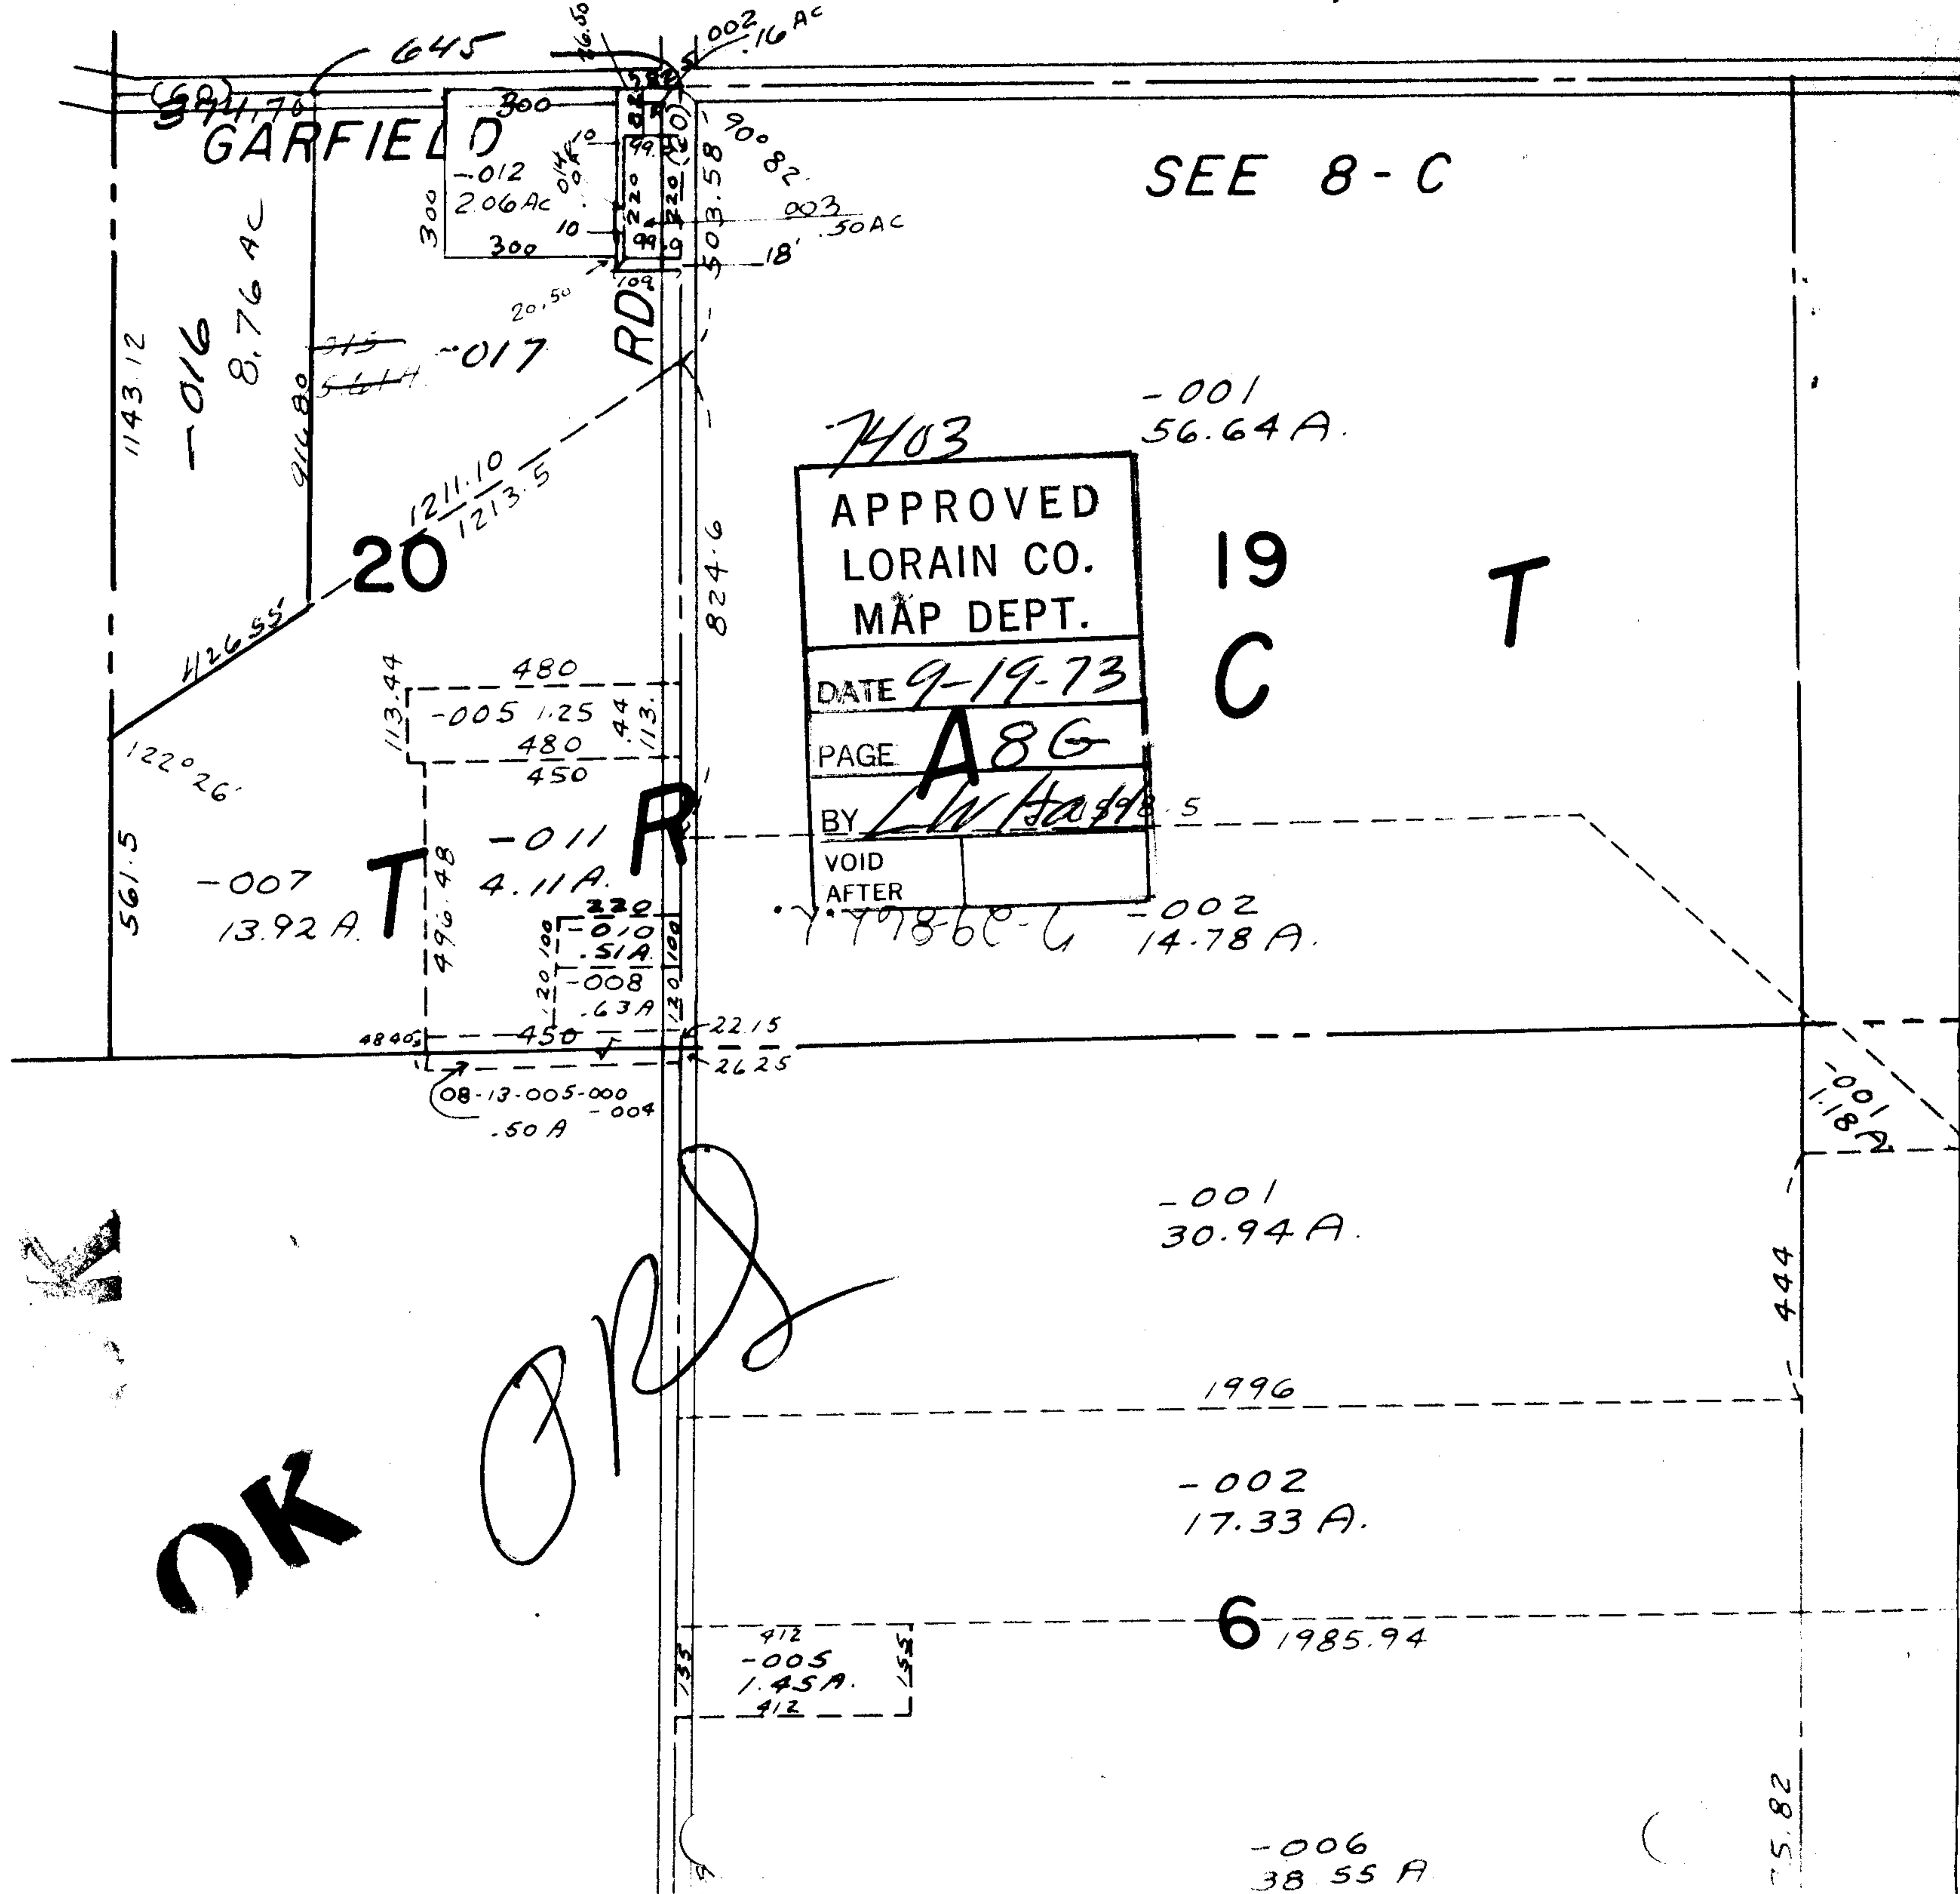

7403

APPROVED
LORAIN CO.
MAP DEPT.

DATE 9-19-73

PAGE A86

BY L.W. Hoadley

VOID
AFTER

SEE 8-C

19
C T

-001
56.64 A.

-007
13.92 A.

-011
4.11 A.

-005
1.25
480
450

-002
14.78 A.

-001
30.94 A.

-002
17.33 A.

6 1985.94

412
-005
1.45 A.
412

-006
38.55 A.

118.82