


7417
~~7317~~

OSTER

RD.

OK

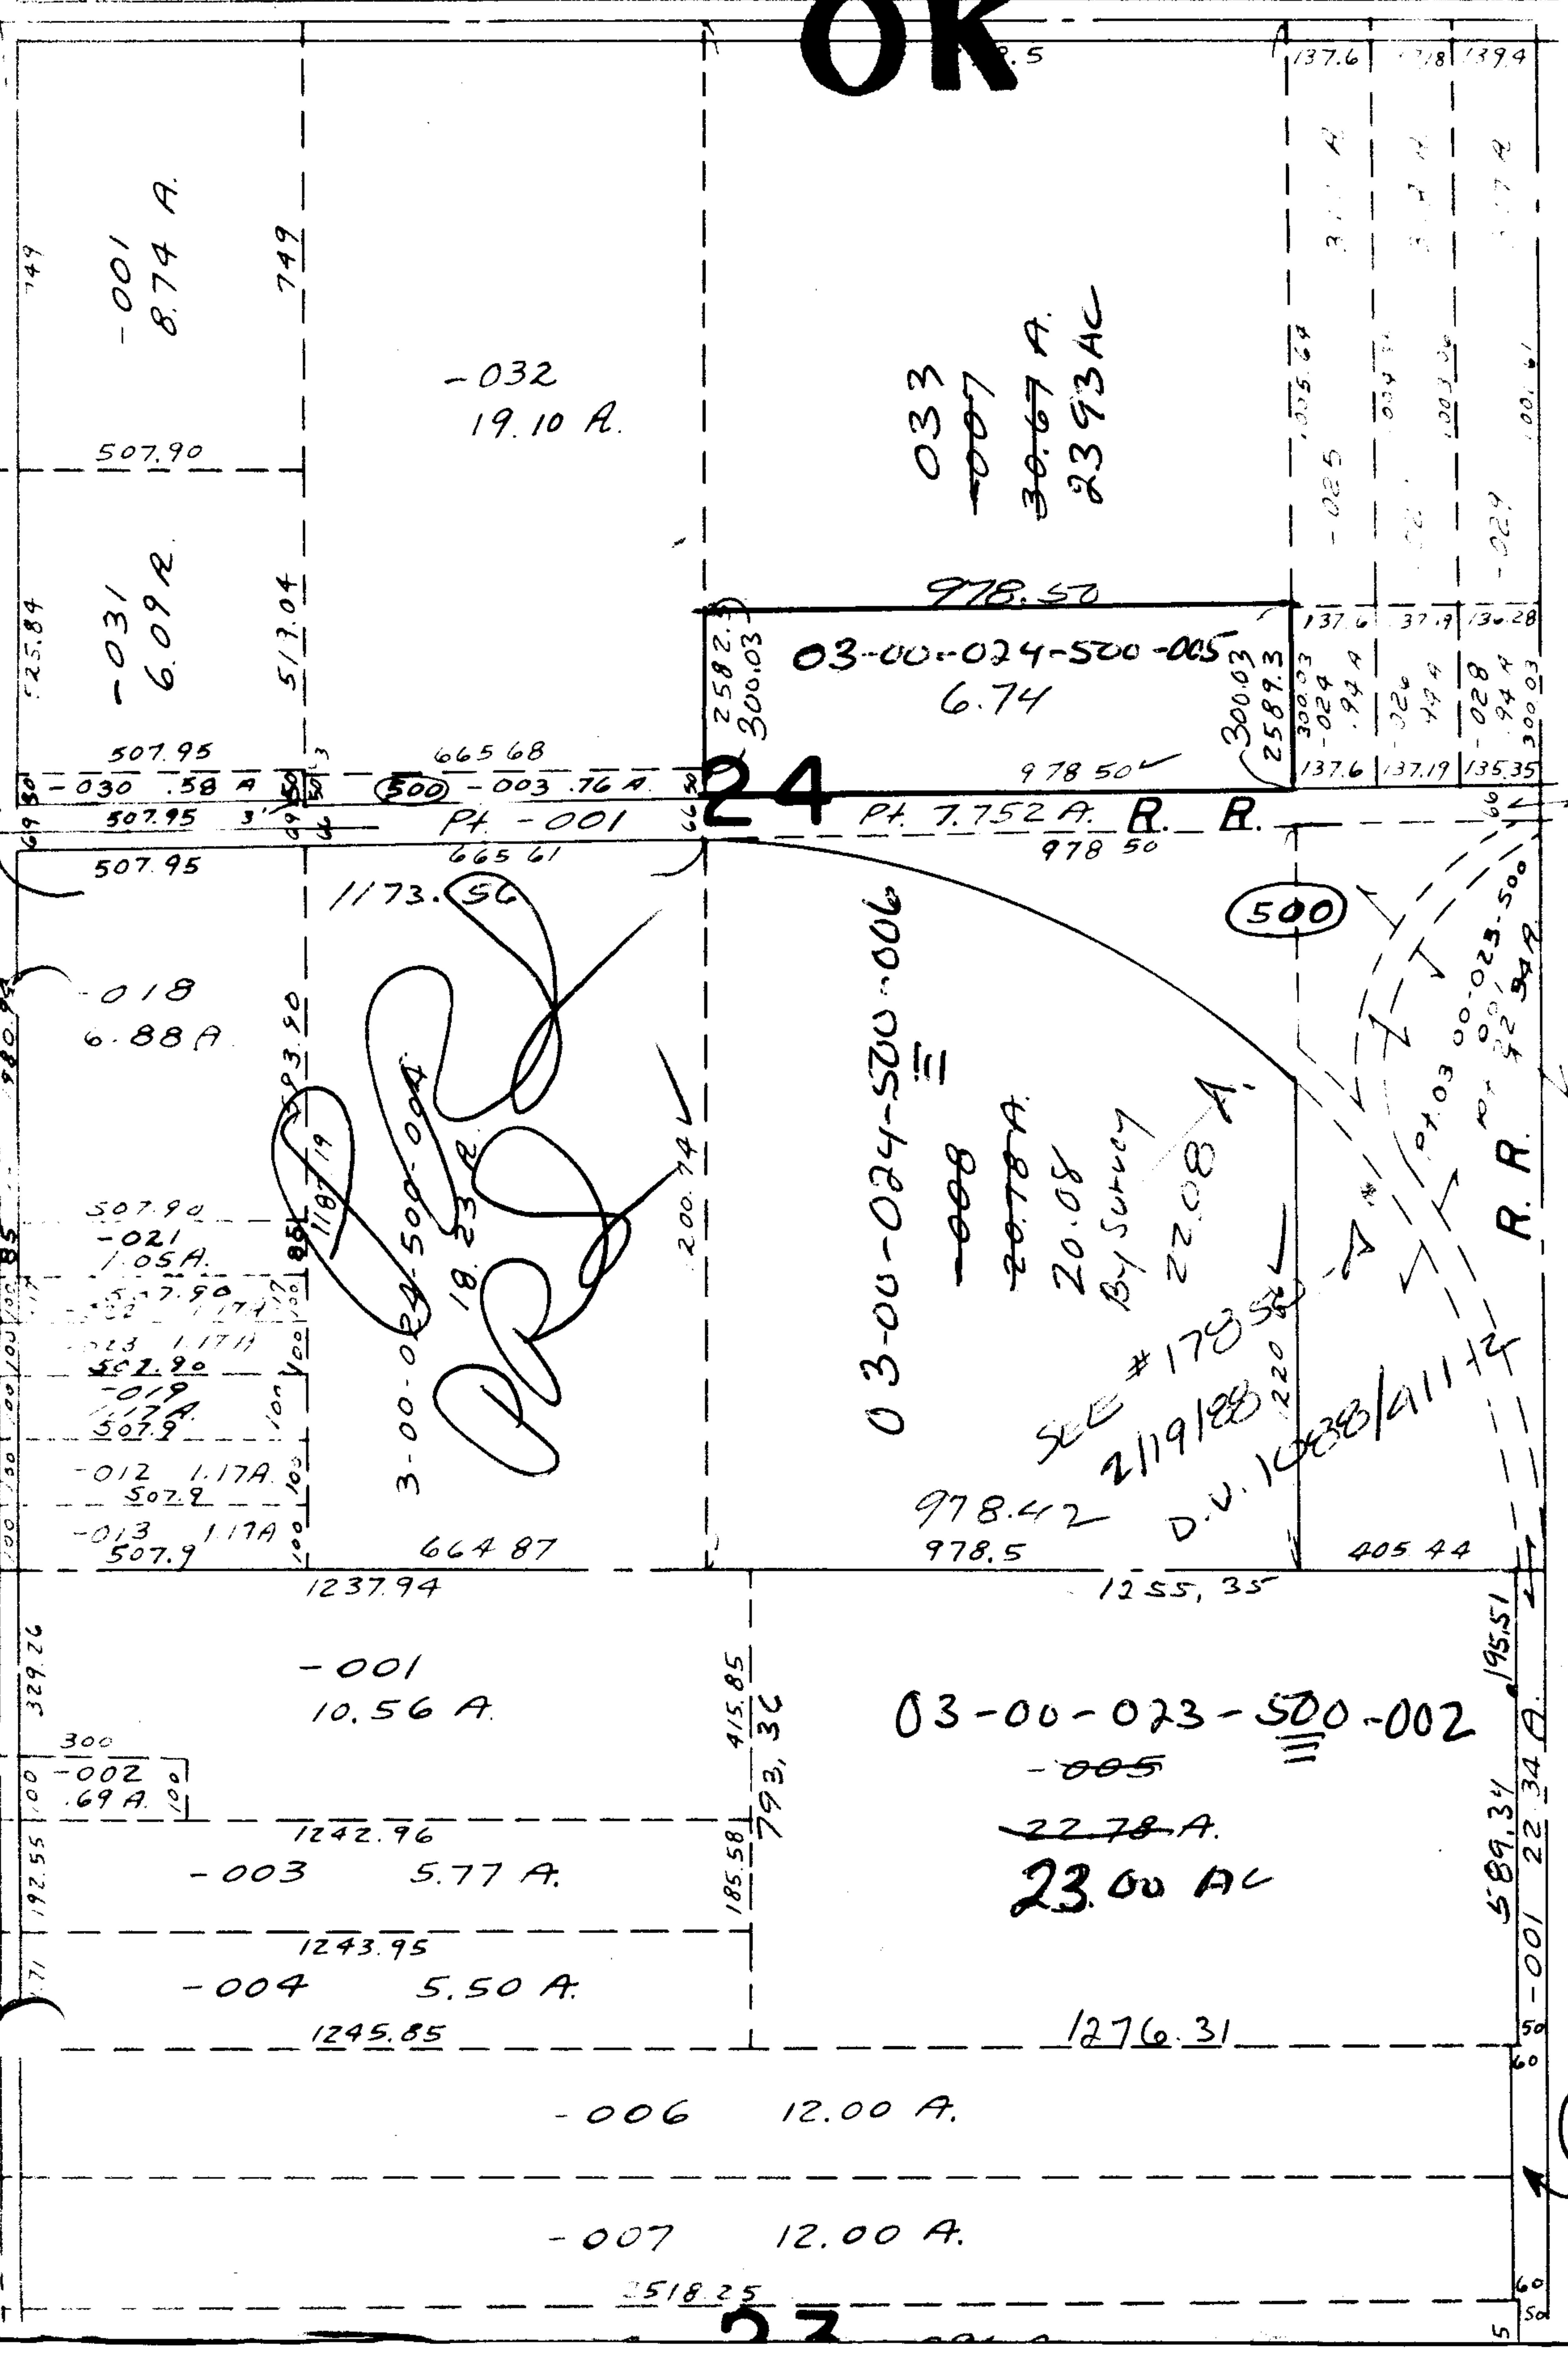

27.19
3.11
2.28

See Survey

74.17

APPROVED LORAIN CO. MAP DEPT.	
DATE 9-26-73	
PAGE 36	
BY L.H. Hall	
VOID AFTER	

B.D.
8-5-86

500

27