


7422

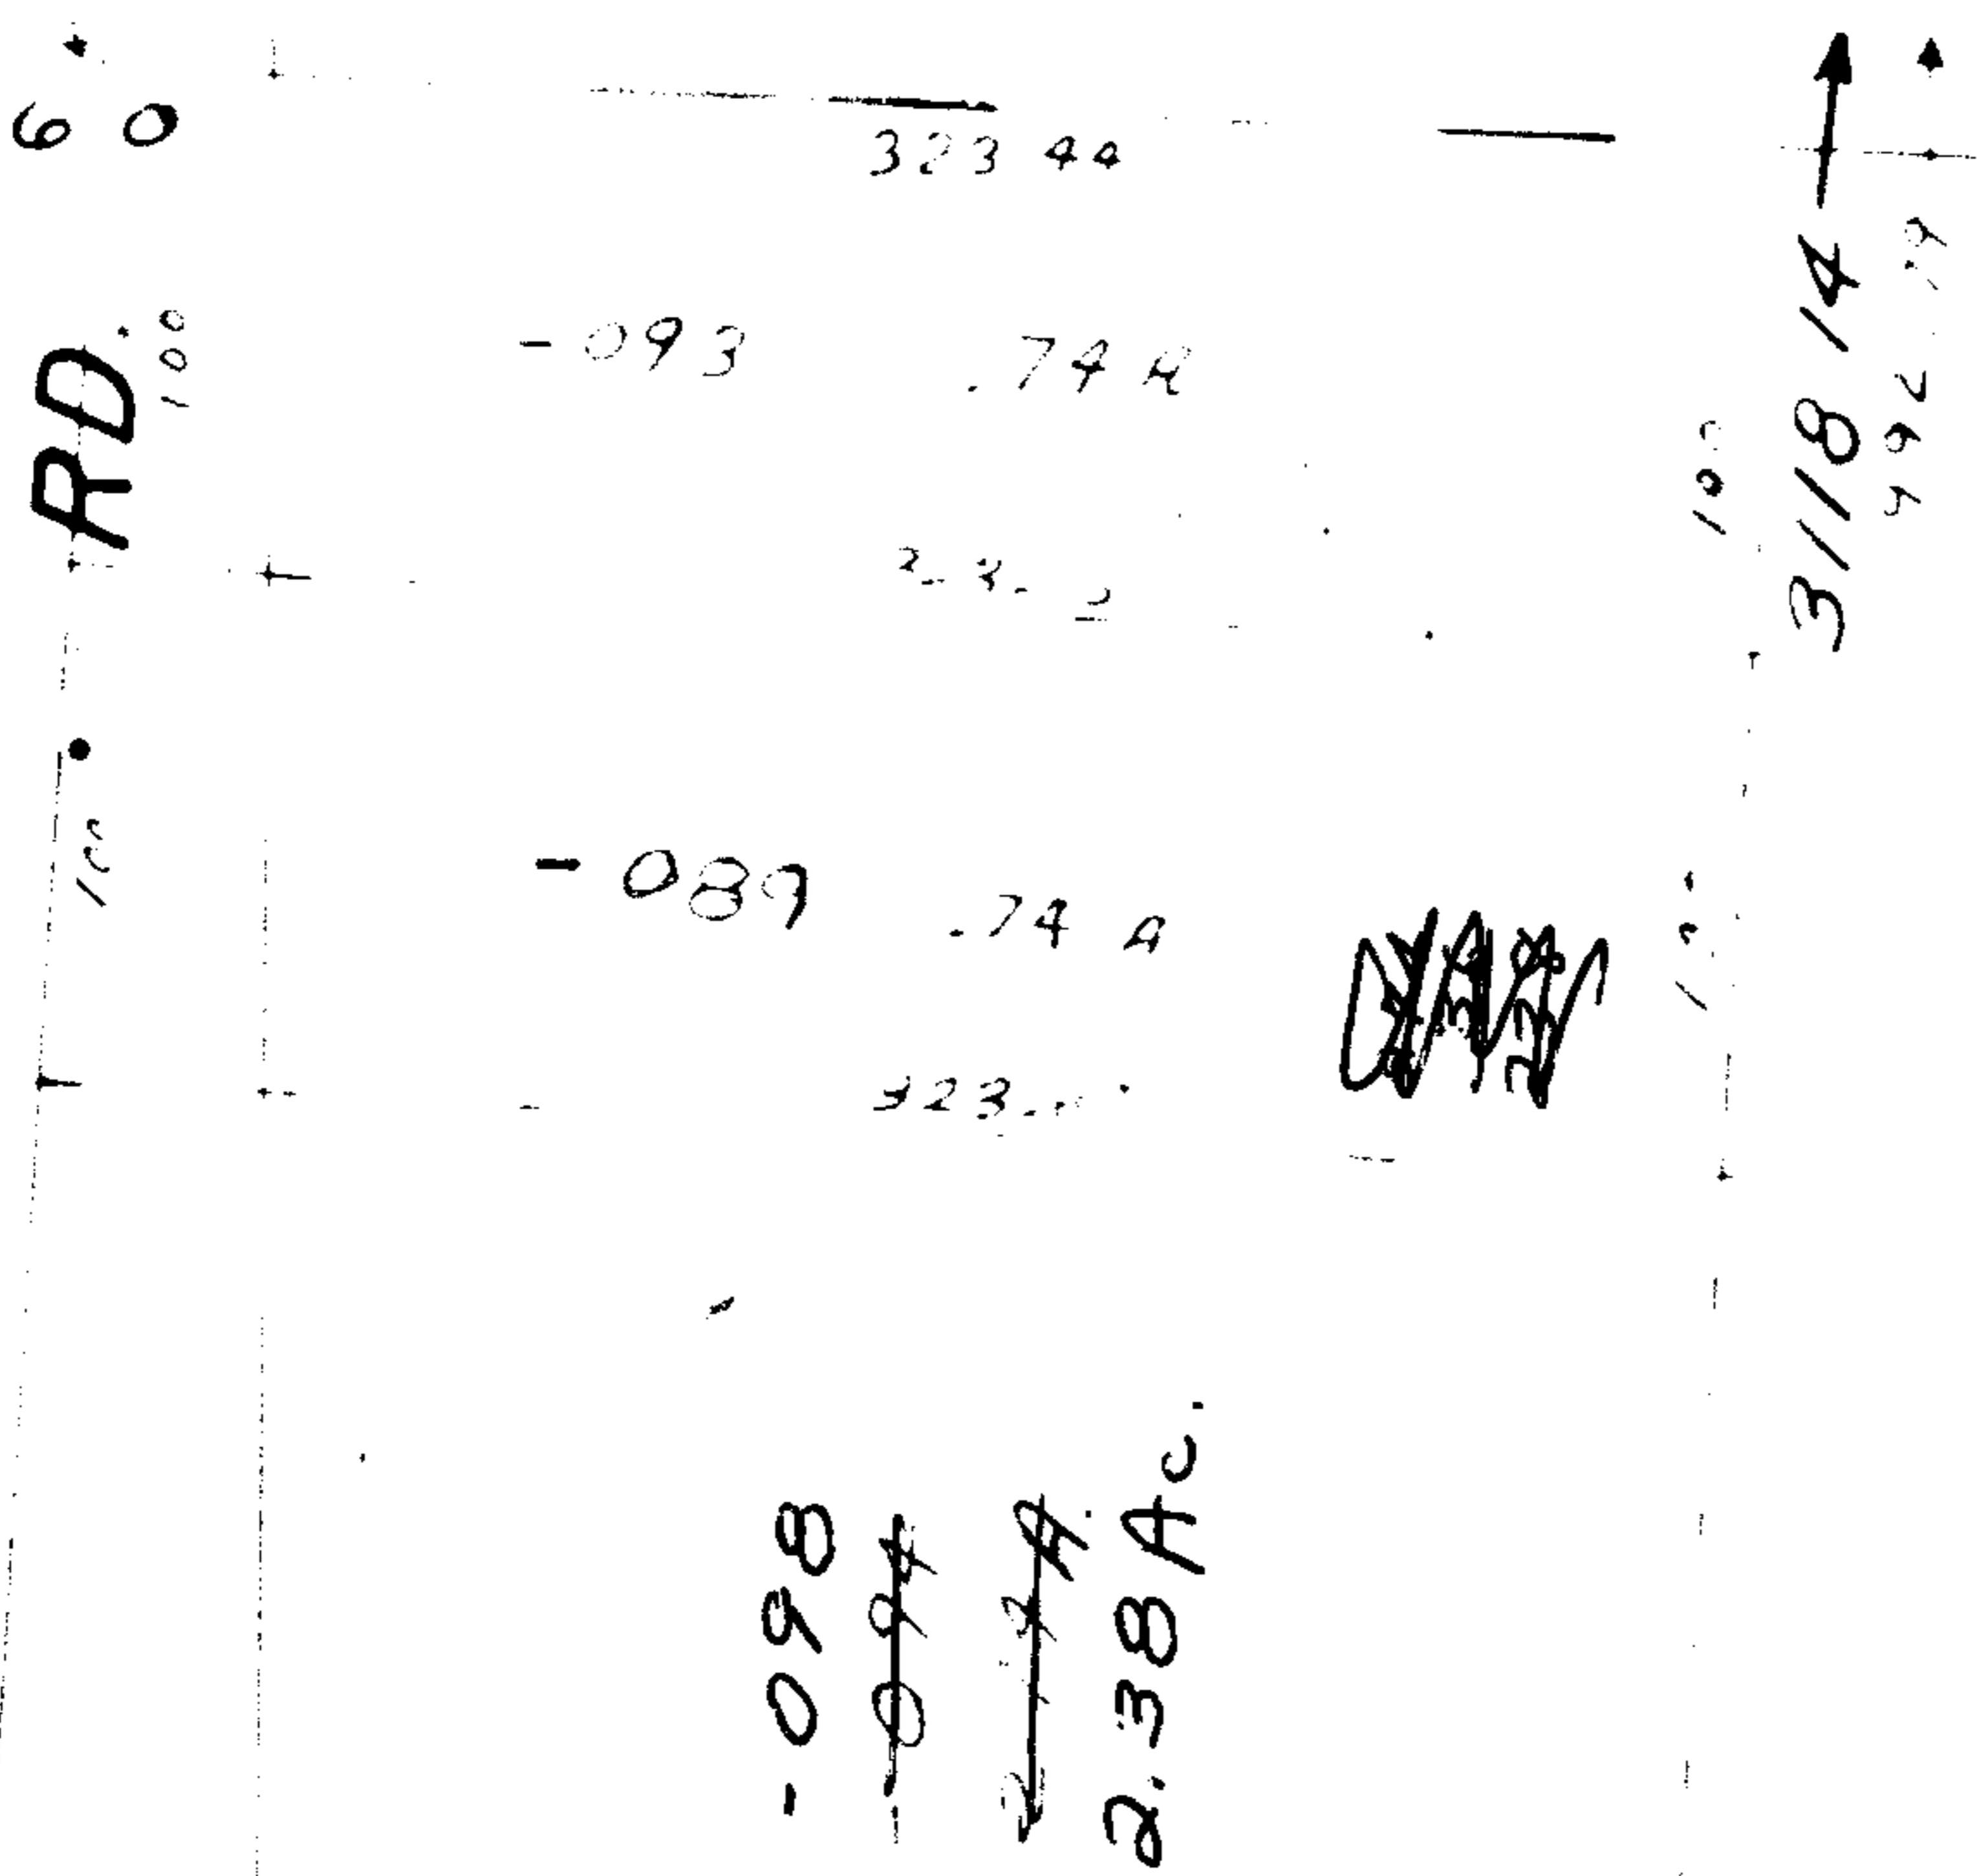


OK

7422

APPROVED
 LORAIN CO.
 MAP DEPT.
 DATE 9-27-73
 7-00-034-C
 BY *[Signature]*

[Handwritten signature]

7-29-86 L.S.H.

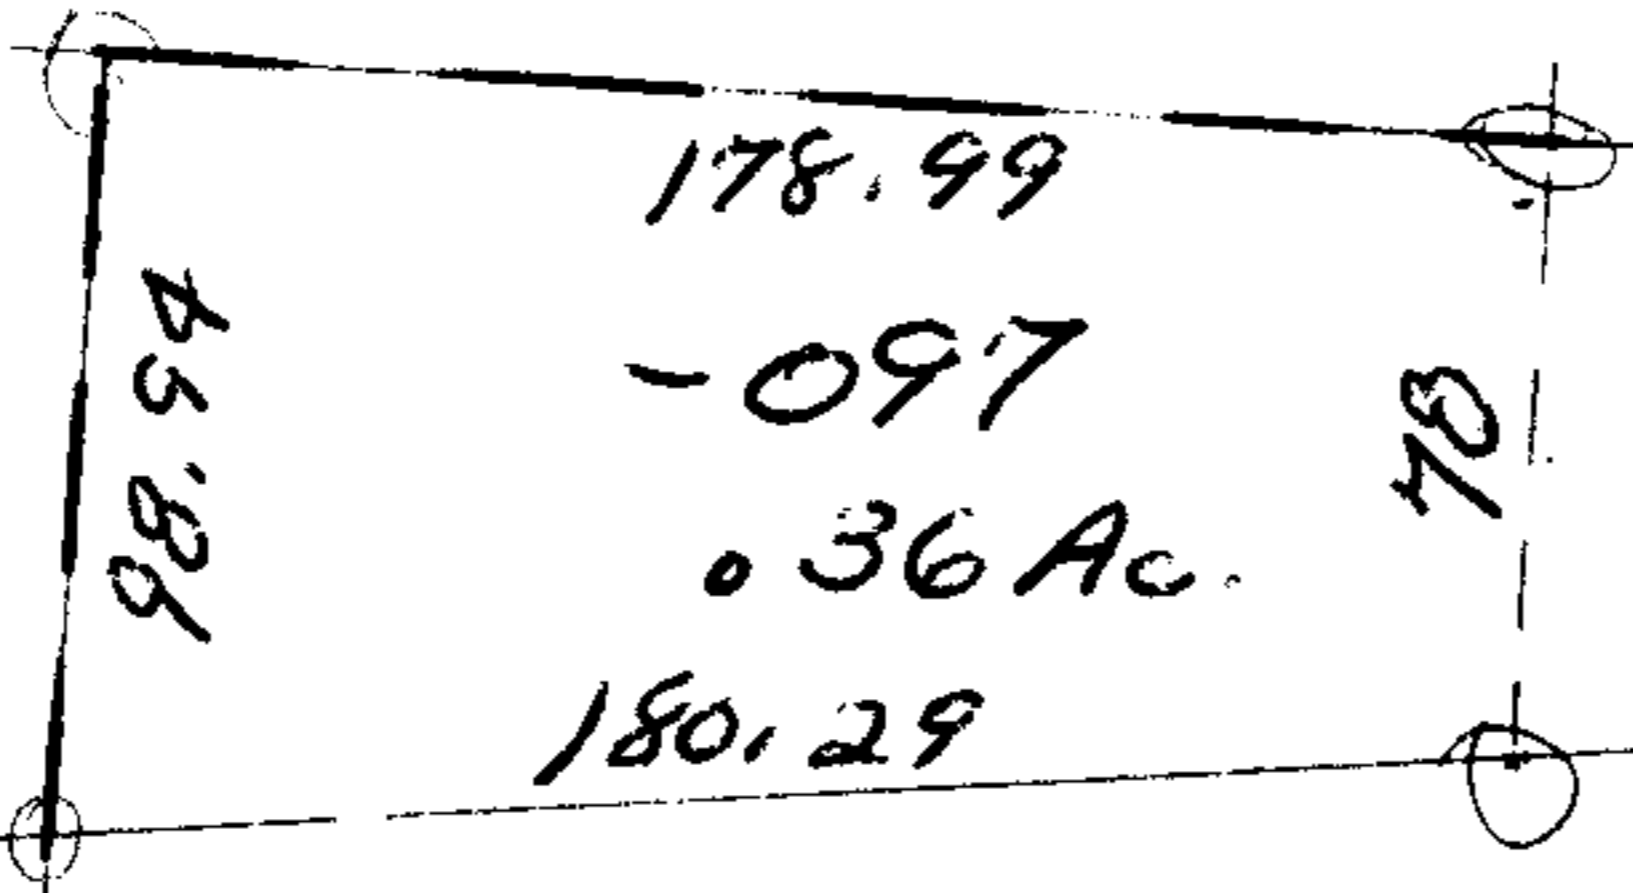

OHIO

7-00-039-D

#146.11

6-104

621

PA - 059
15000