


THE LAKE SUB. NO. 2

Tax Map Correction
7431

P. 20

1-00-003-B

LIBERTY AVE RD. RD.

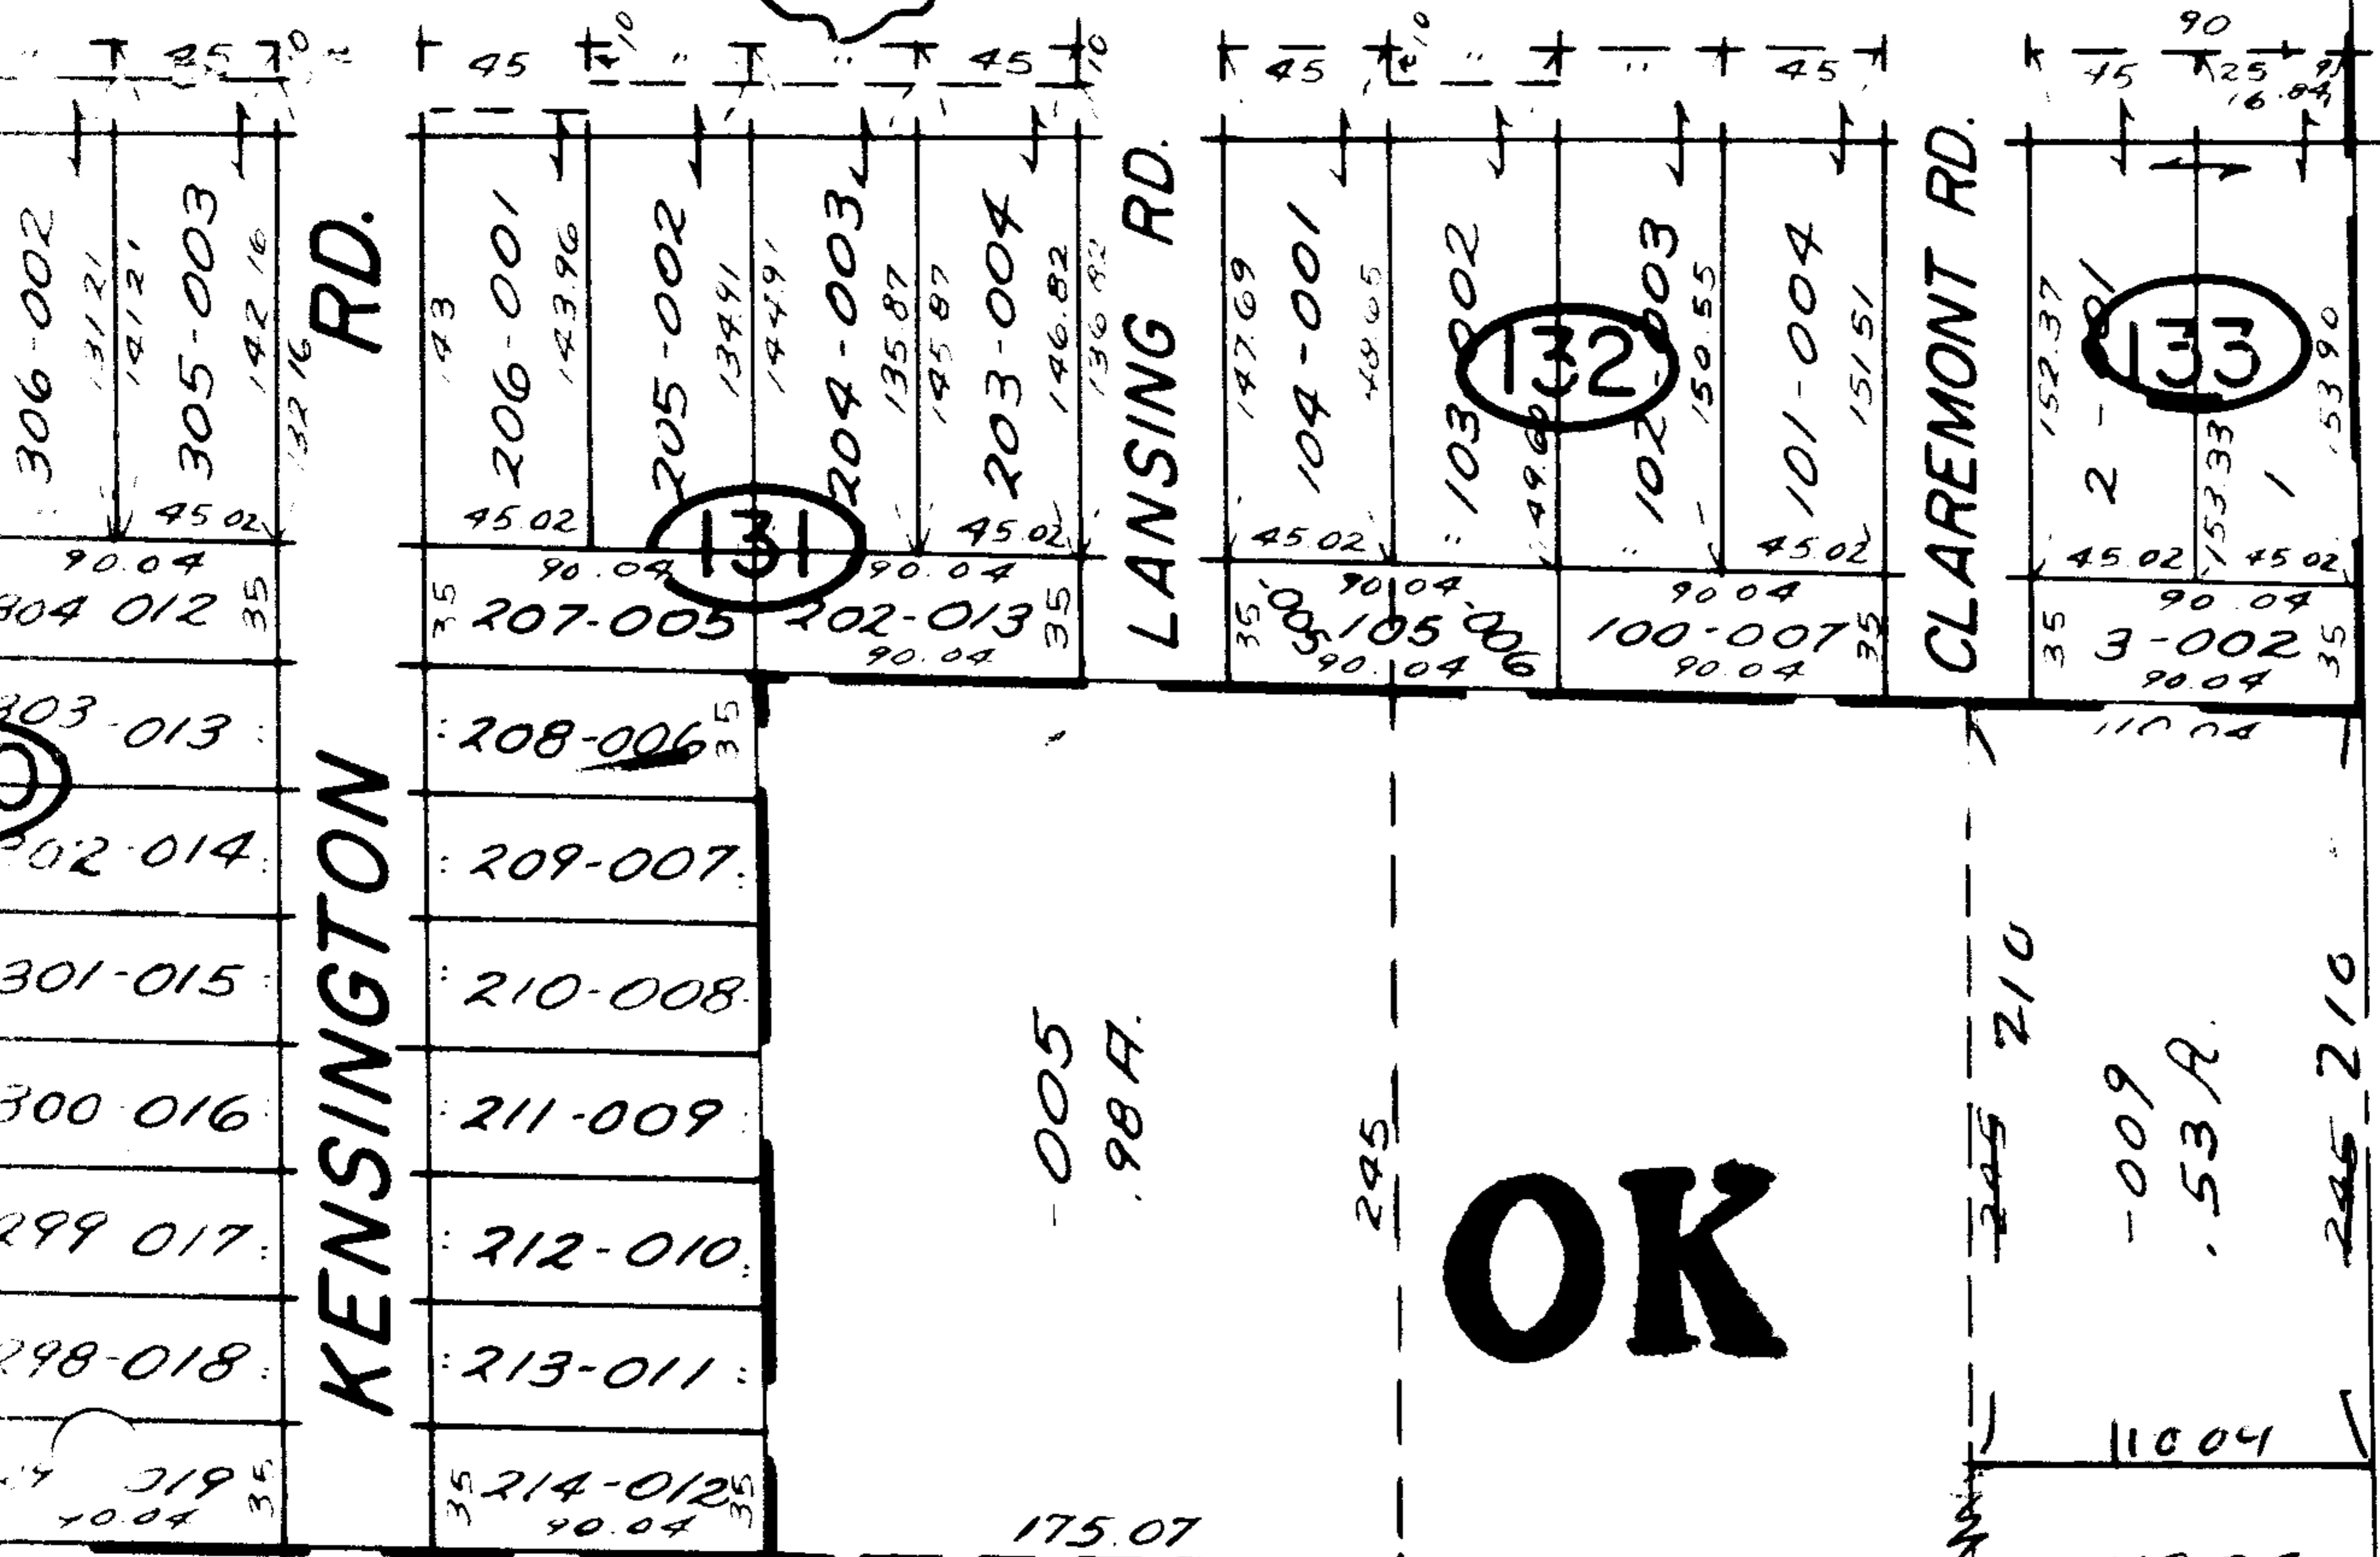

OK

Handwritten signature
139

-006
717A

1-00-003D

7431

APPROVED LORAIN CO. MAP DEPT.	
DATE	10-1-33
PAGE	100-003D
BY	L. W. Hall
VOID AFTER	

1-00-004-C