

17-00-004-000-014

Sec 17B

Pt. 17-07-004-500-003

17-00-004-000-015
07 AC

8

L. E.

R. R.


66

42

60

RD.

~~005~~
12.63 AC
12.56
SEE 17-B

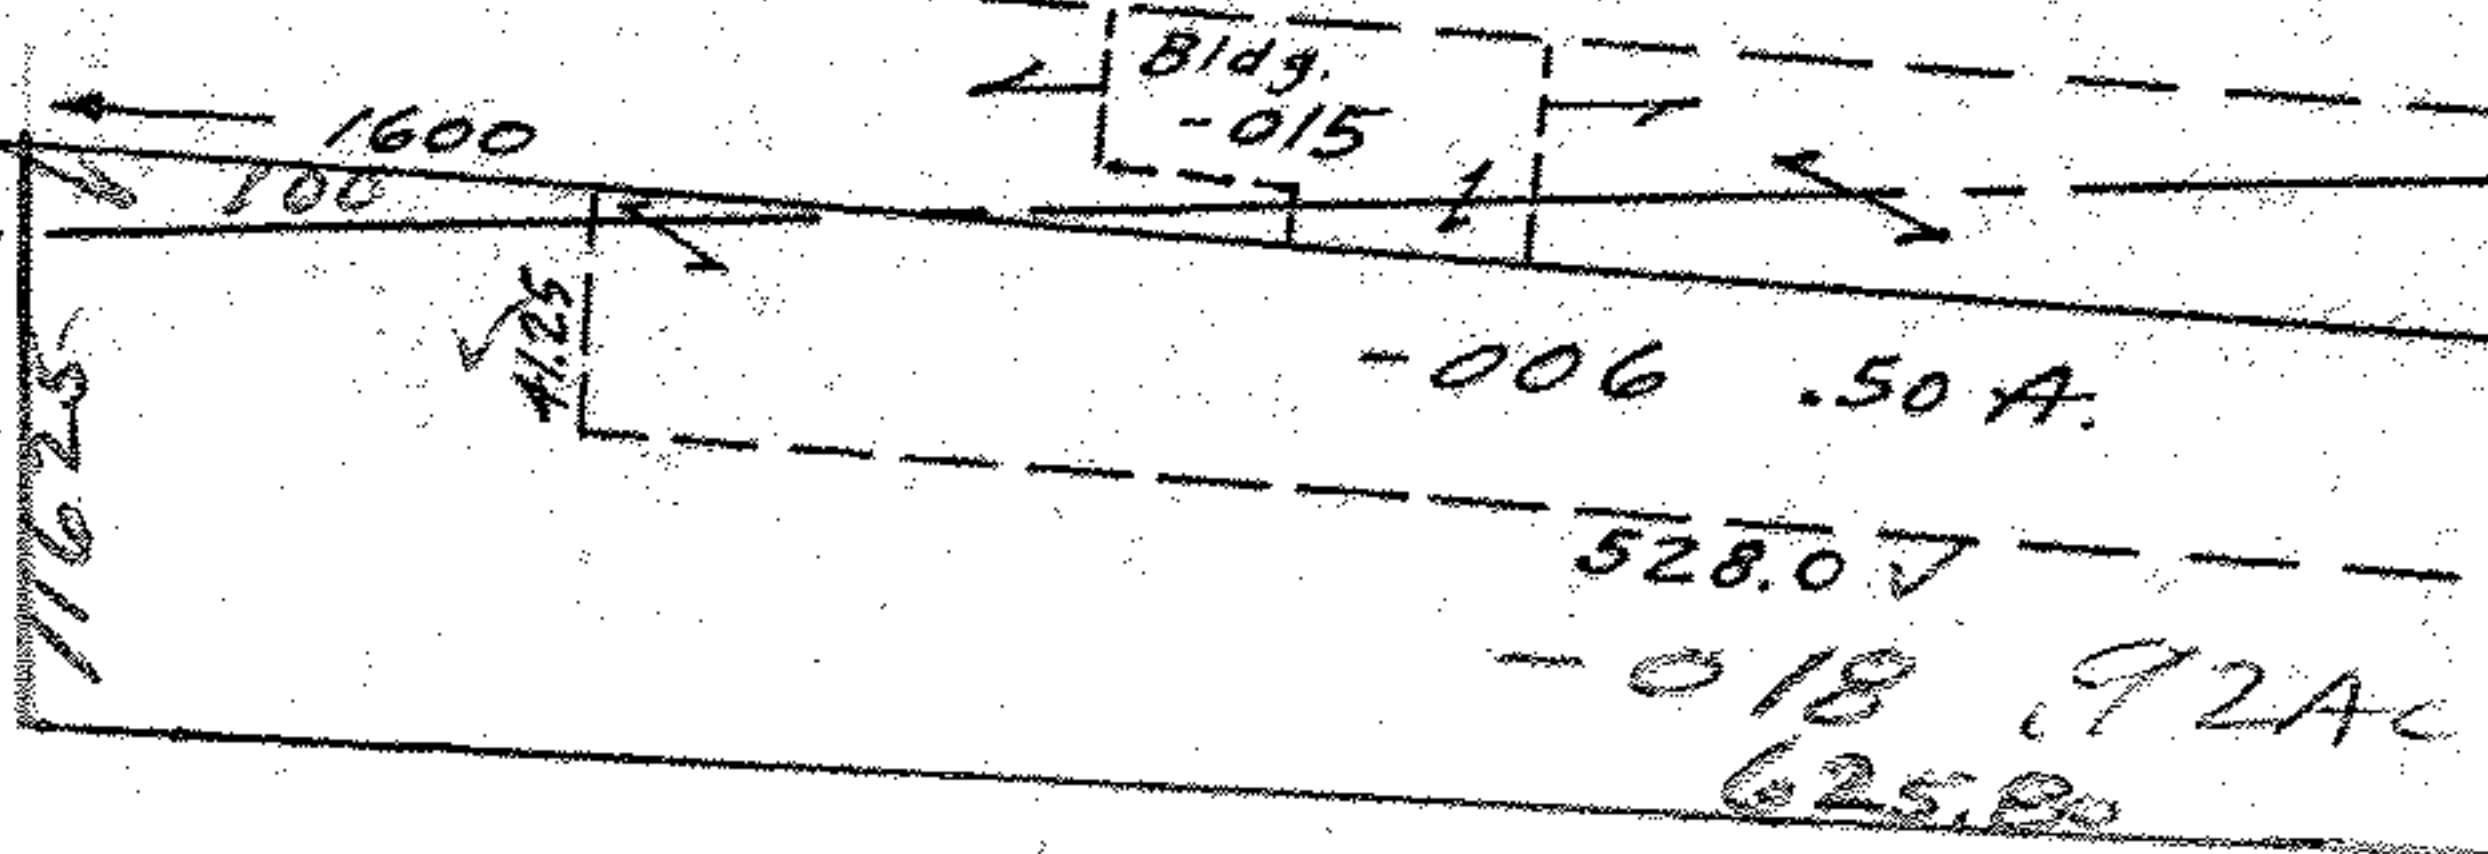

165

2475

1056.0

07.222

825.0

019
-005
14.43 A.
13.51 AC

7-30-86 L. E. L.

APPROVED
LORAIN CO.
MAP DEPT.
DATE 10-15-73
PAGE 17-00-007B
BY L. E. L.
VOID AFTER

7163

OK