


7471



NORWALK-KIPTON EAST

(120 & Variable)

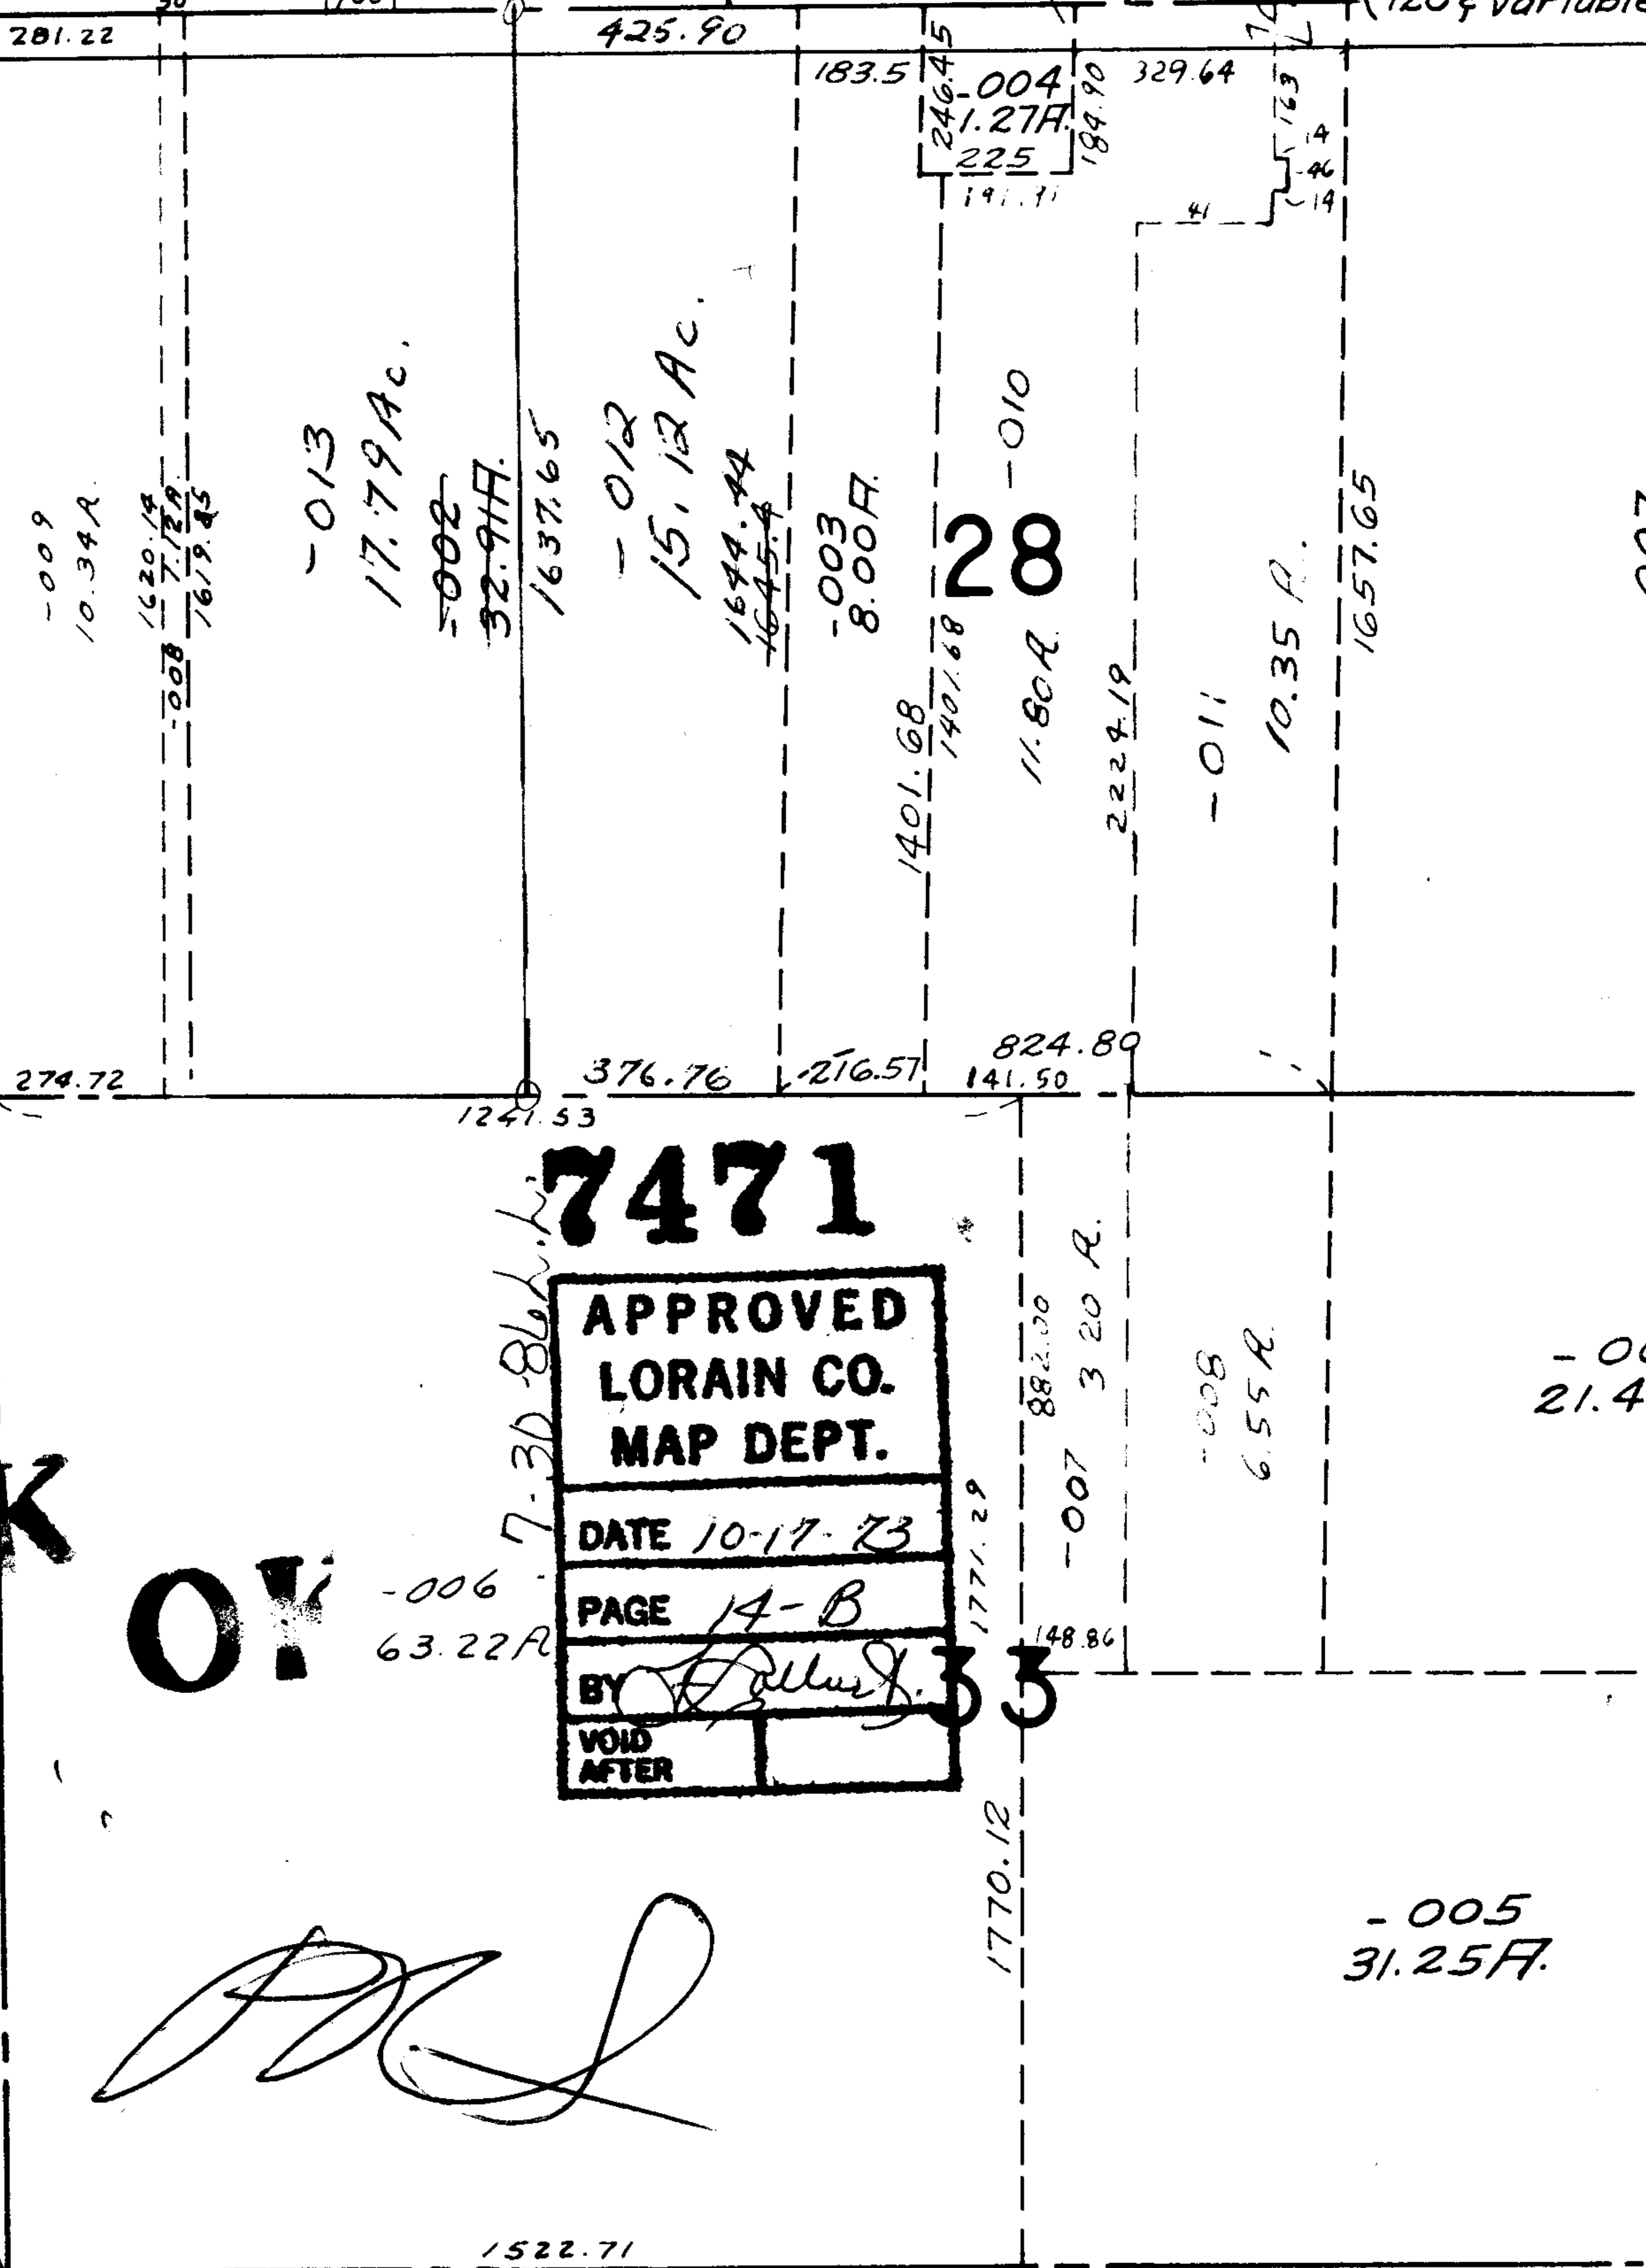

7471

APPROVED
LORAIN CO.
MAP DEPT.

DATE 10-17-73

PAGE 14-B

BY *[Signature]*

VOID
AFTER

OK
OK

[Signature]

SEE 14-A

- 00.
21.49

- 005
31.25F.

- 007