


7479

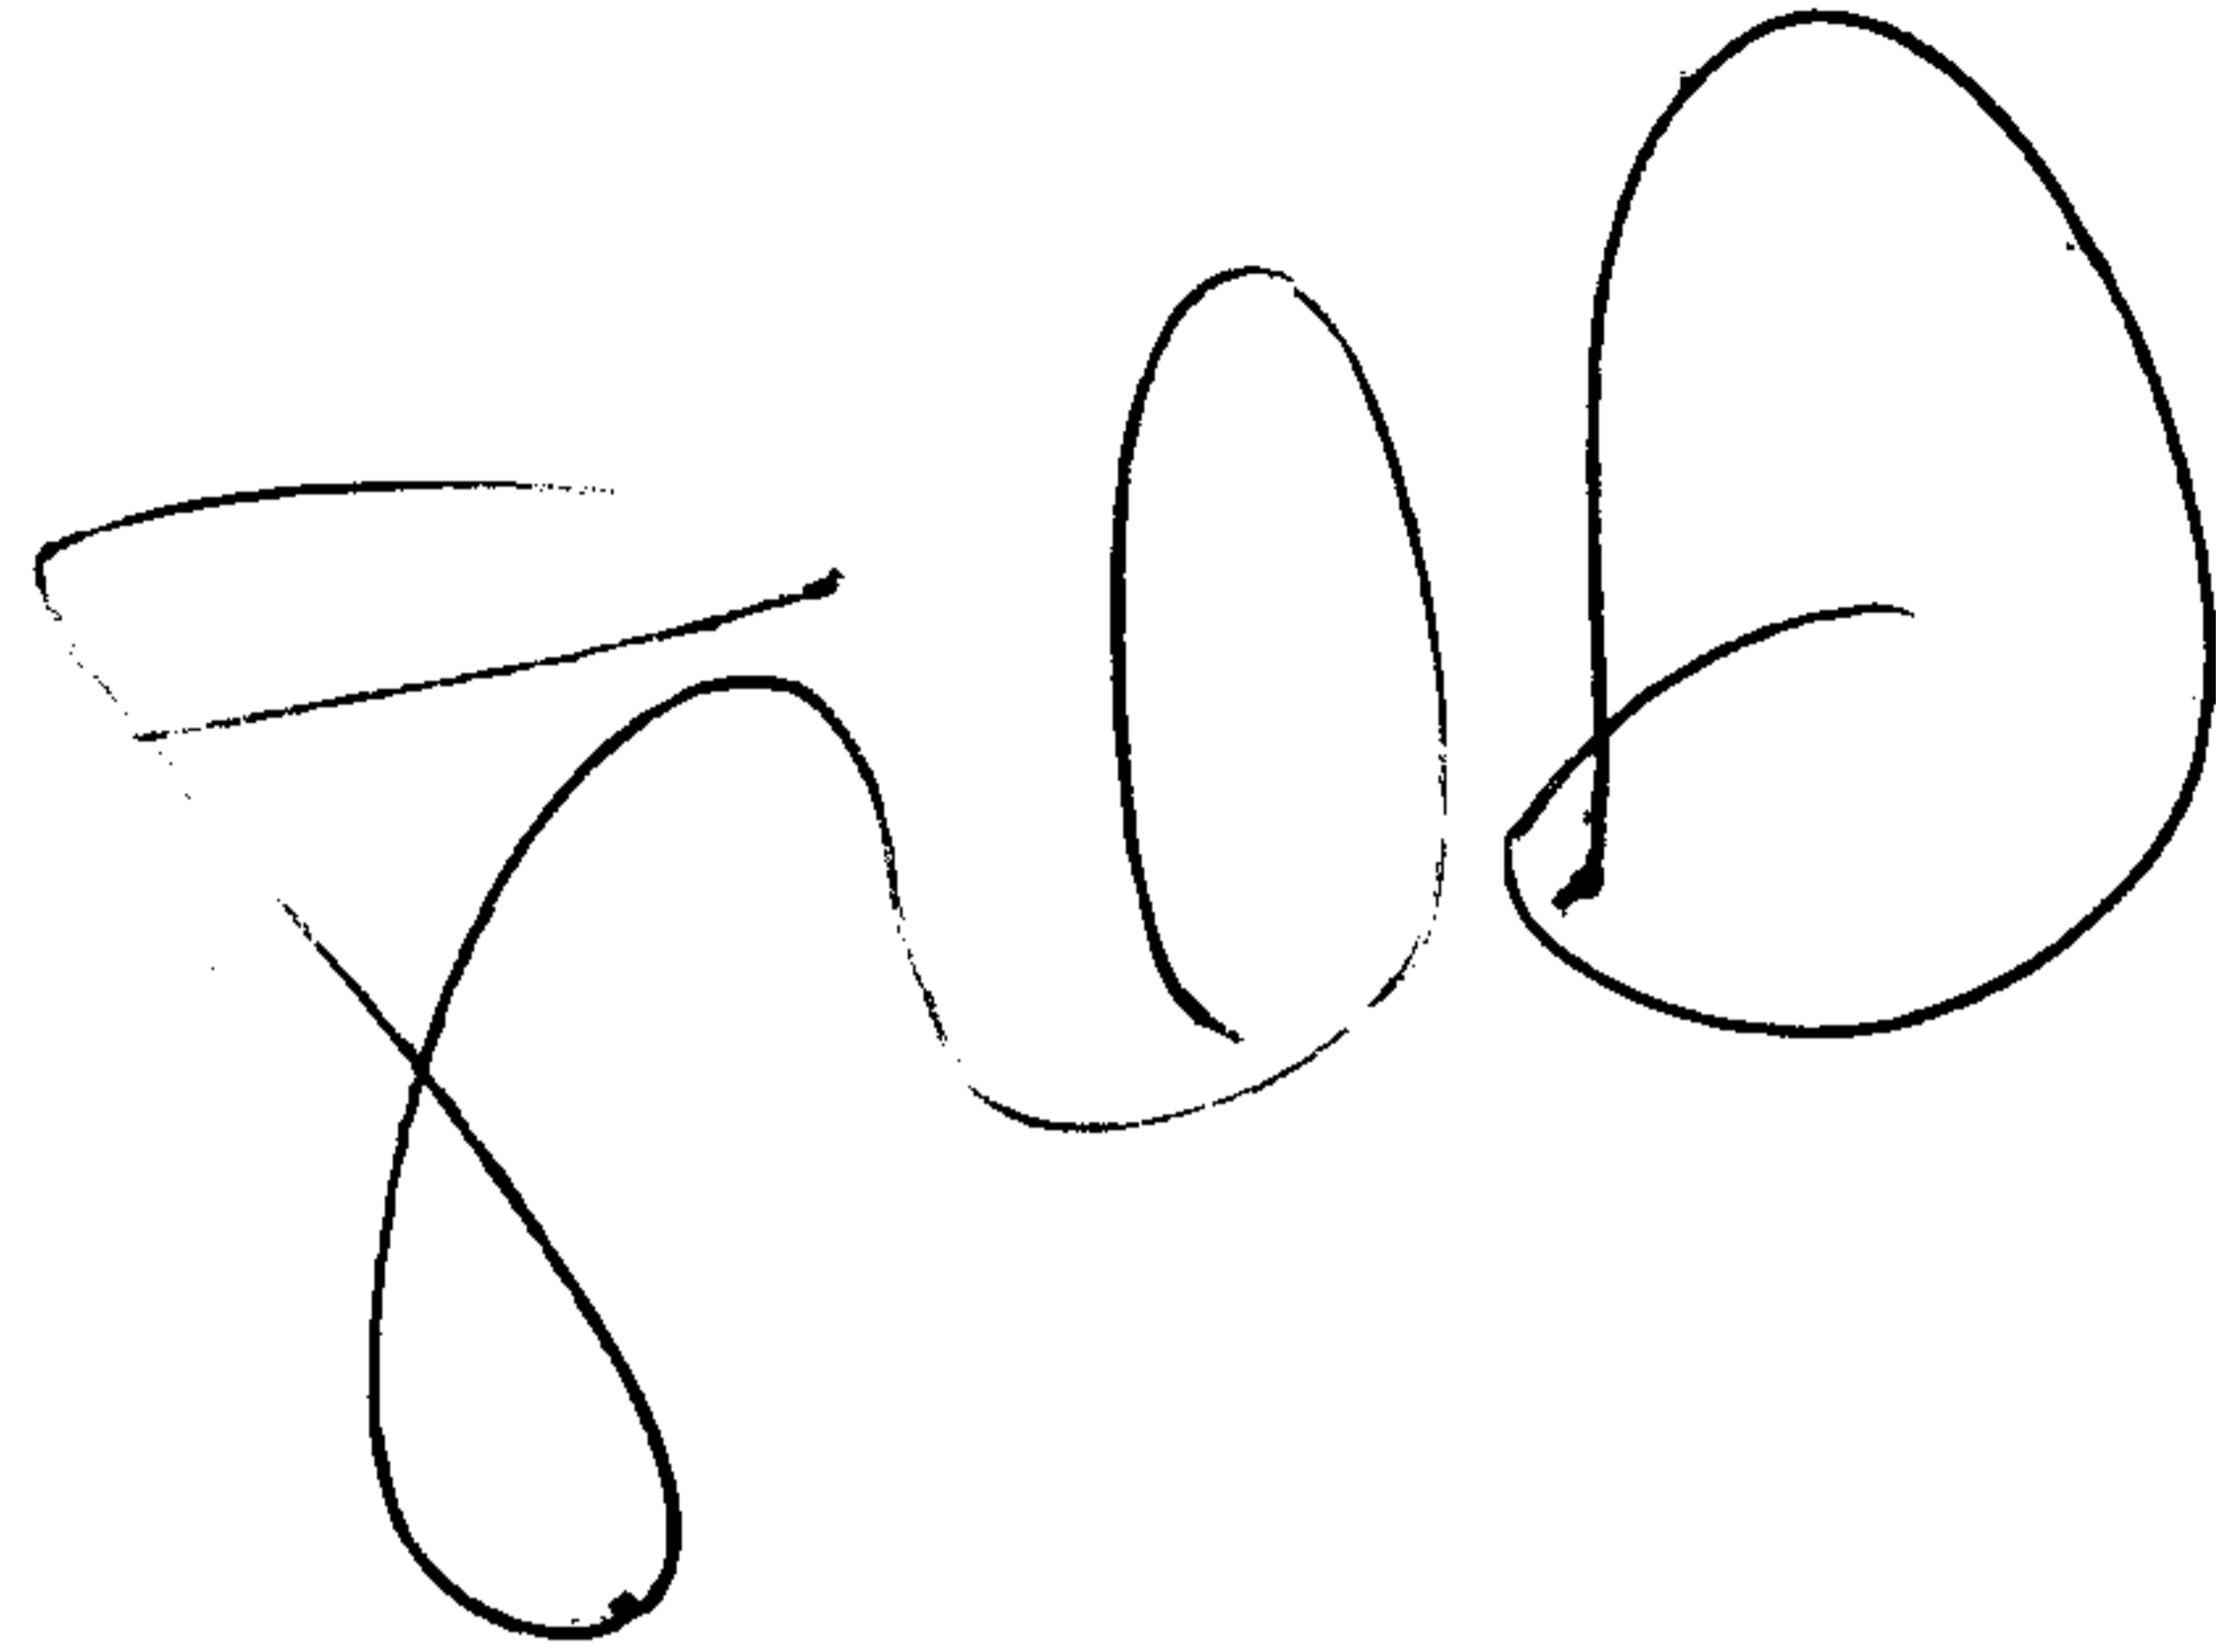

7479

APPROVED
 LORAIN CO.
 MAP DEPT.

DATE 10-19-23

PAGE 12-00-038-B

BY *Faller*

VOID AFTER

D.D. 8-5-84

BAY VILLAGE

MALDEN CREEK

P/D

Deed 678/368
Parcel #7

? -014
2.80 A.

OK

Bed

108
S. 28° 30' E.
68.84 64.46

S. 89° 55' W.
315
-056
029° 50 Ac.
307.60

-057
48 Ac.
300

-058
44 Ac.

S. 33° 30' W.
256

18-95

-031
82 A.

198.4

175.58

Pt. 12-00-022-000-015
Pt. 6.16 A.

222.85

-032
.50 A.

222.85

3.17

Handwritten calculations:
486
316
170
198
4A

1420

SEE 12-00-038-B

PR