

7481

[Handwritten signature]

106

011
-005


~~21.39 A.~~

~~21.25 A.~~

21.78 AC

21 AC

OK

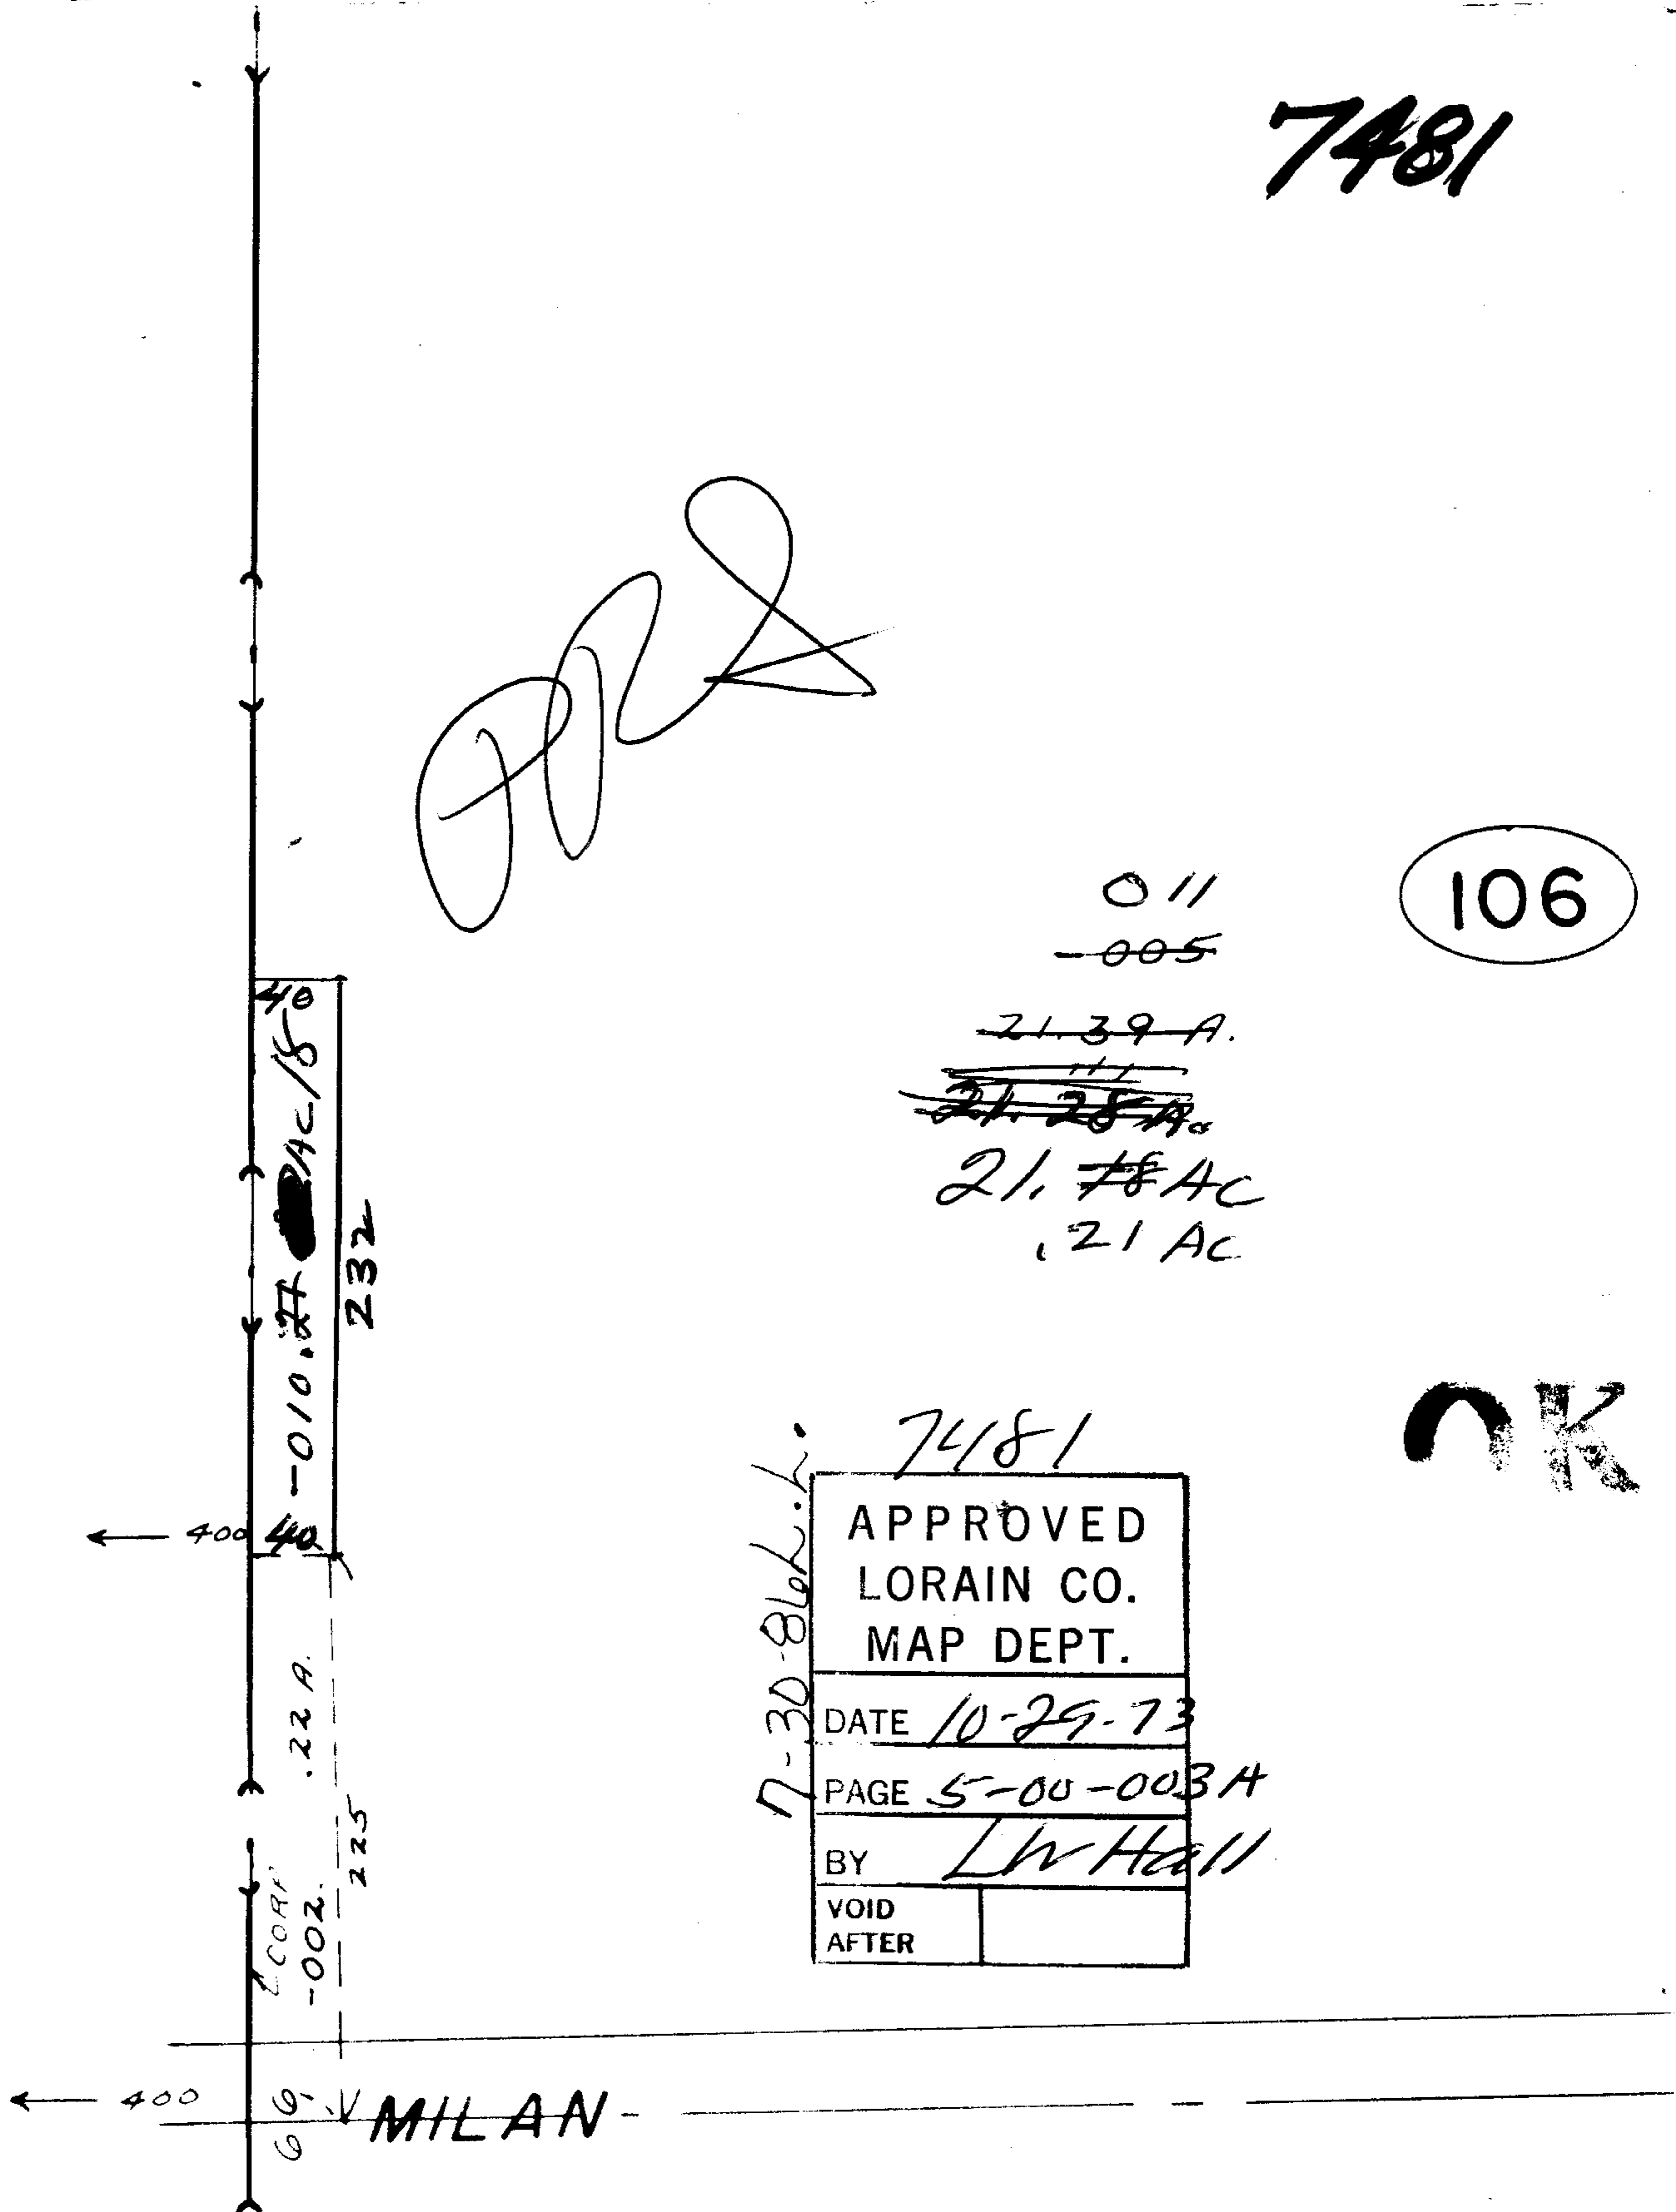

7-30-86 L.L.

7481

APPROVED LORAIN CO. MAP DEPT.	
DATE	10-29-73
PAGE	5-00-003A
BY	LW Hall
VOID AFTER	

ght 963
d 2-68

00-003-A

AMHERST

TWP.

SCALE: 1" = 100'