


Tax Map Correction only
 for P.P.Nos 024-.73Ac
 025-.27Ac

7495
 7495
 SEE 7-00-035-A

7495

APPROVED	
LORAIN CO.	
MAP DEPT.	
DATE	10-26-73
RANGE	7-00-035B
L. W. Hall	
APPROVED BY	
DATE	

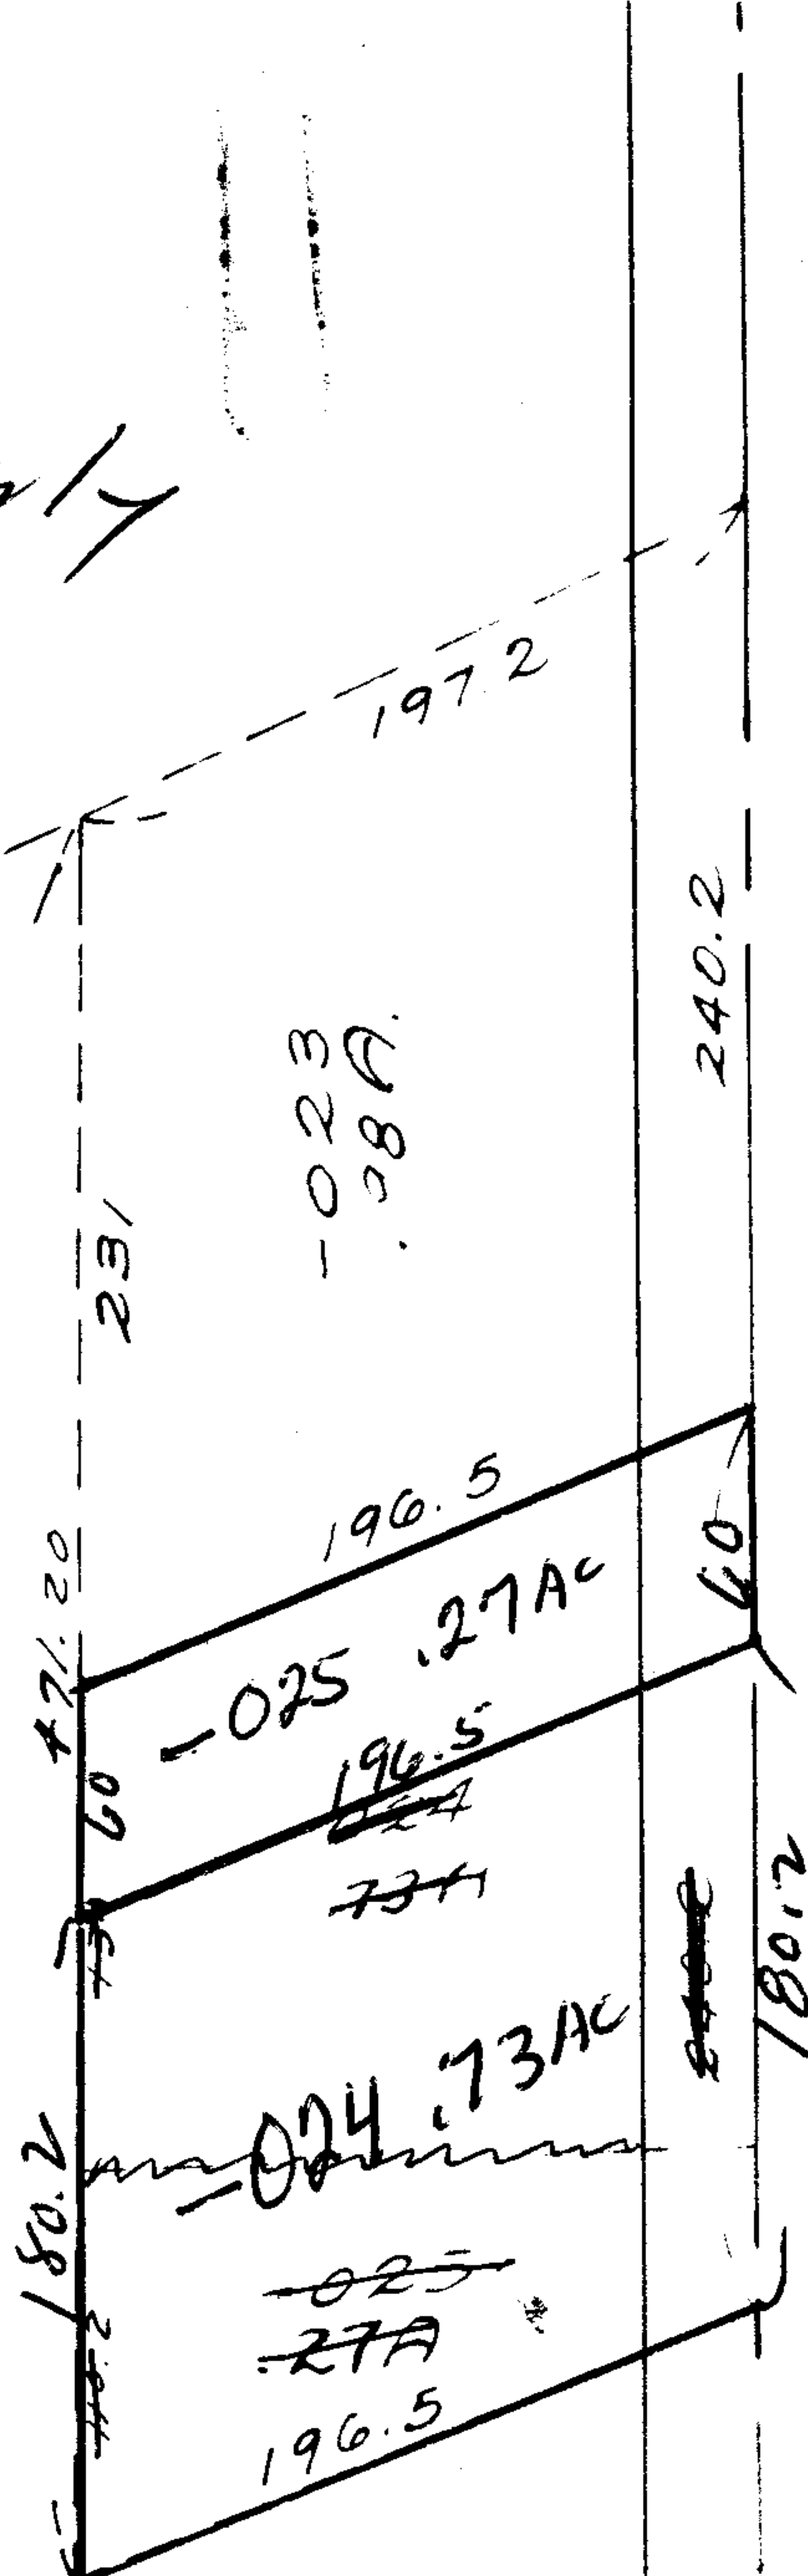

PRJ

OK
 OK

