


7499

*[Handwritten signature]*

LAFAYETTE

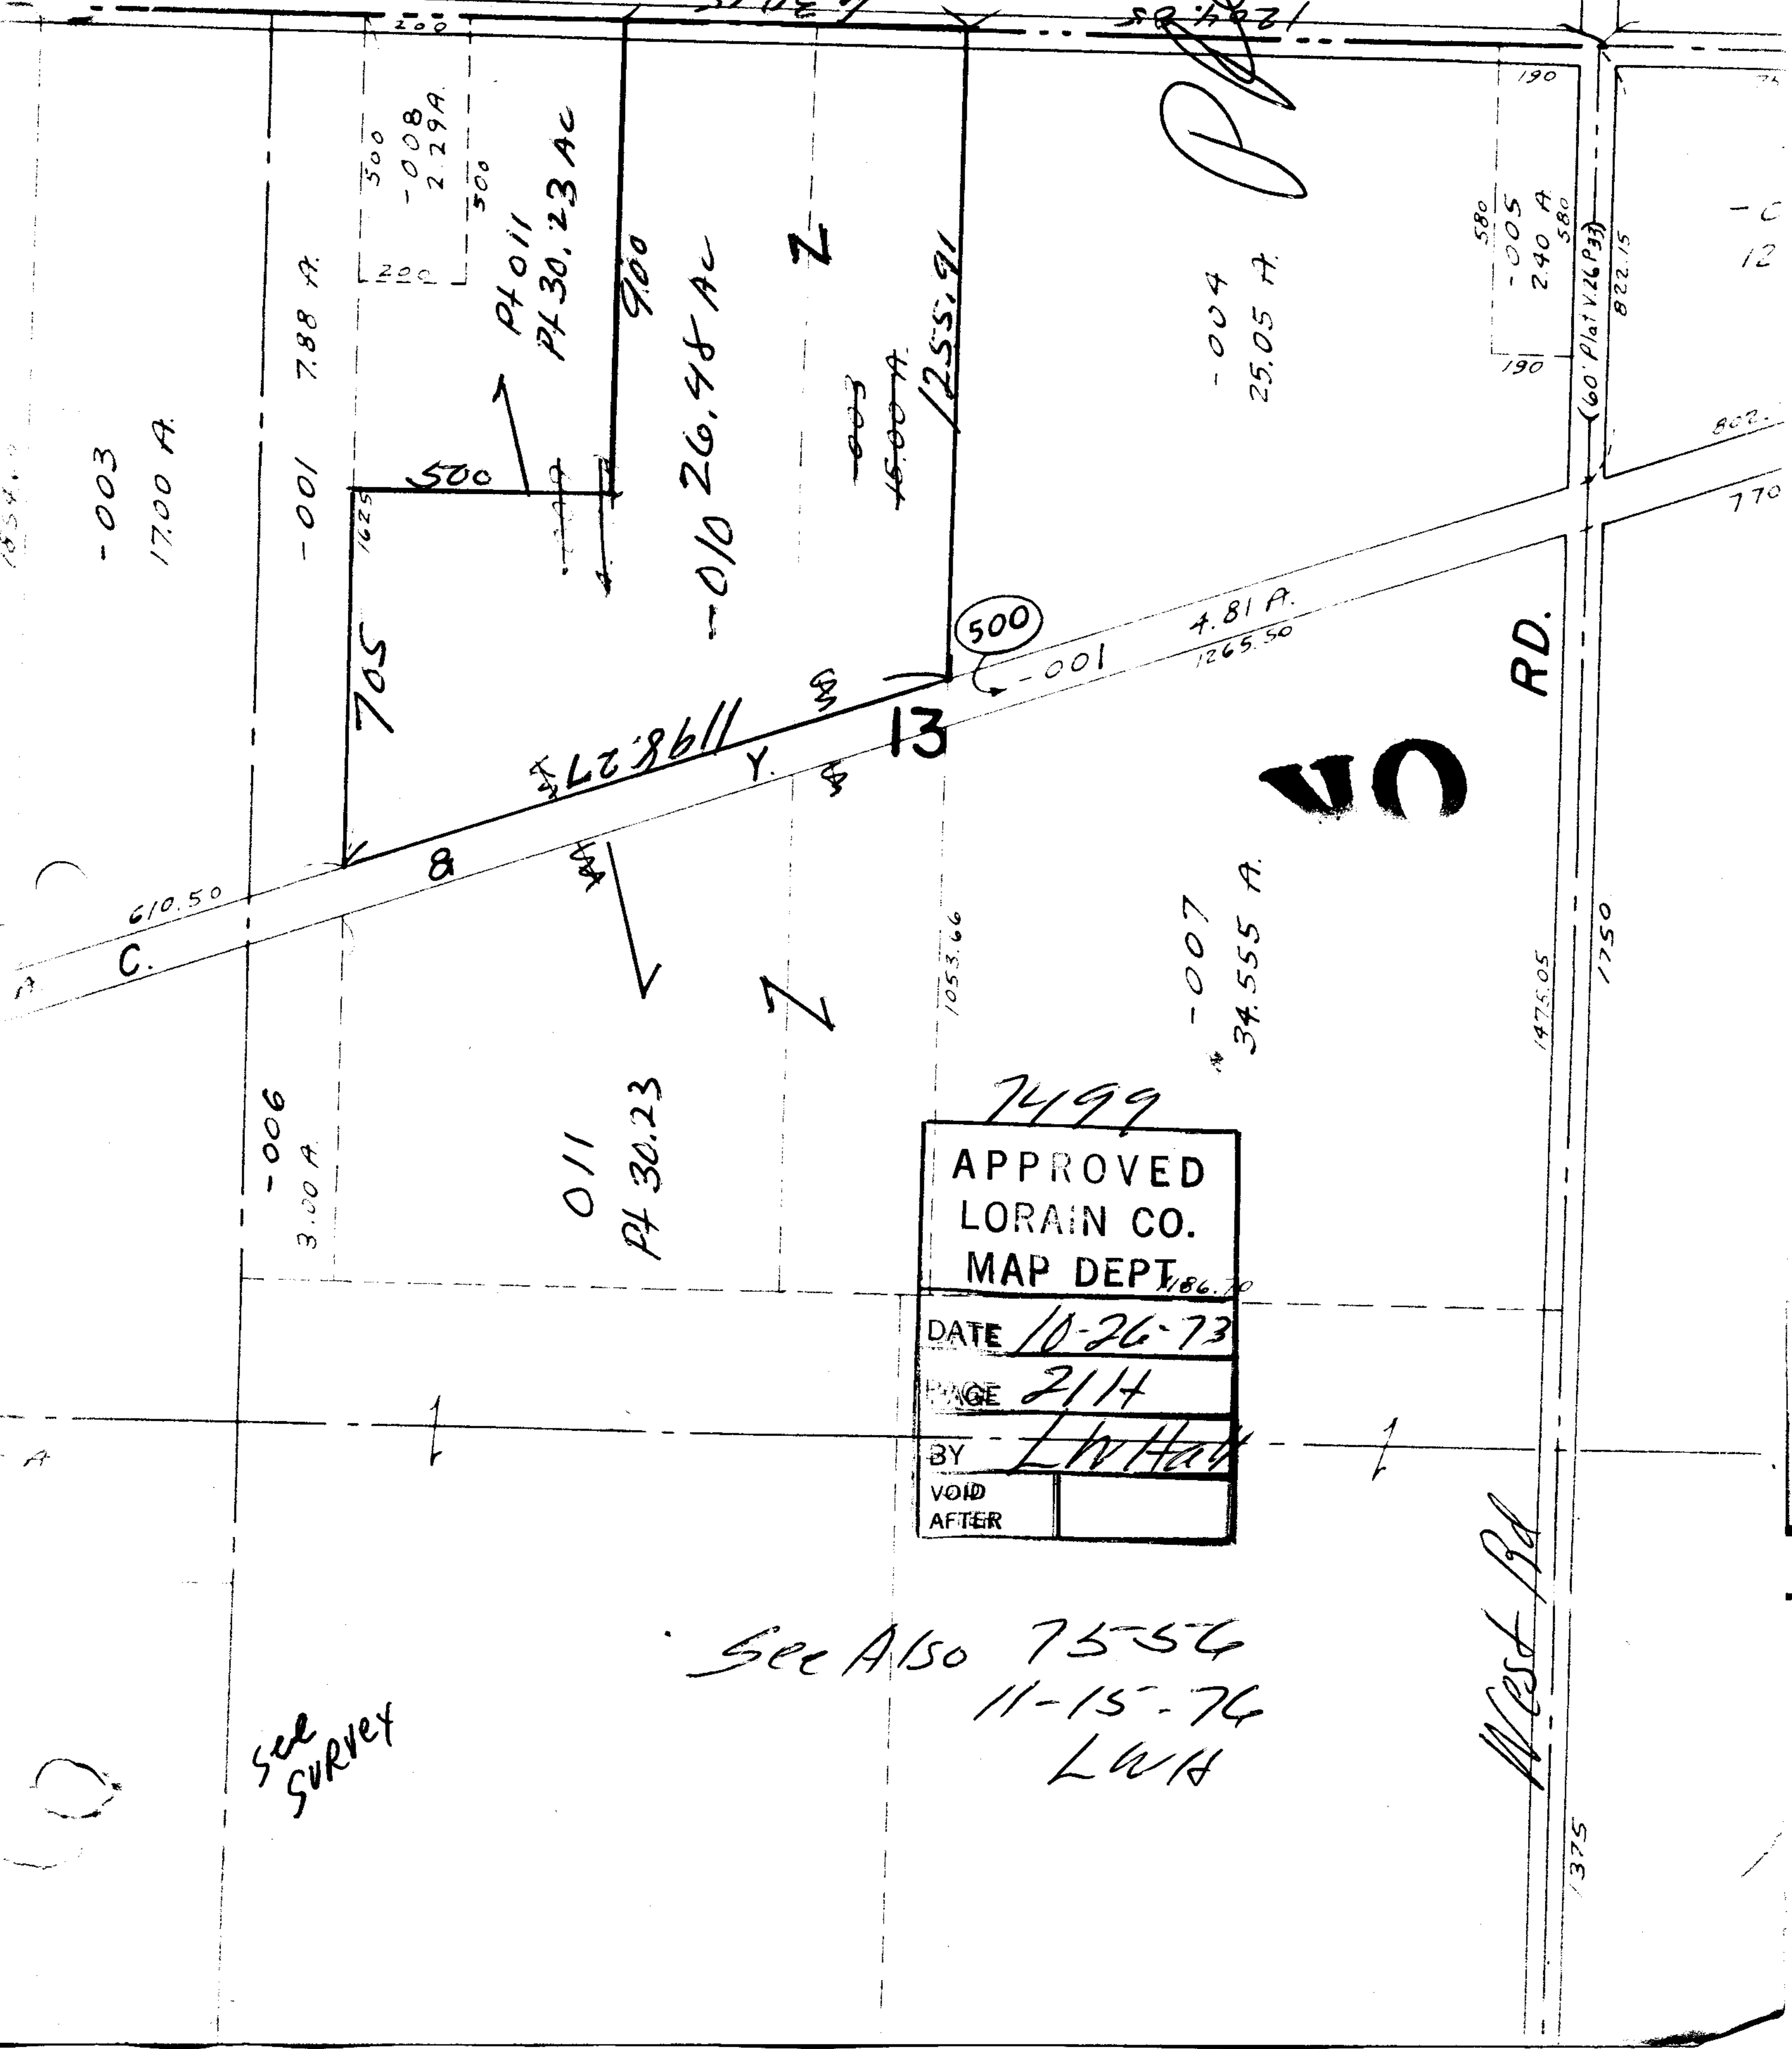

7499

APPROVED	
LORAIN CO.	
MAP DEPT.	
DATE	10-26-73
PAGE	2114
BY	LWH
VOID	
AFTER	

See Also 7554  
 11-15-74  
 LWH

See Survey

West Rd

375