


CRITTENDEN

ADD.

ST.

OK

See A 150 P4 SEE 15-00-046-B

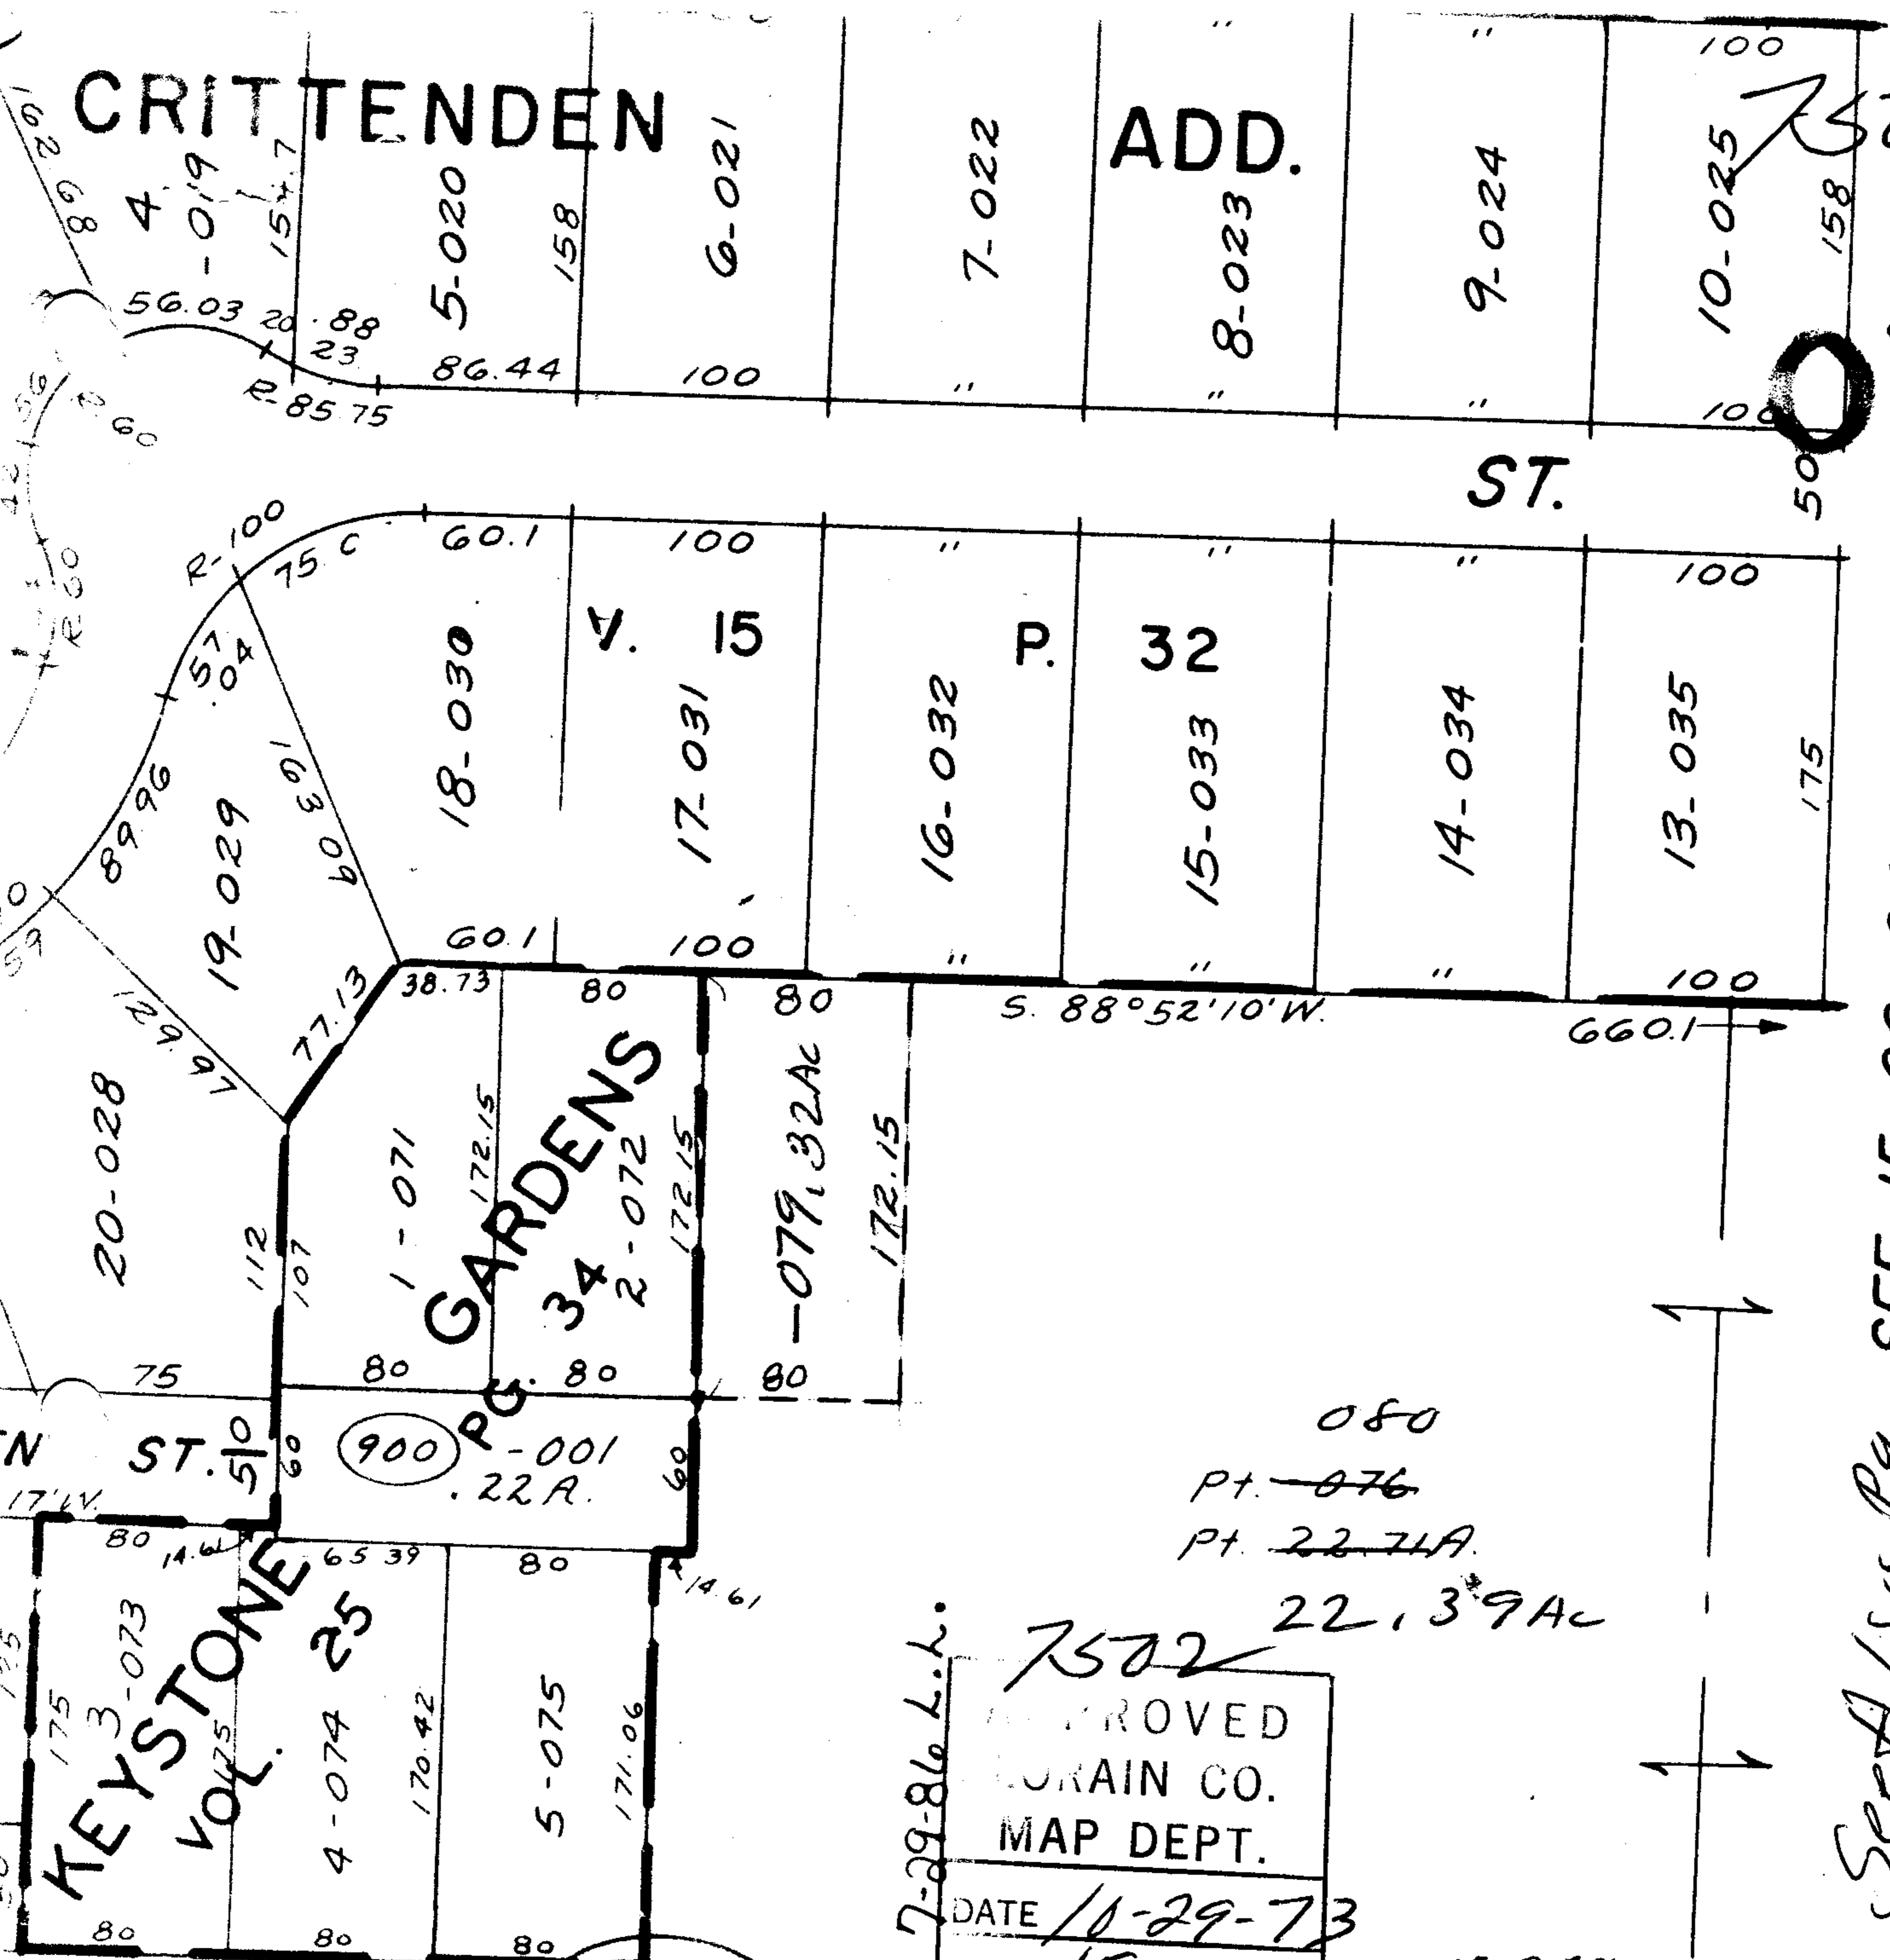

7-29-86 L.L.

7502

APPROVED  
MORAIN CO.  
MAP DEPT.

DATE 10-29-73

PAGE 15-00-046 A+B

BY L.W. Hall

VOID AFTER

509.48  
1699.5

Pt. - 065  
Pt. 941A

*[Handwritten signature]*