


7504

82 SEE 12-00-056-B

PRJ RD.

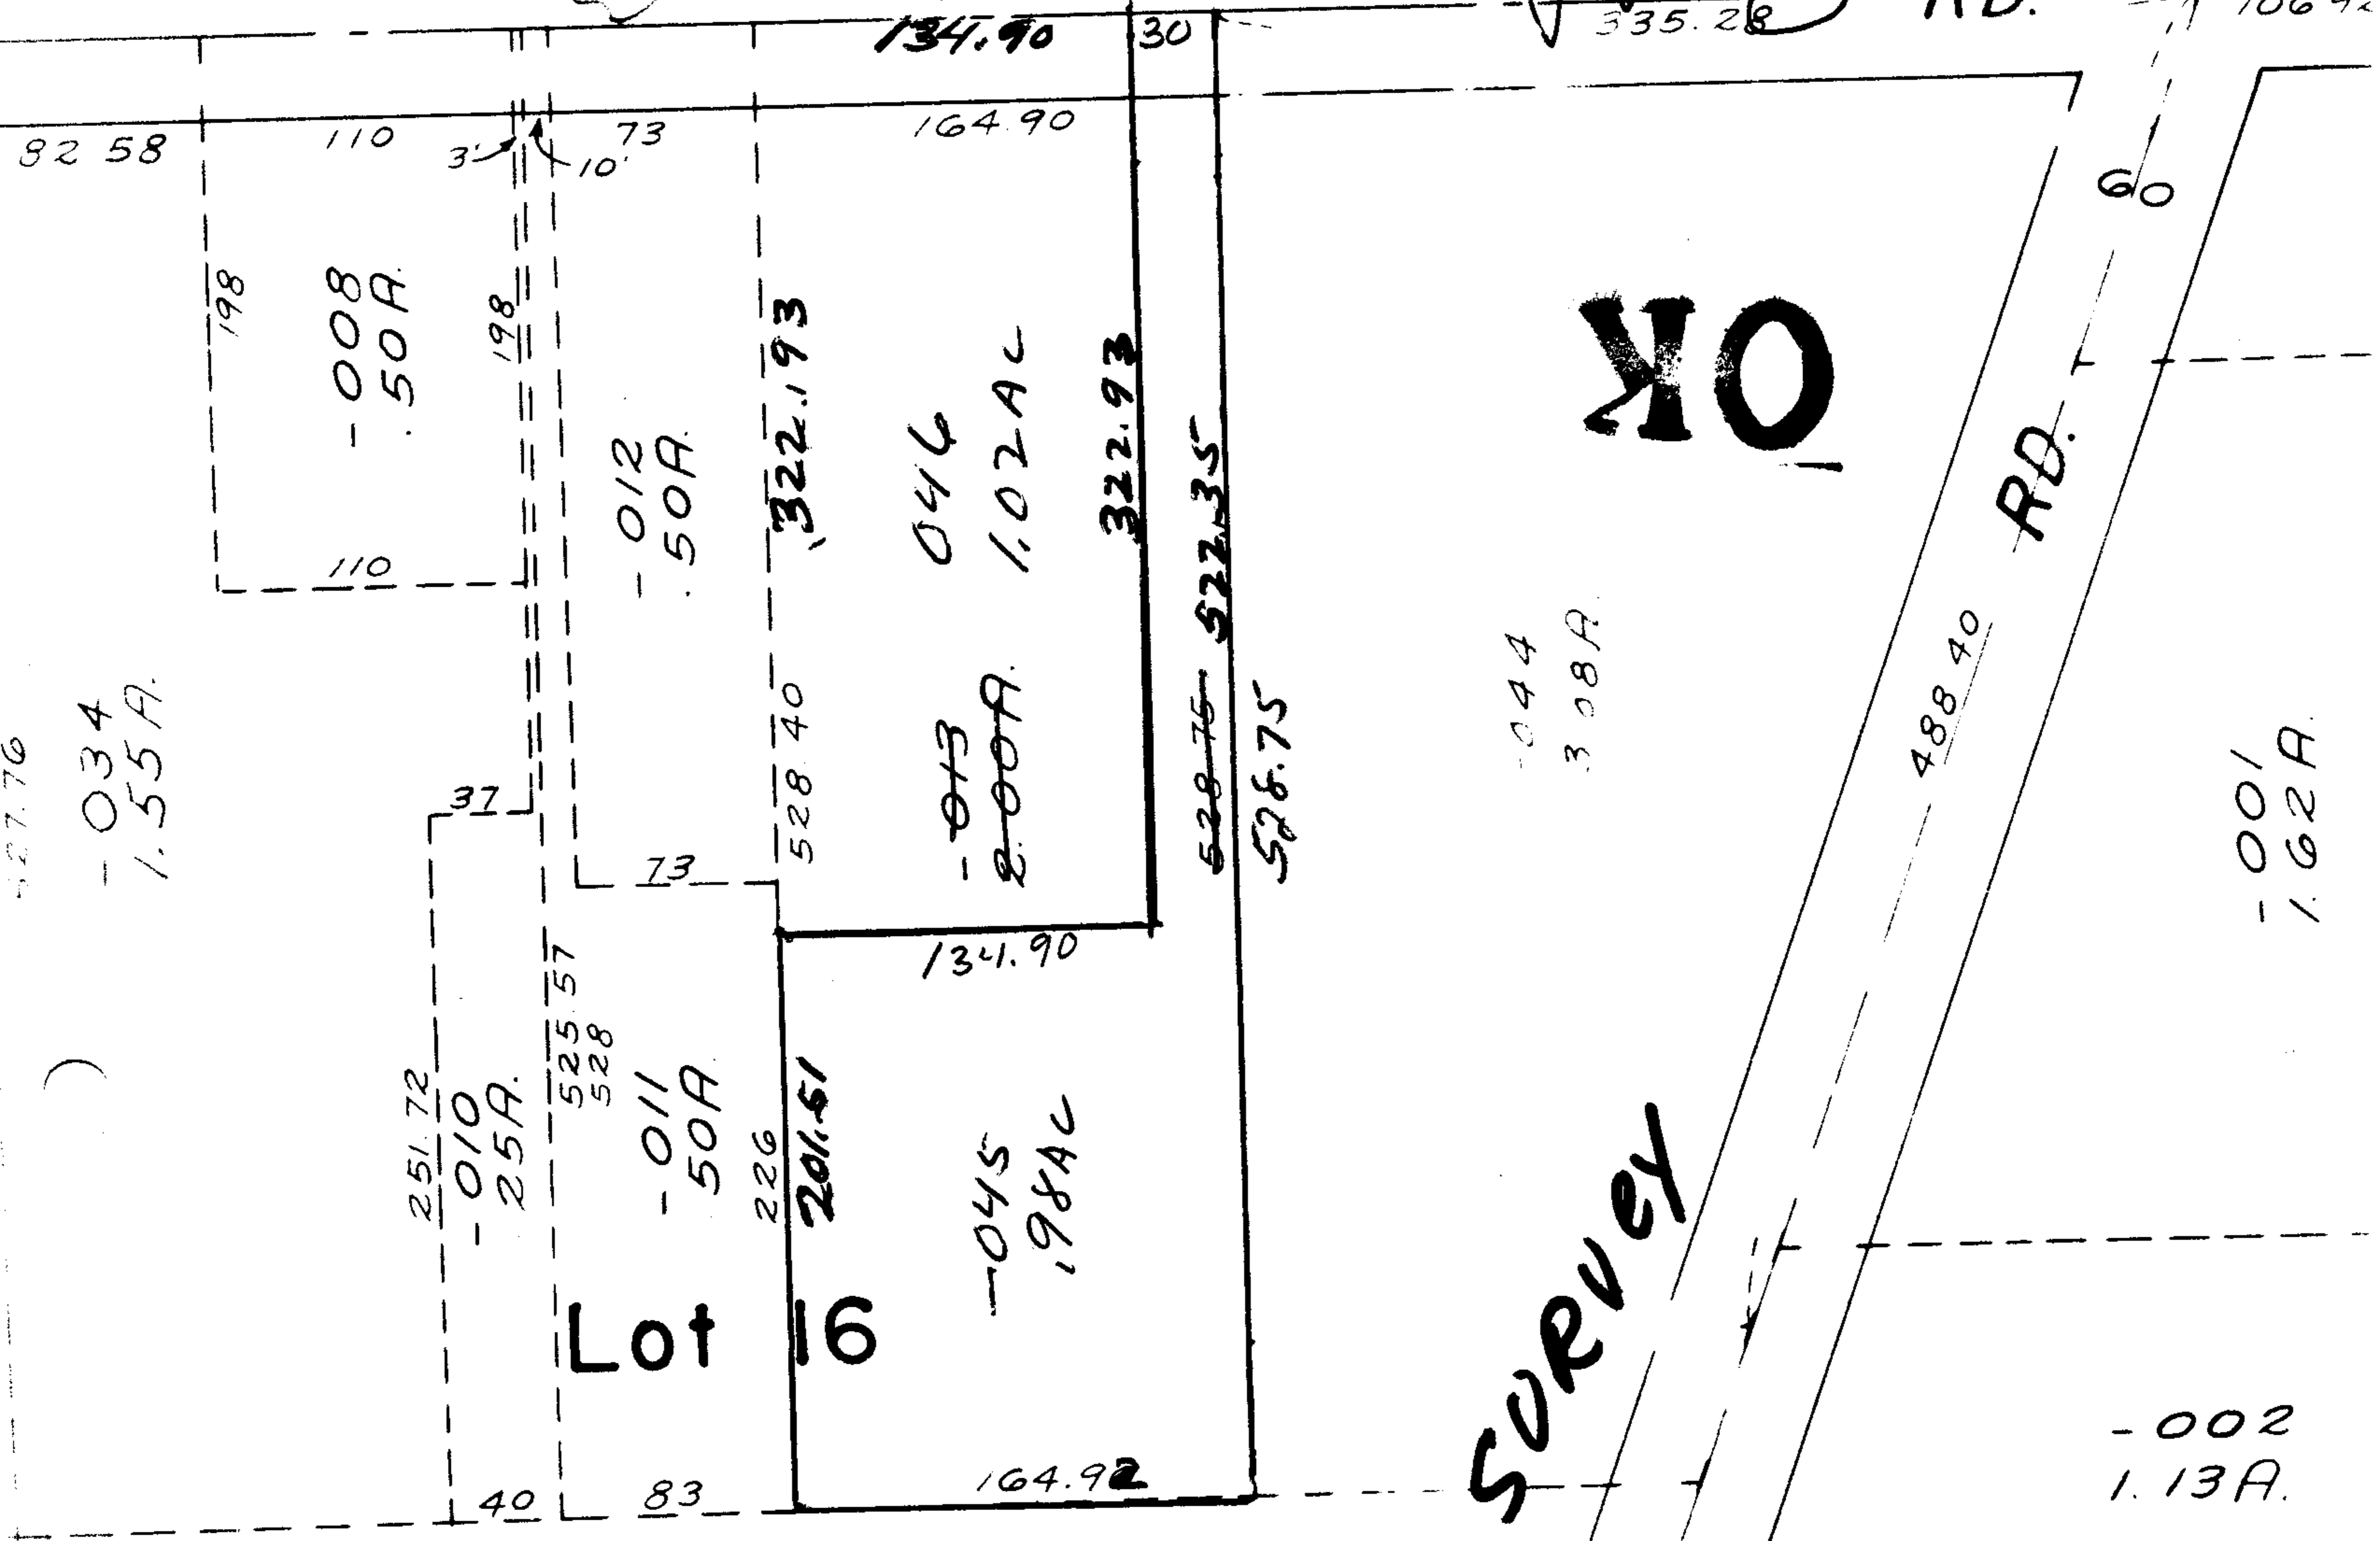

OK

See Survey

7504

APPROVED
LORAIN CO.
MAP DEPT.
DATE 10-30-73
PAGE 12-00-055B
BY L.W. HAN
VOID AFTER

8-8-86

