

OK

Pt 010 1192.52 72 AC

Pt 010 Pt 72 AC


Pt. ~~005~~ 011
Pt. ~~22.00A~~ 21.28 AC

011
Pt. ~~005~~
Pt. ~~22.00A~~
21.28 AC

98-01-8
8.8

10-00-004 E

Pt. -004
Pt. 17.75 A

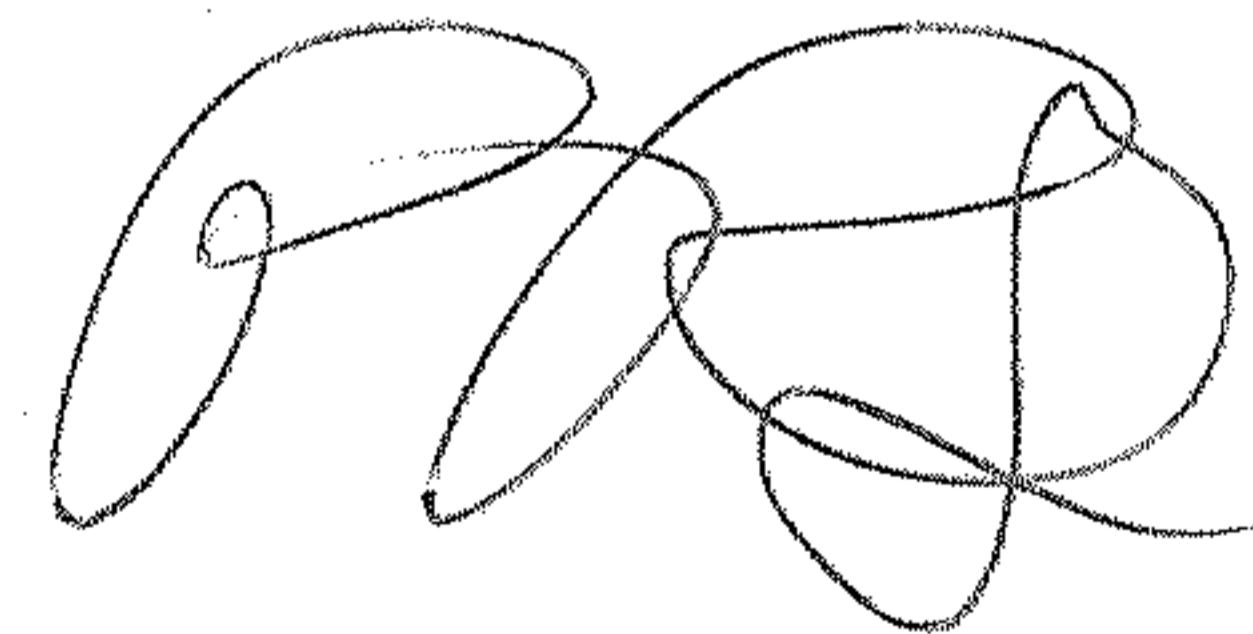

10-00-004 F

Pt. -004
Pt. 17.75 A

540

1440 1440

480 COMM. RES. 69-111 879 98

9-21-69

004-G

879 98

10'