

7507

[Handwritten signature]

-087
180
7.80 A

7507

APPROVED
LORAIN CO.
MAP DEPT.

DATE 11-31-73


PAGE 2-01-008B

BY *[Handwritten signature]*

VOID
AFTER

S. S.
8-12-86

OK

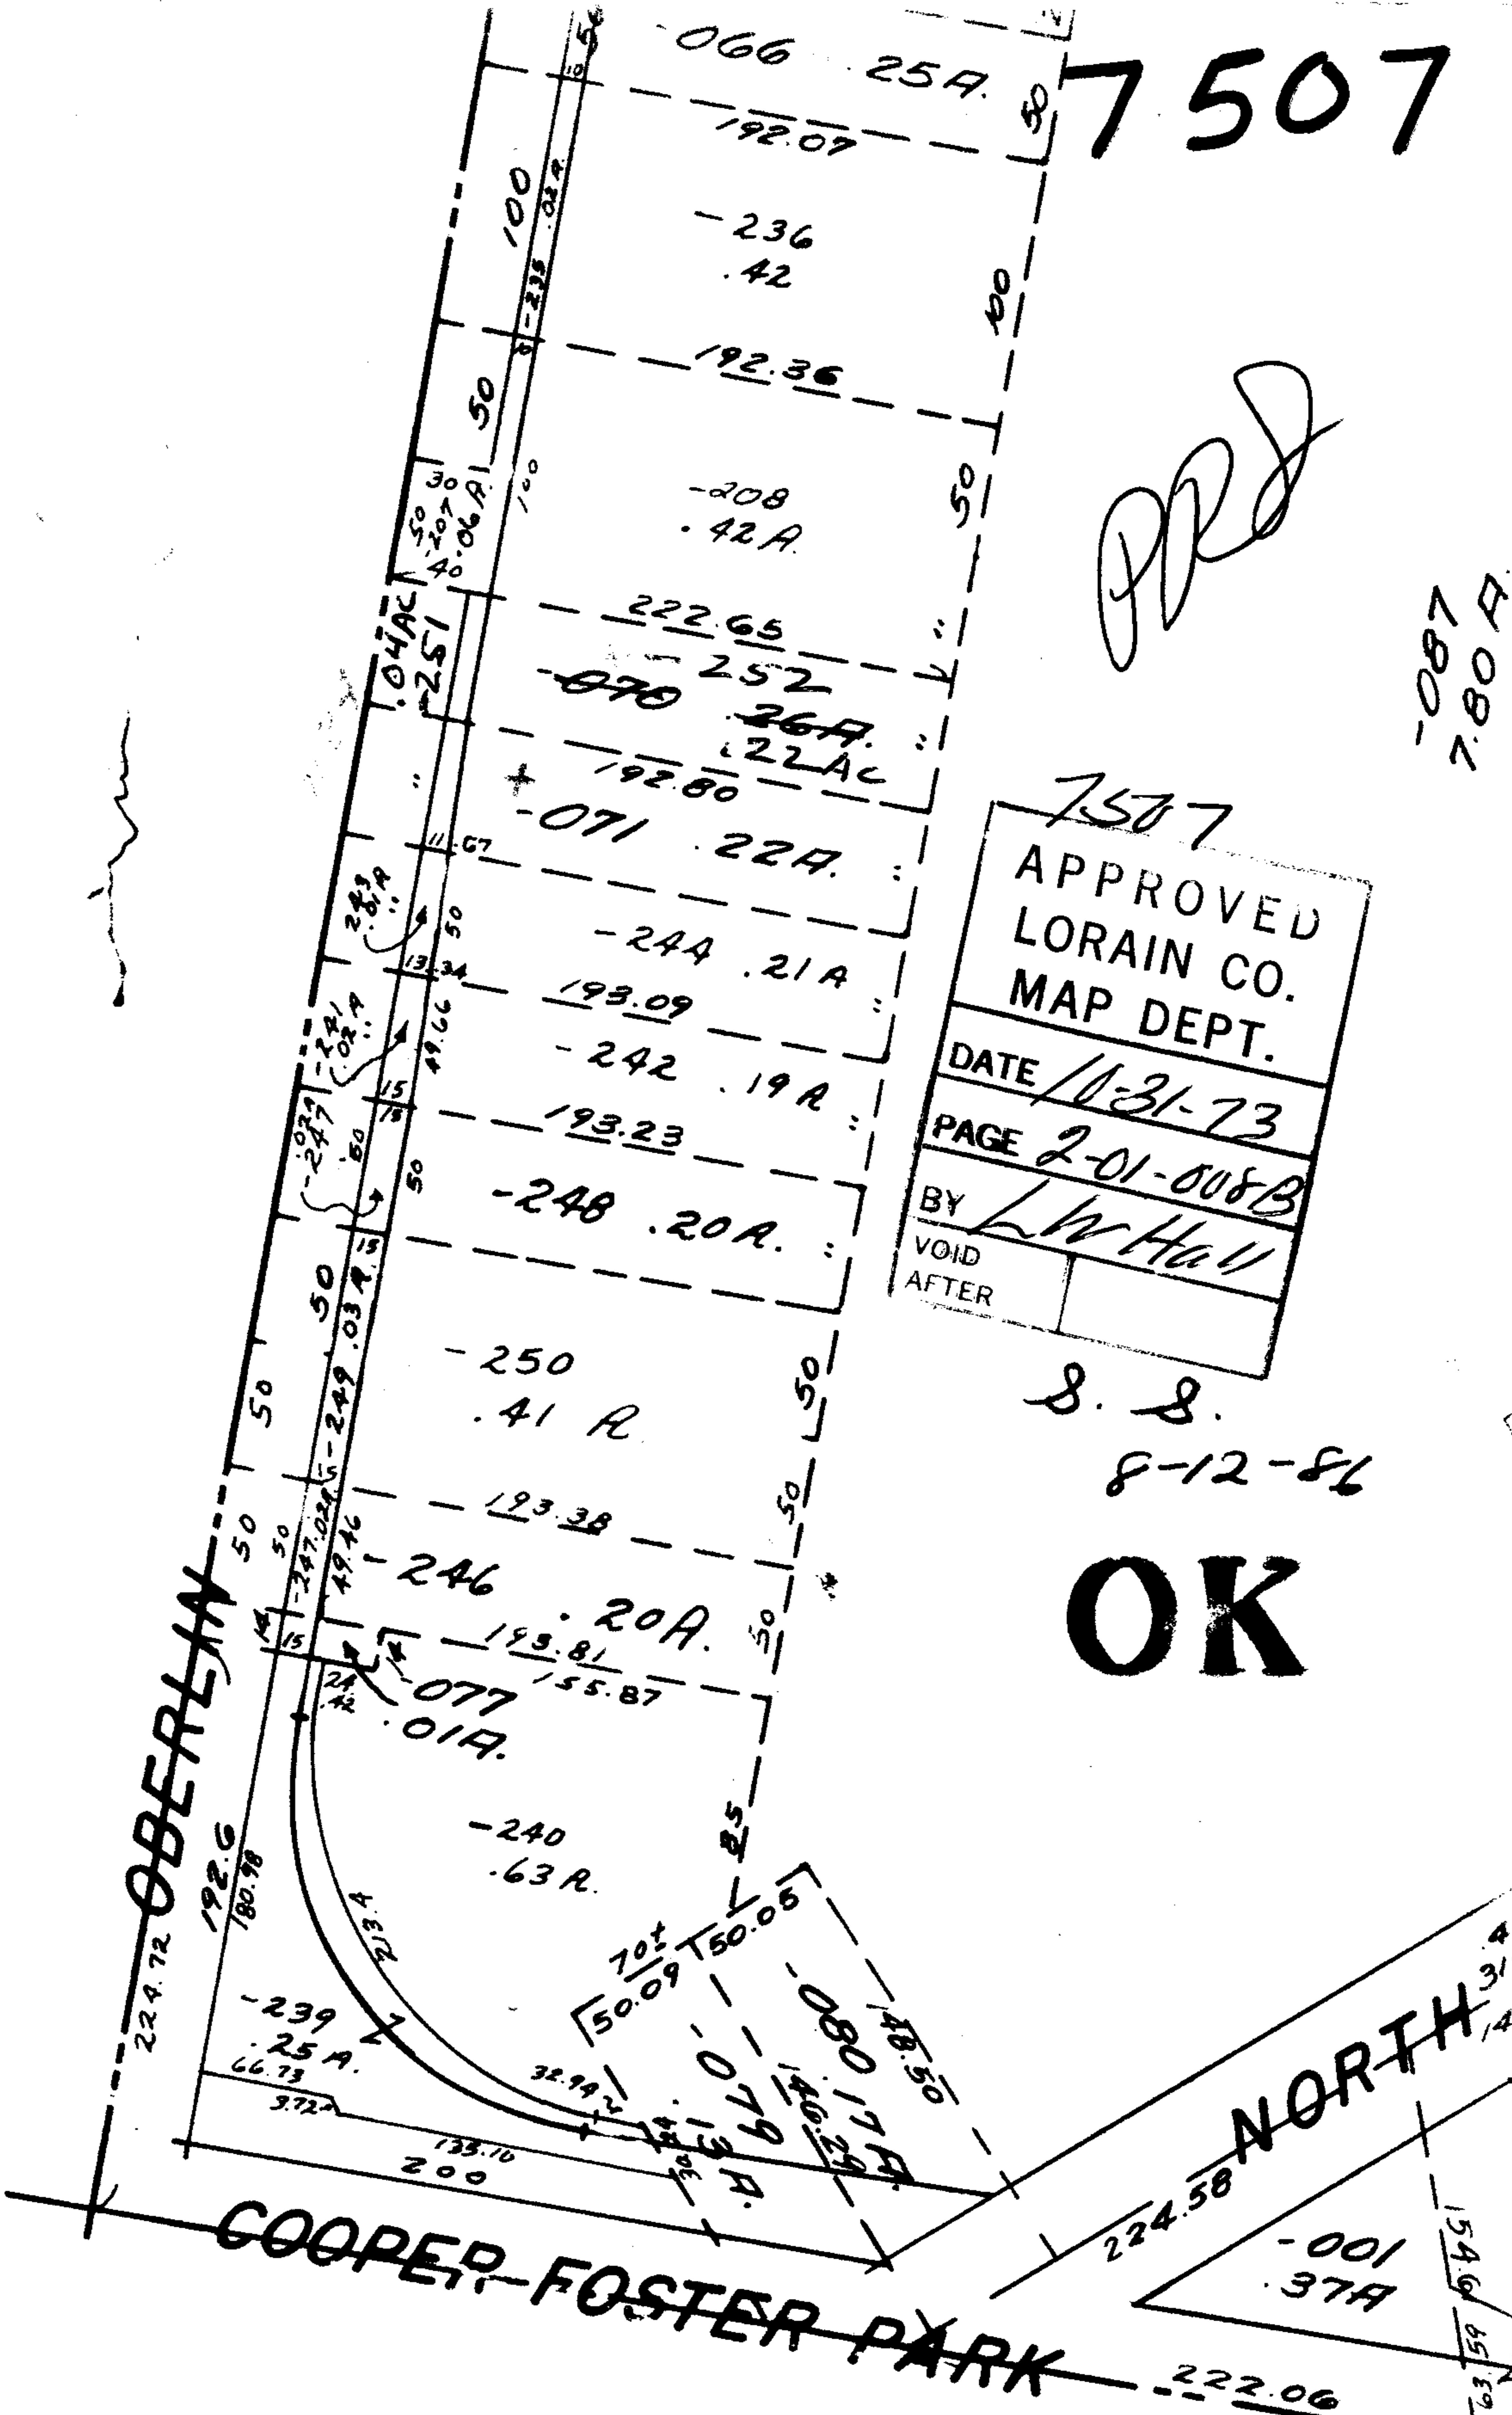

BLACK RIVER T.

SCALE: 1" = 100'