


7514

NO

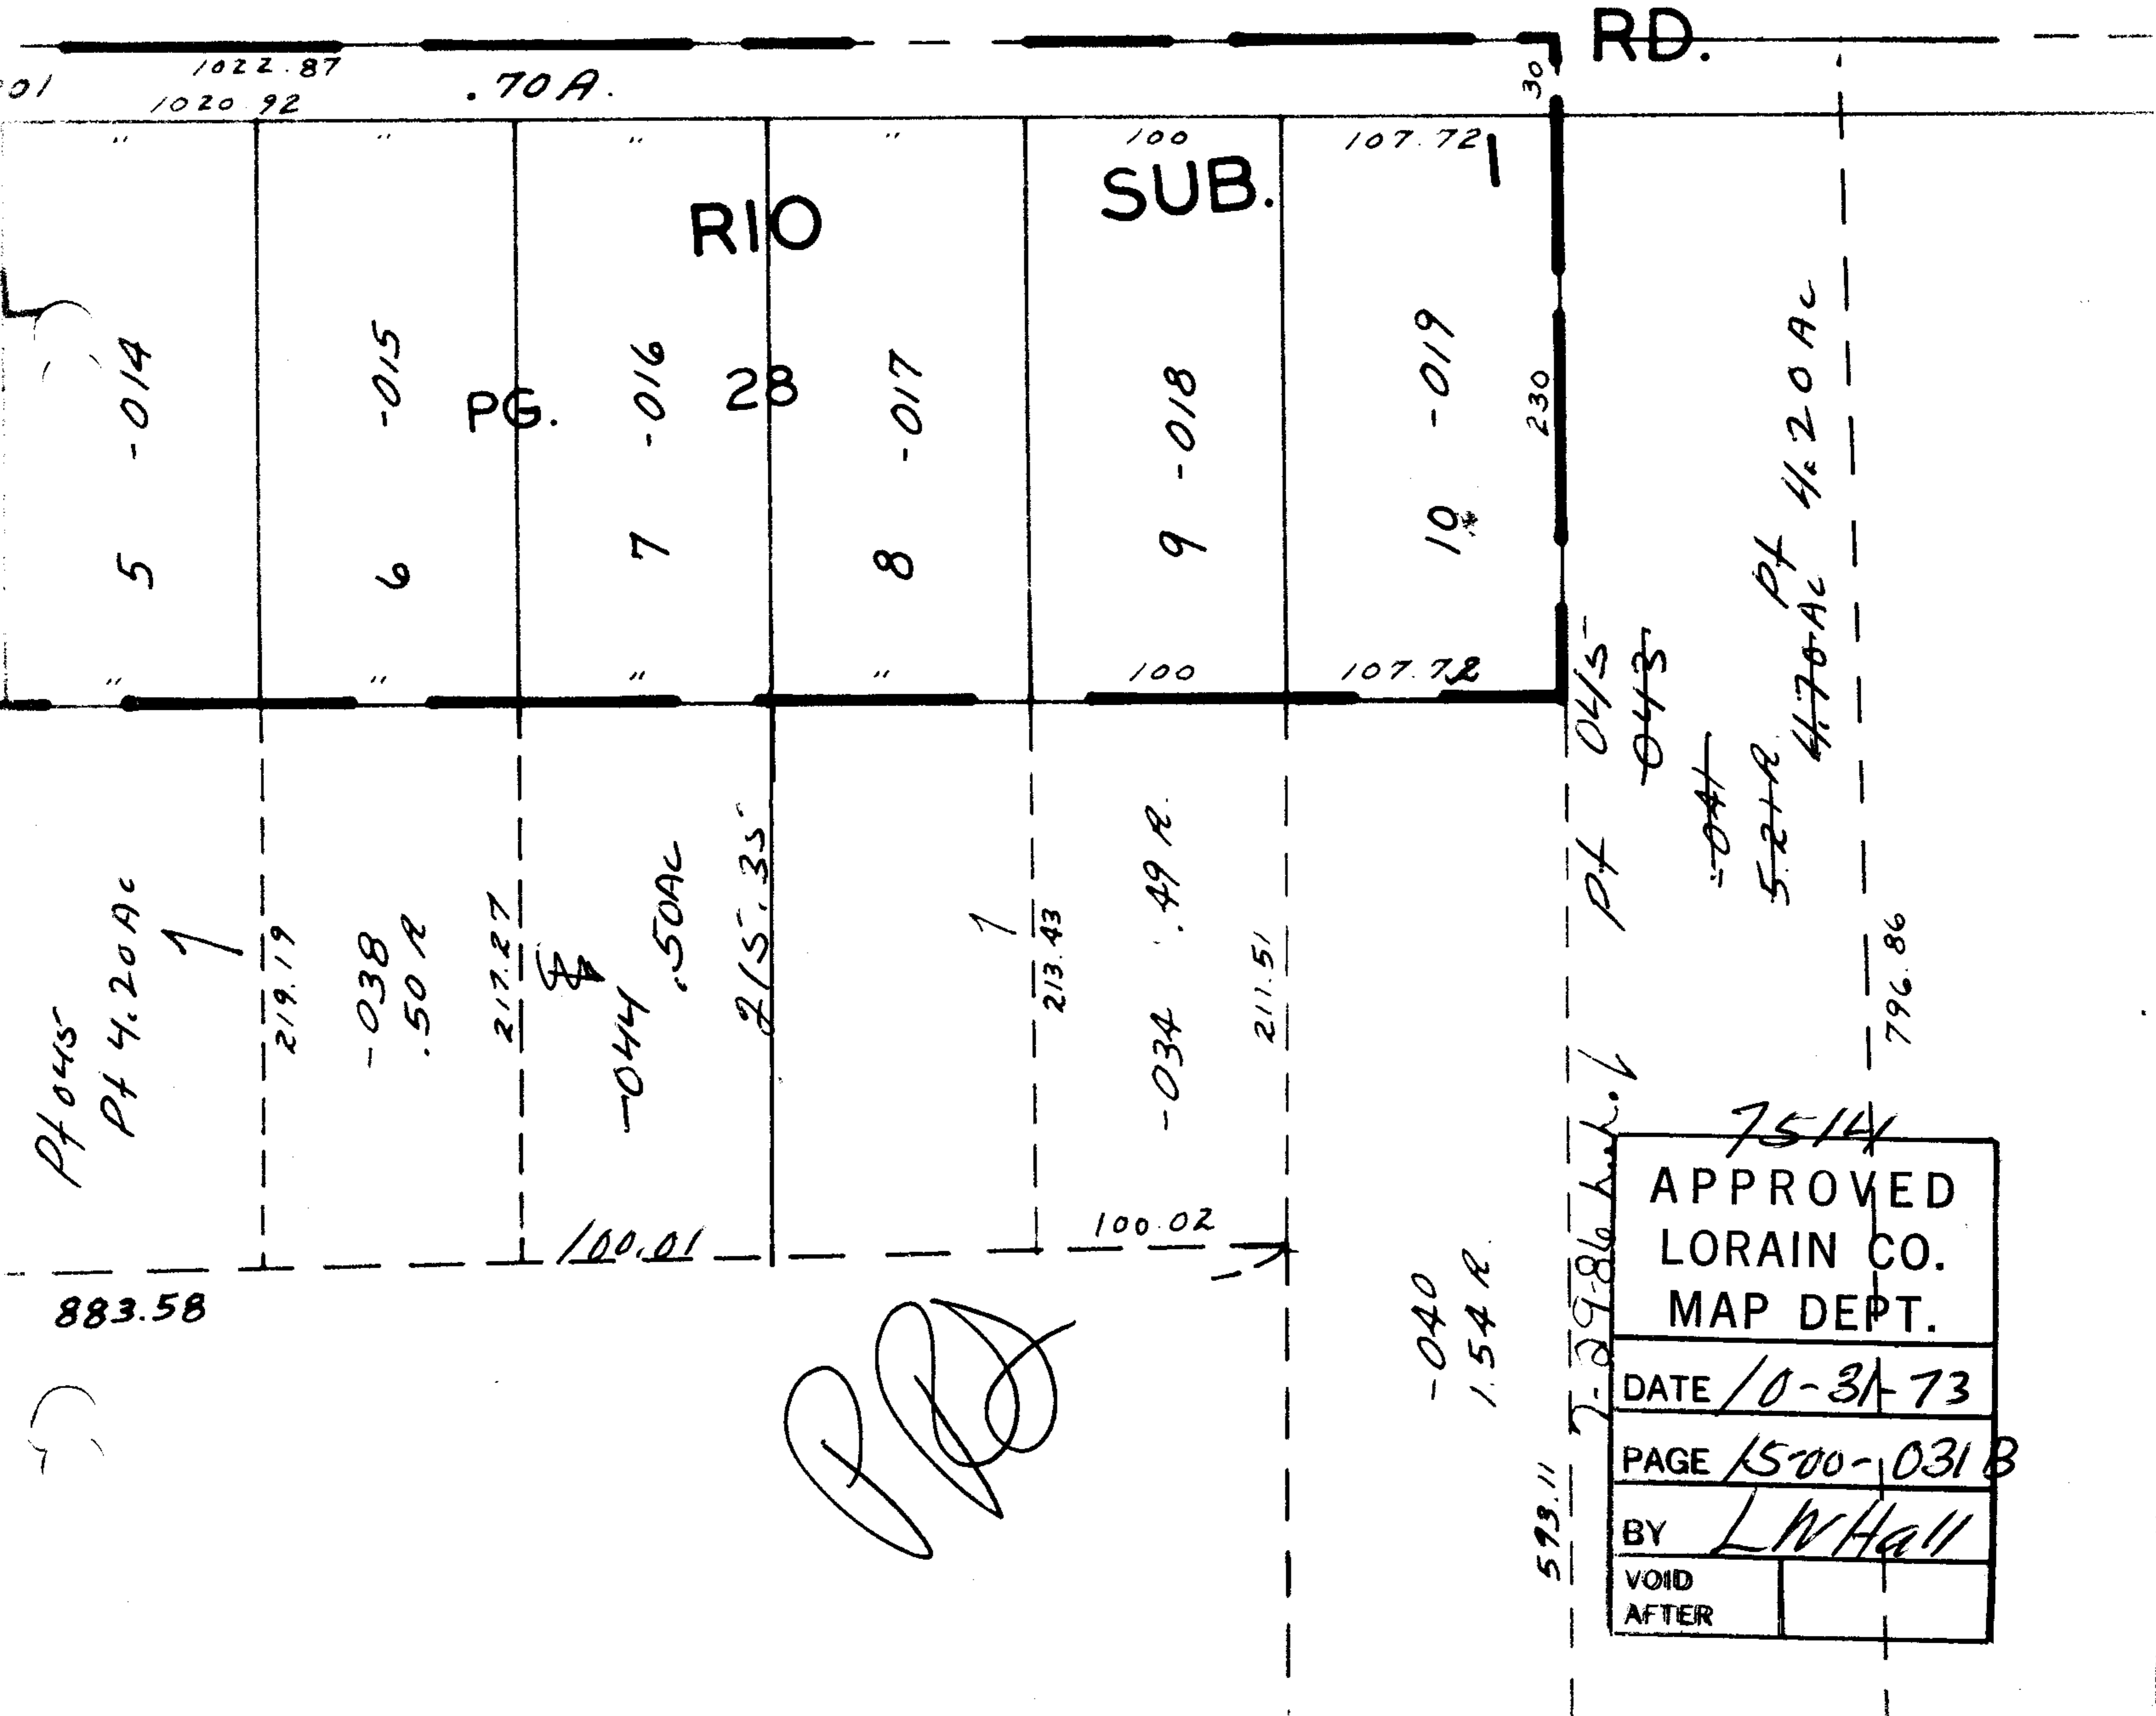

RD.

.70A.

RIO

SUB.

7514

APPROVED LORAIN CO. MAP DEPT.	
DATE /10-31-73	
PAGE /500-031 B	
BY LWHall	
VOID AFTER	