


7527

7527

SEE 7-00

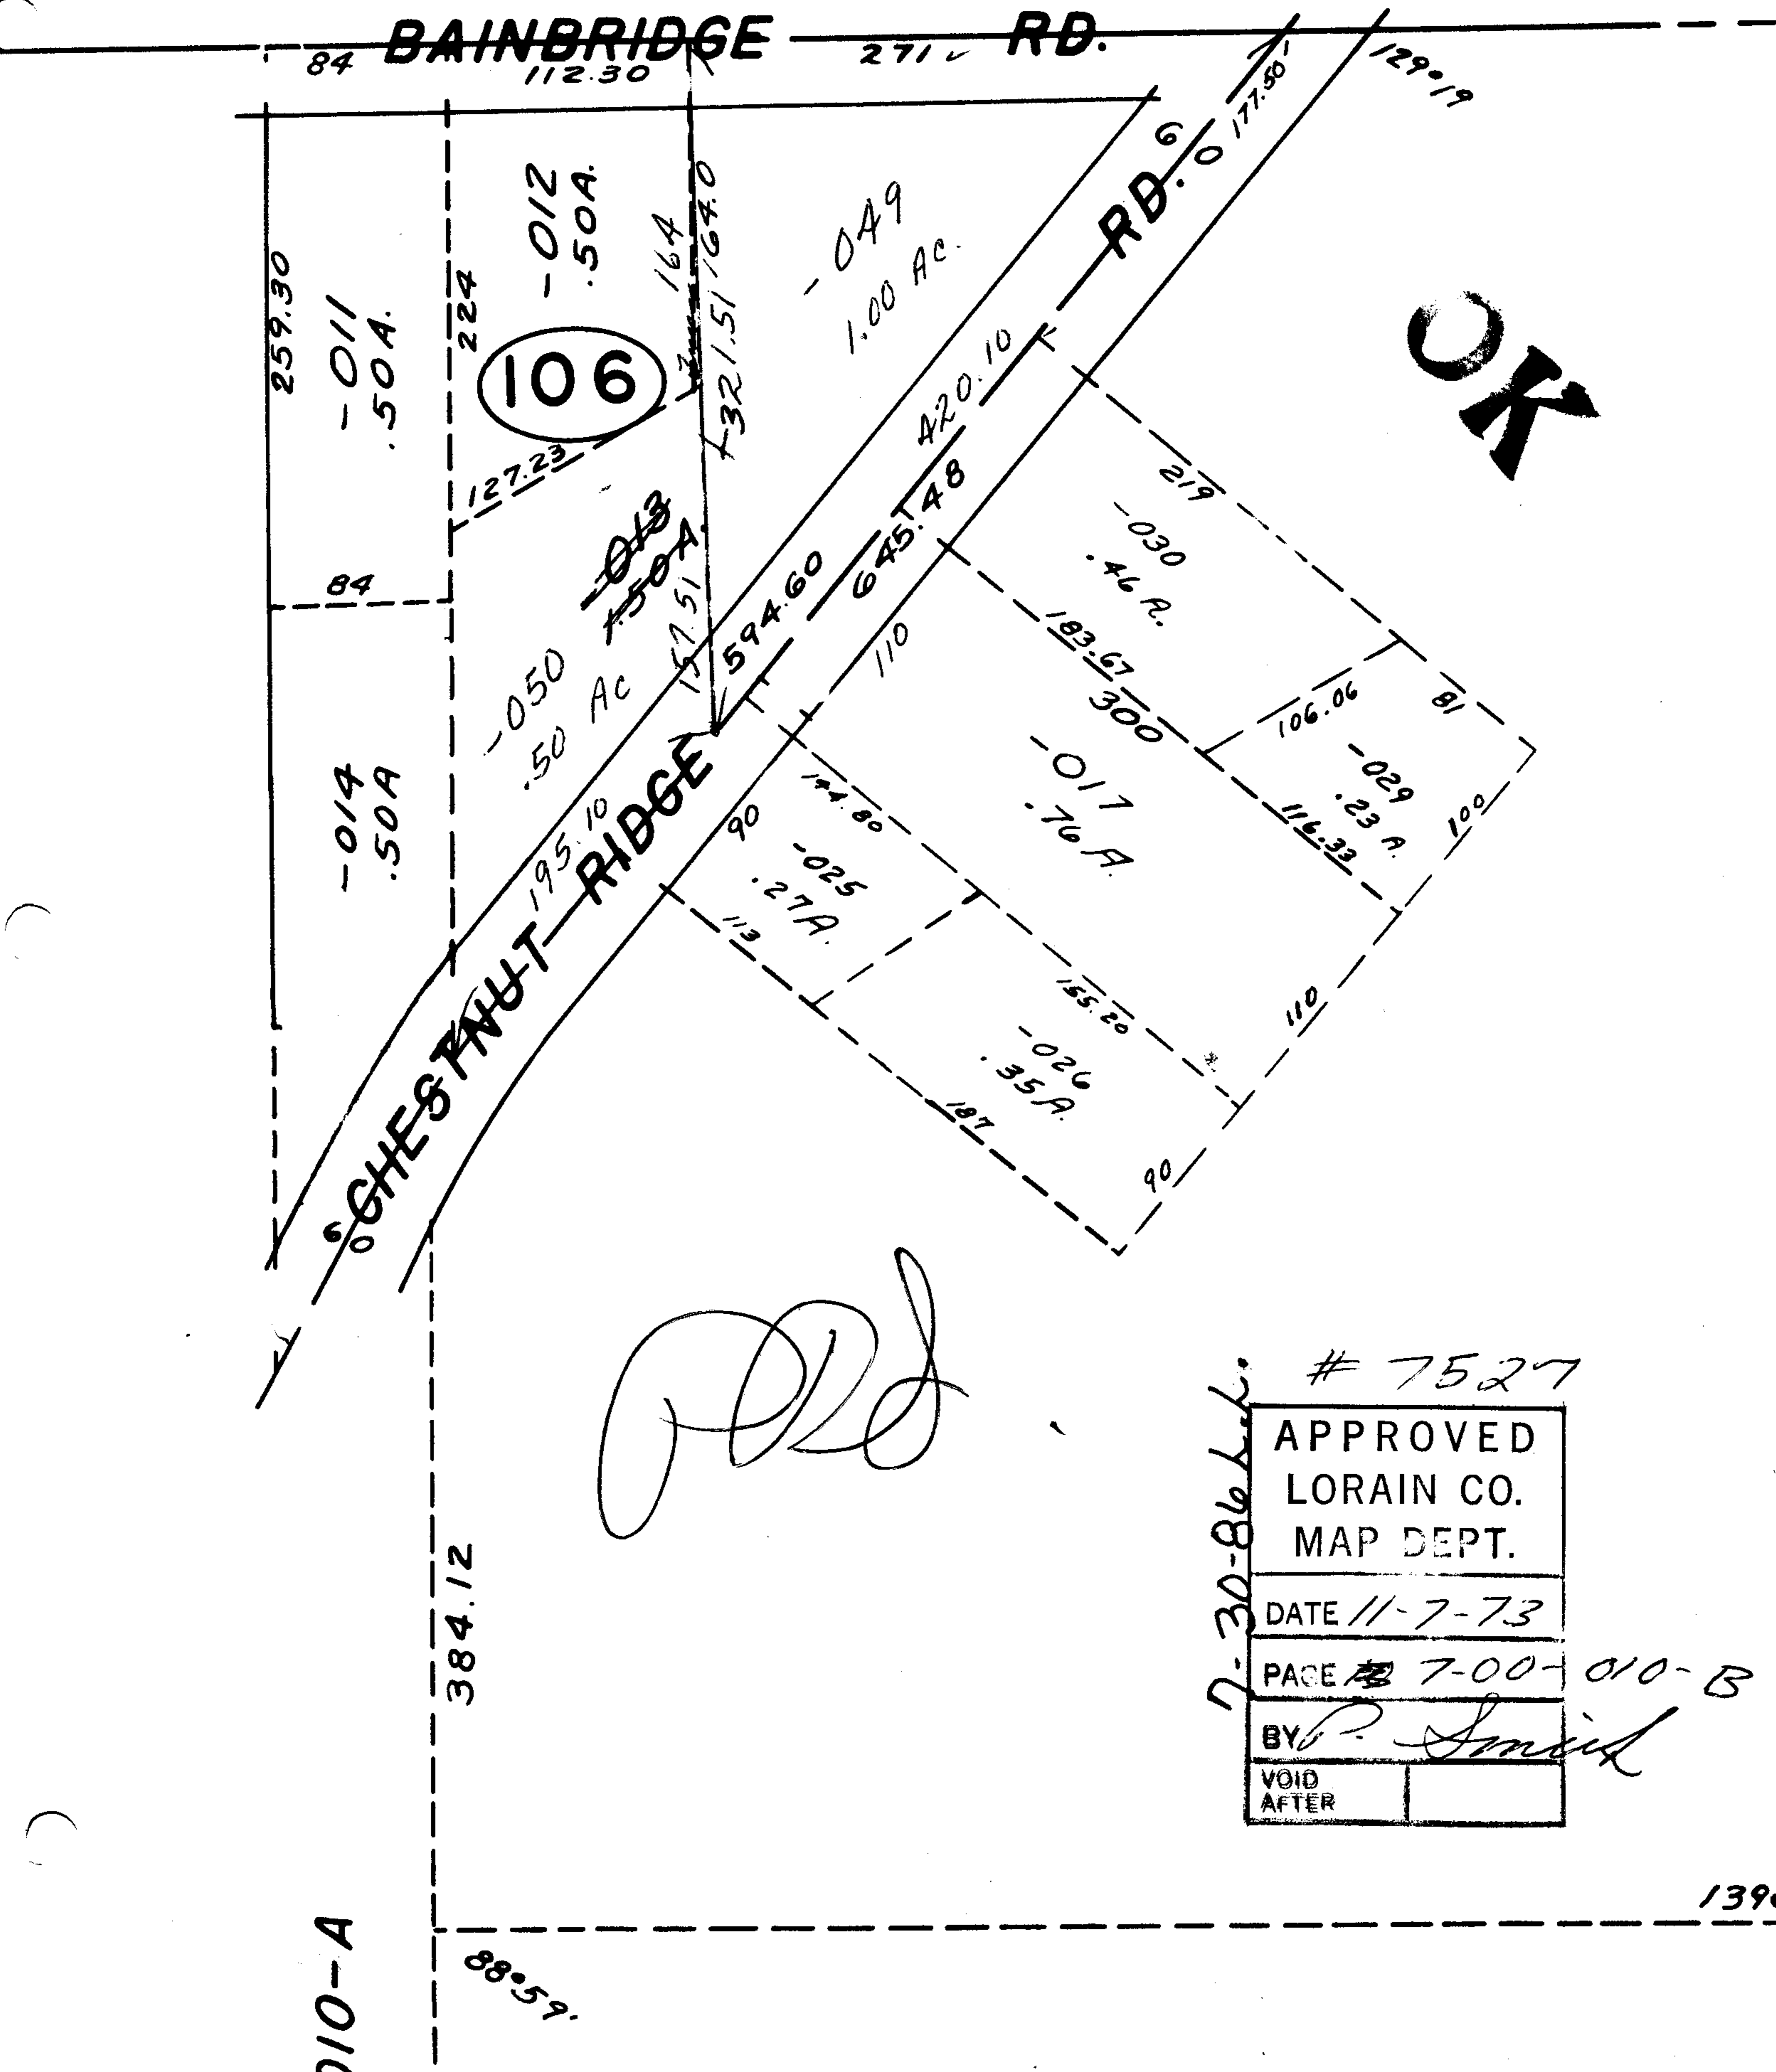

OK

[Handwritten Signature]

7527

| | |
|-------------------------------------|--|
| APPROVED LORAIN CO. MAP DEPT. | |
| DATE 11-7-73 | |
| PAGE 7-00-010-B | |
| BY <i>[Signature]</i> | |
| VOID AFTER | |

7-30-86

D10-A

1390