


SEE 15-D

7528

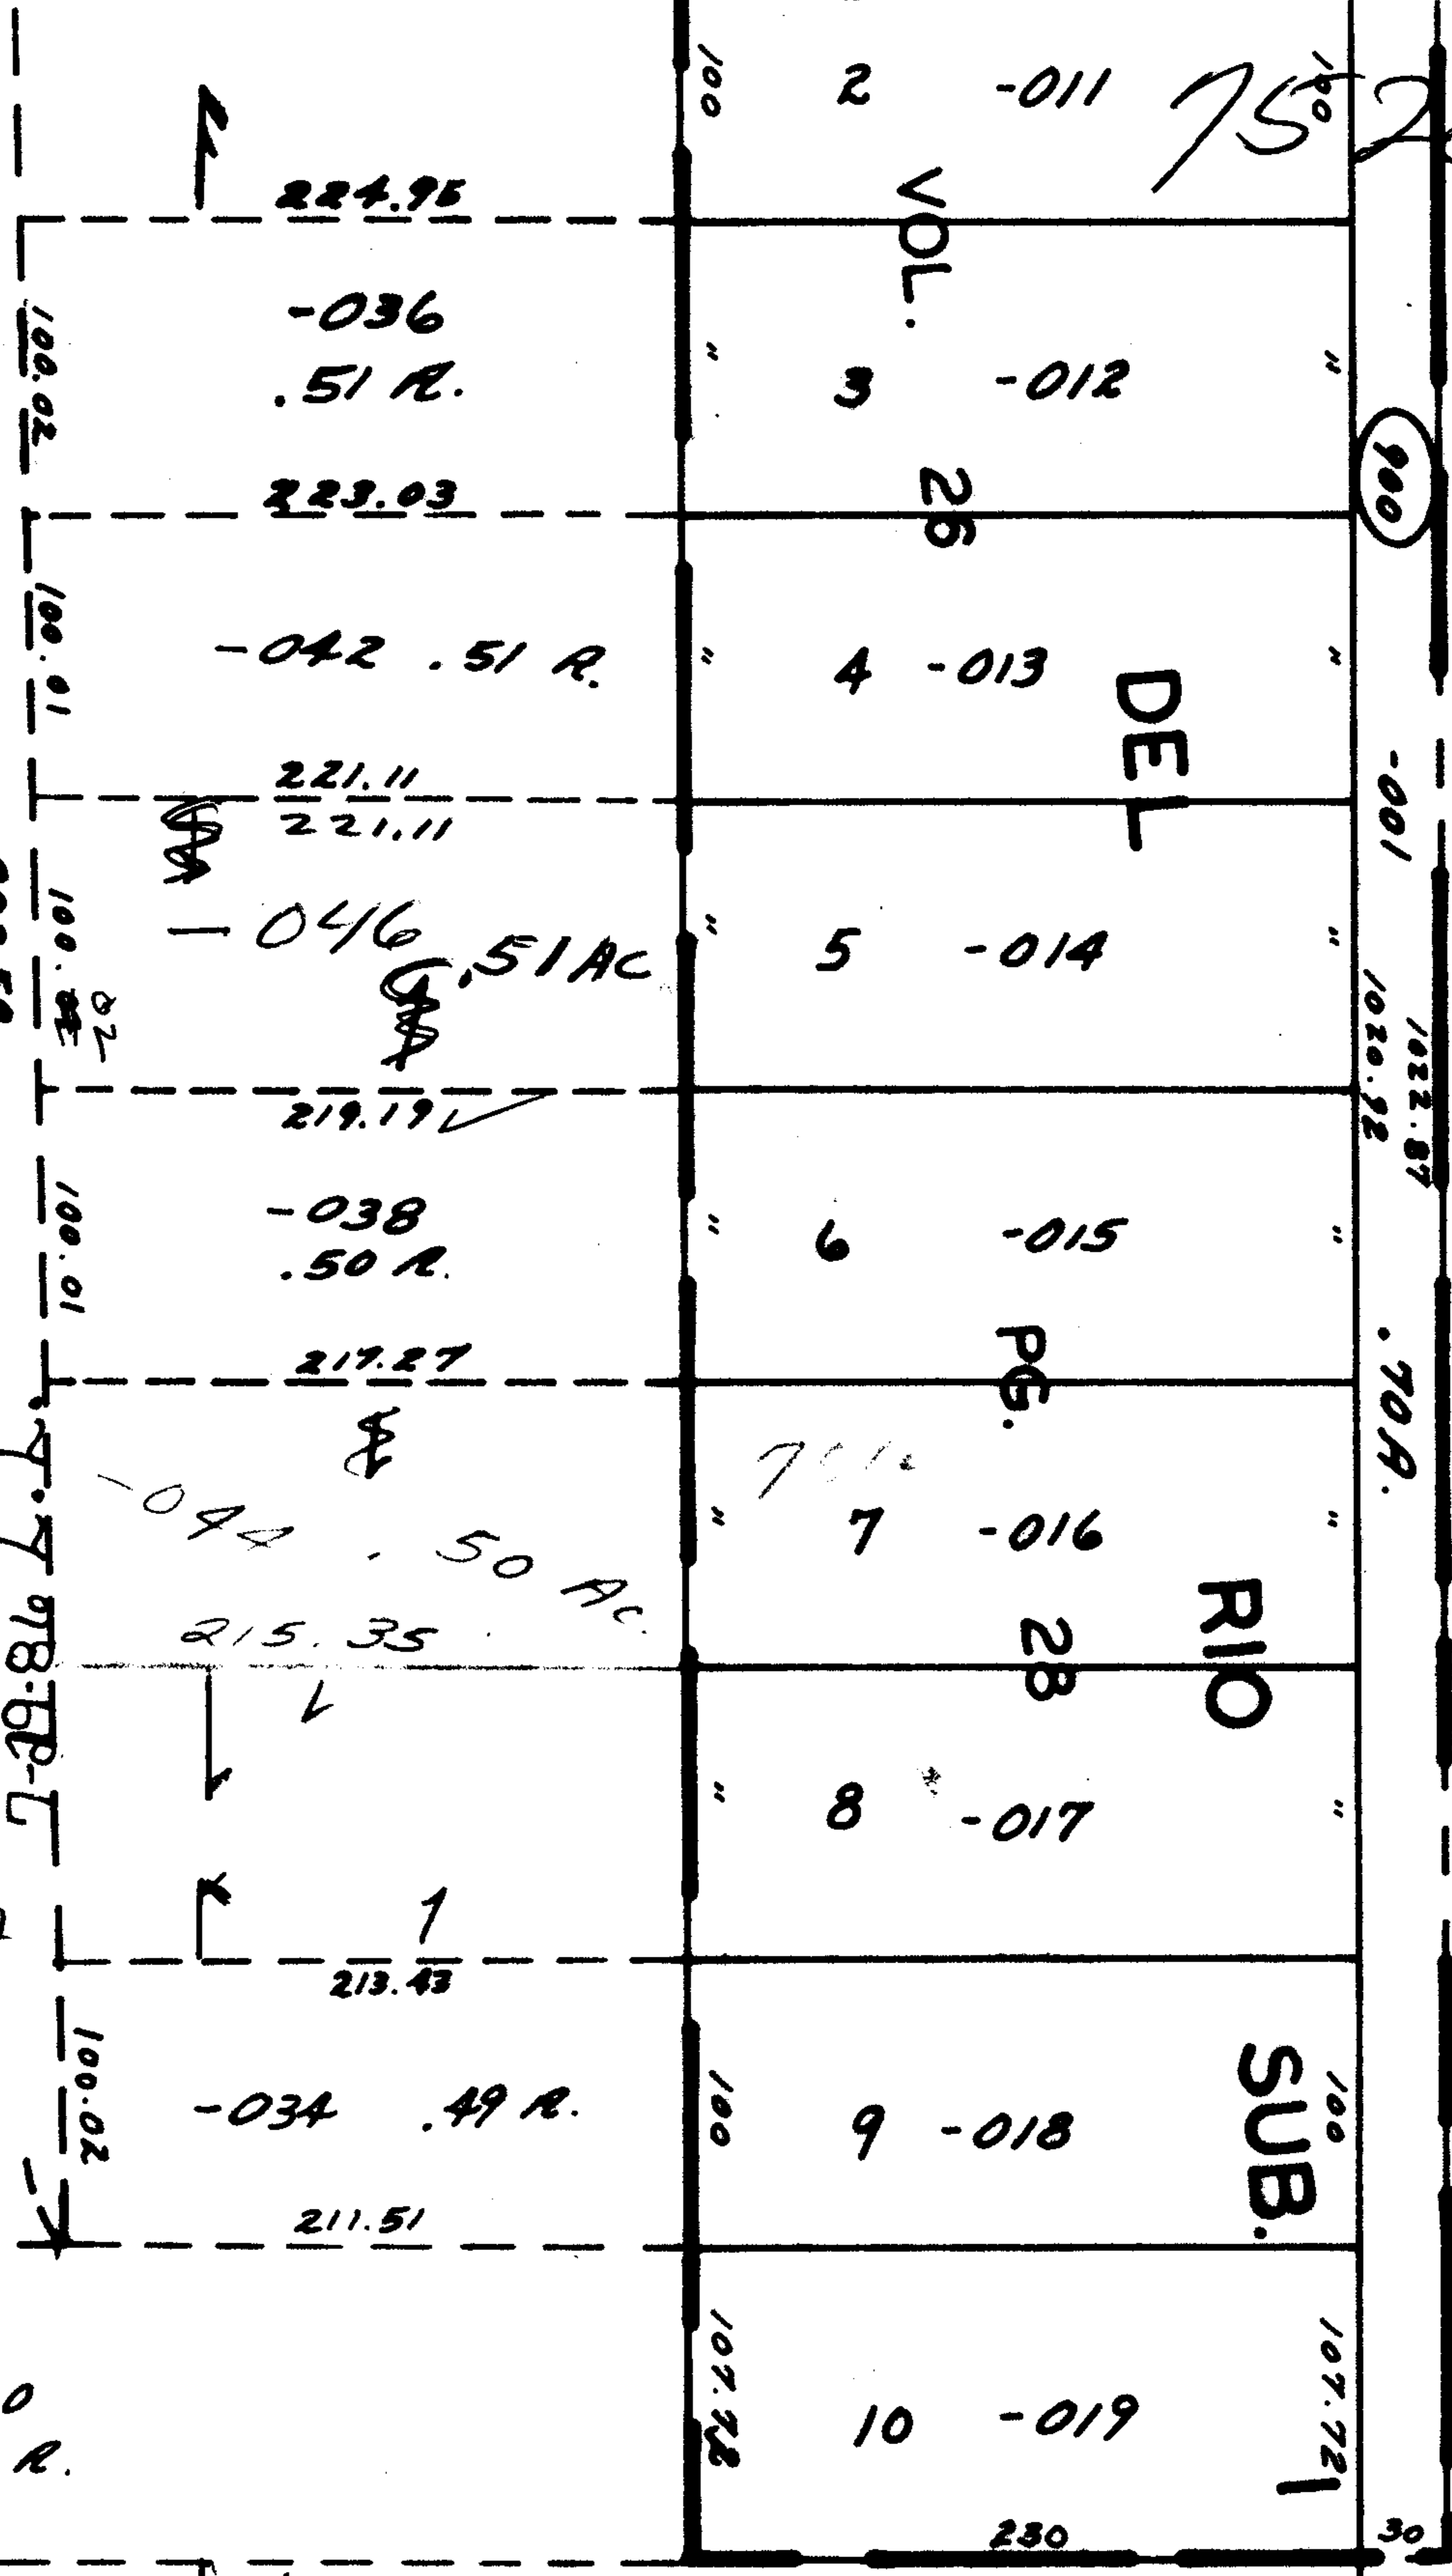

7528

APPROVED
LORAIN CO.
MAP DEPT.
DATE 11-7-73
PAGE 15-00-031A
BY LWH
VOID AFTER

047
3.69 AC

045
4.70 AC

796.86

PR

PR

O

7112