


OK

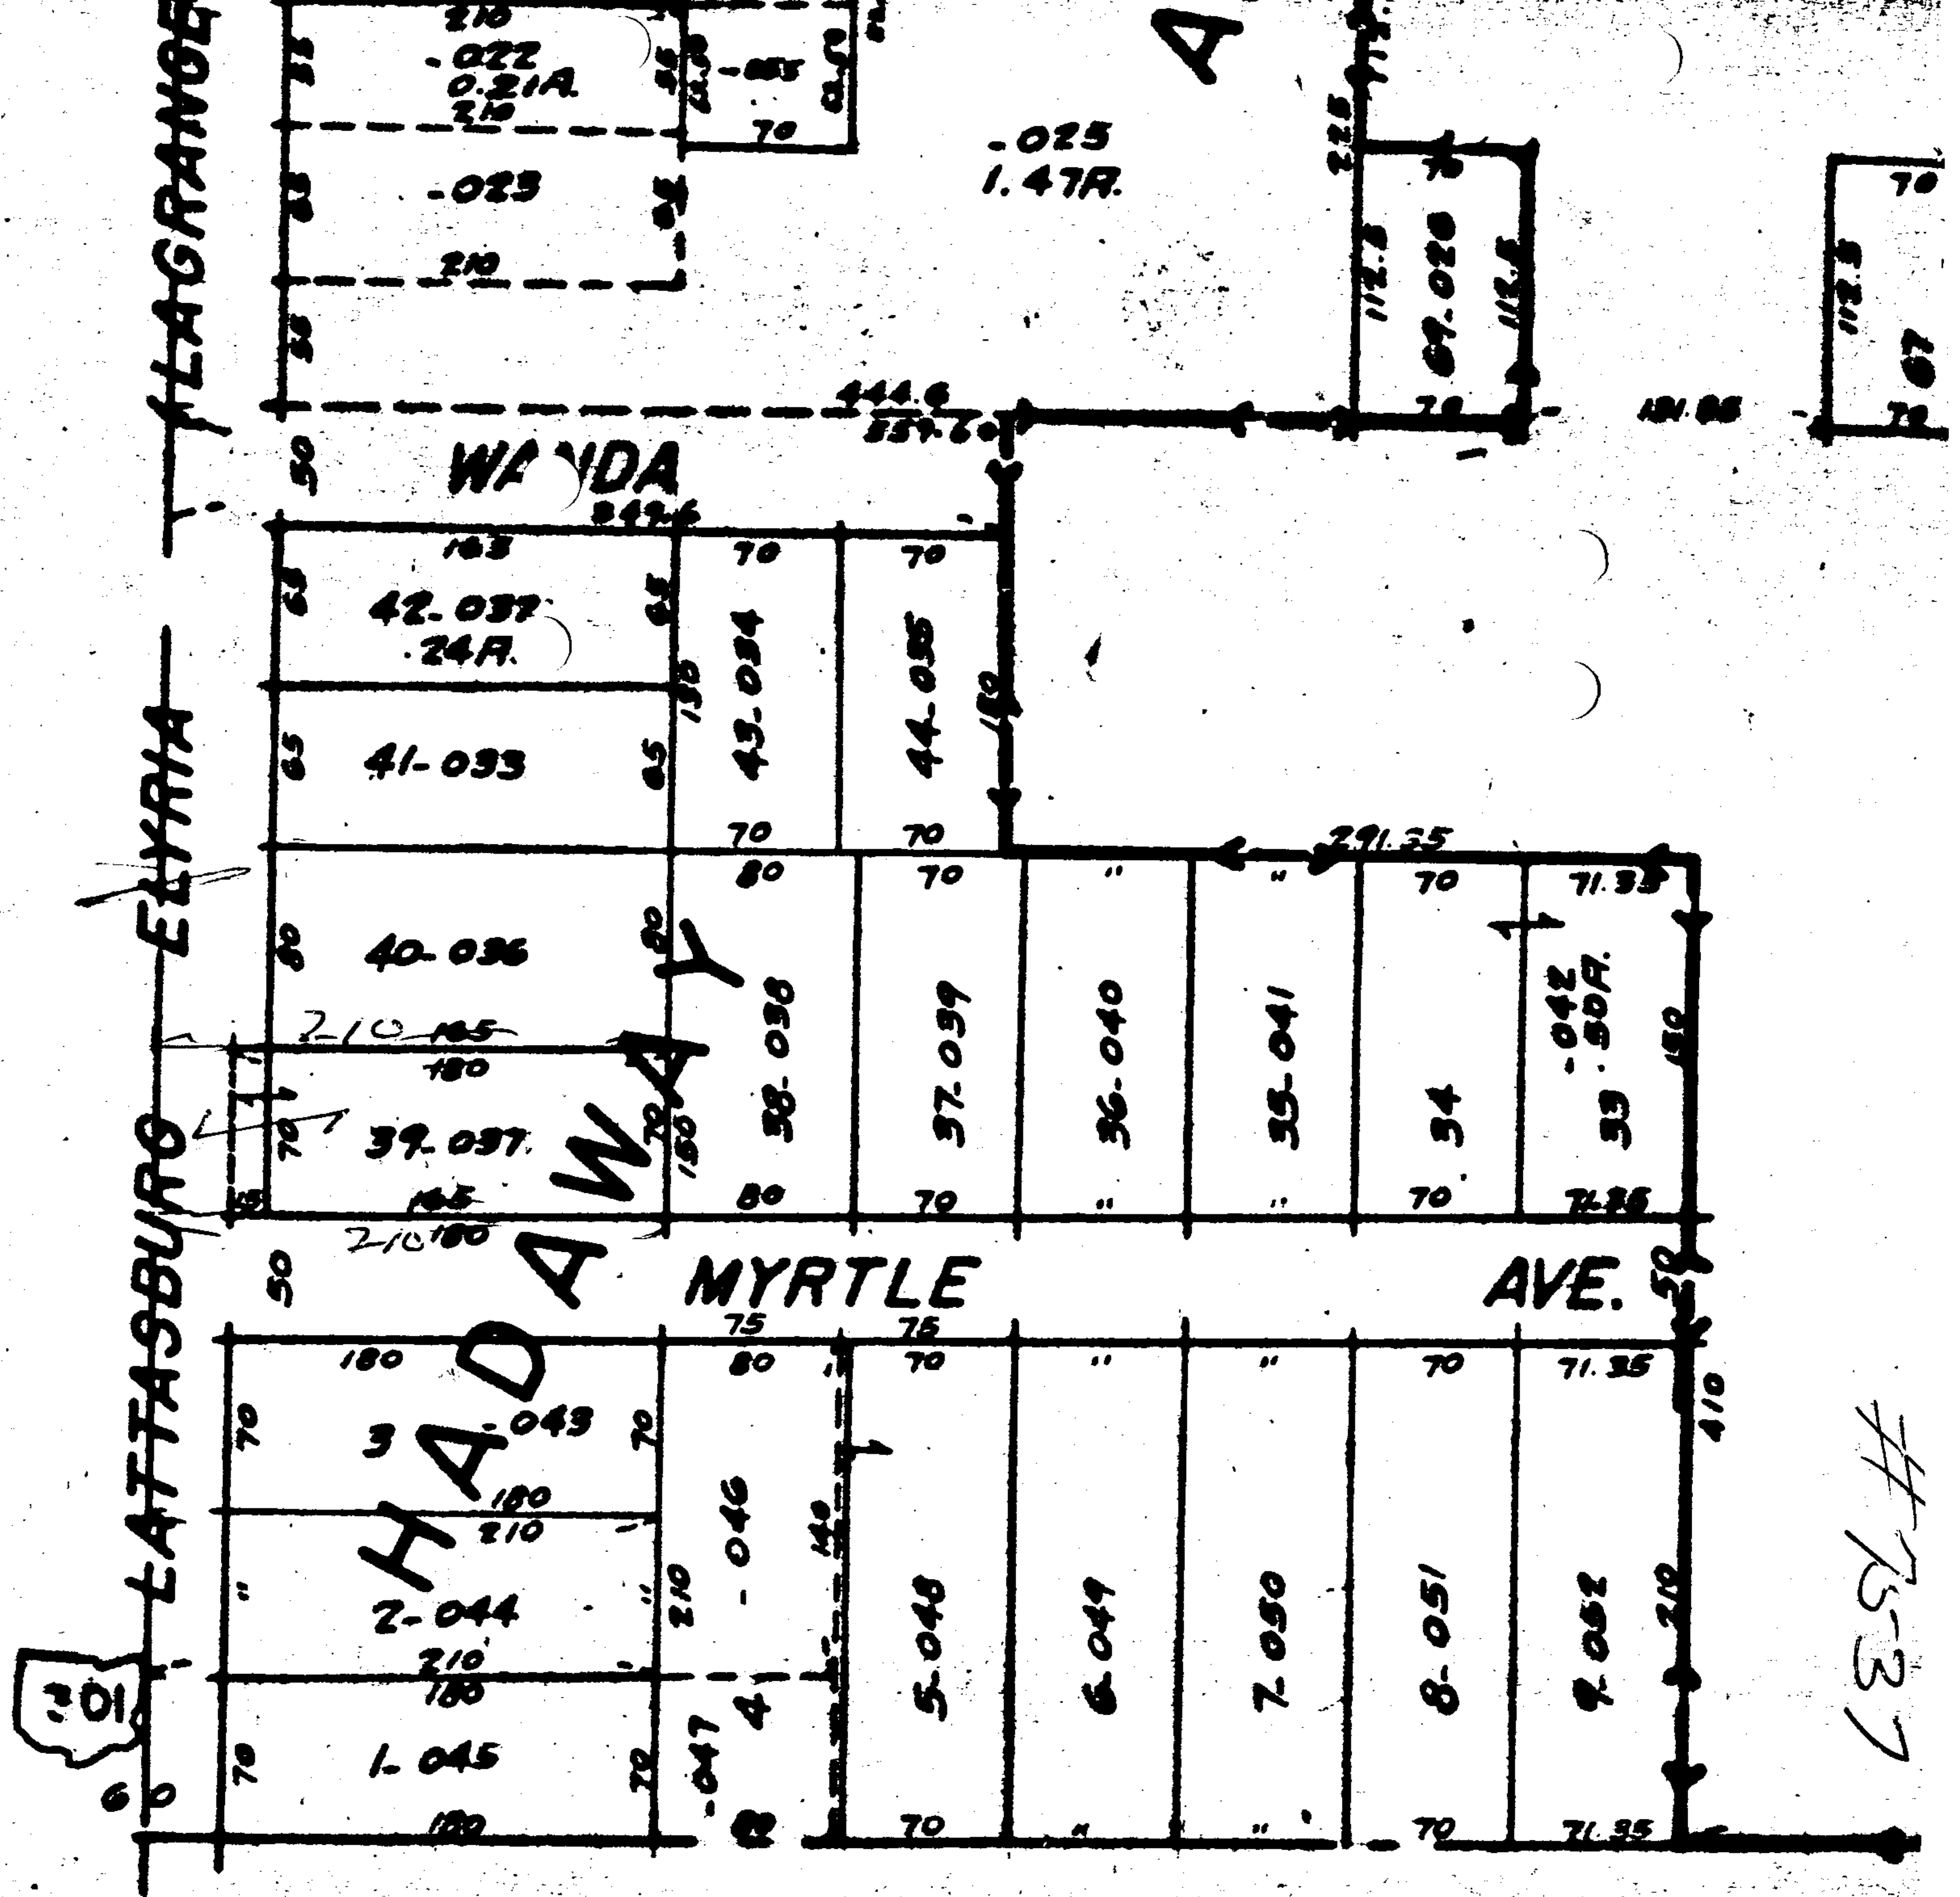

10

#75-37

SEE