


BANKS

RD.

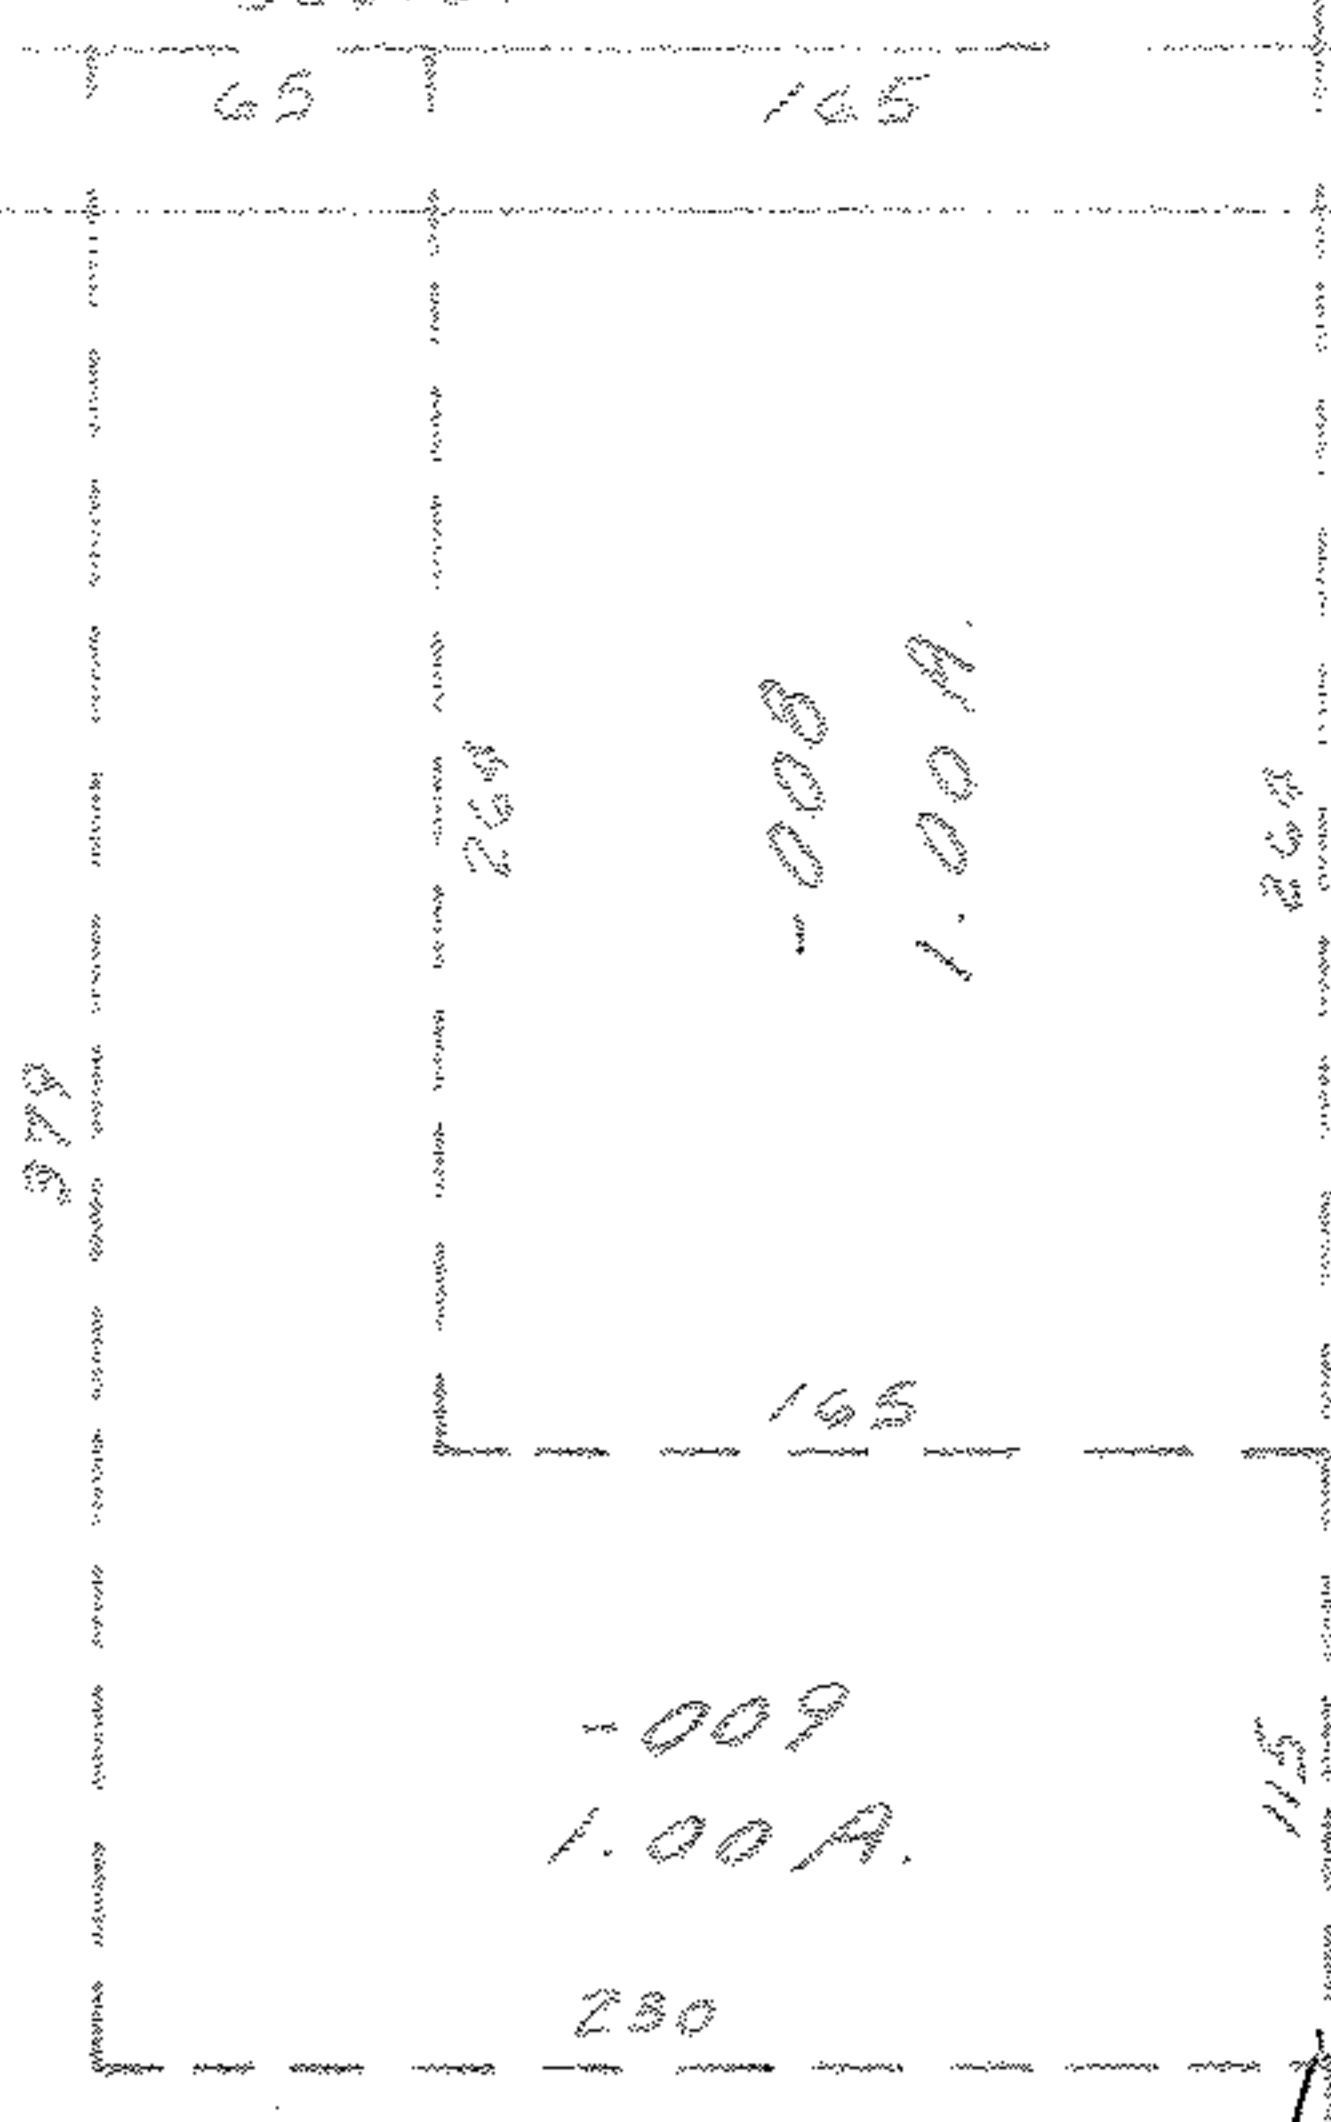

-059
25.11 AC

PT. ~~007~~
PT. ~~55 H.A.~~

[Handwritten signature]

S.B. 8-13-86
OK

10-00-024A

PT. 058
PT. 30.00 A

1354

PL 058
PT. 30.00 AE
PT. ~~007~~
PT. ~~55 H.A.~~

OK
[Handwritten signature]

974.36

OK

-013
20.00 A.

027.63
825

10-00-024E

SEE 10-G

SEE 10-00-024-F

1051.66
1050

1057.90