


7599

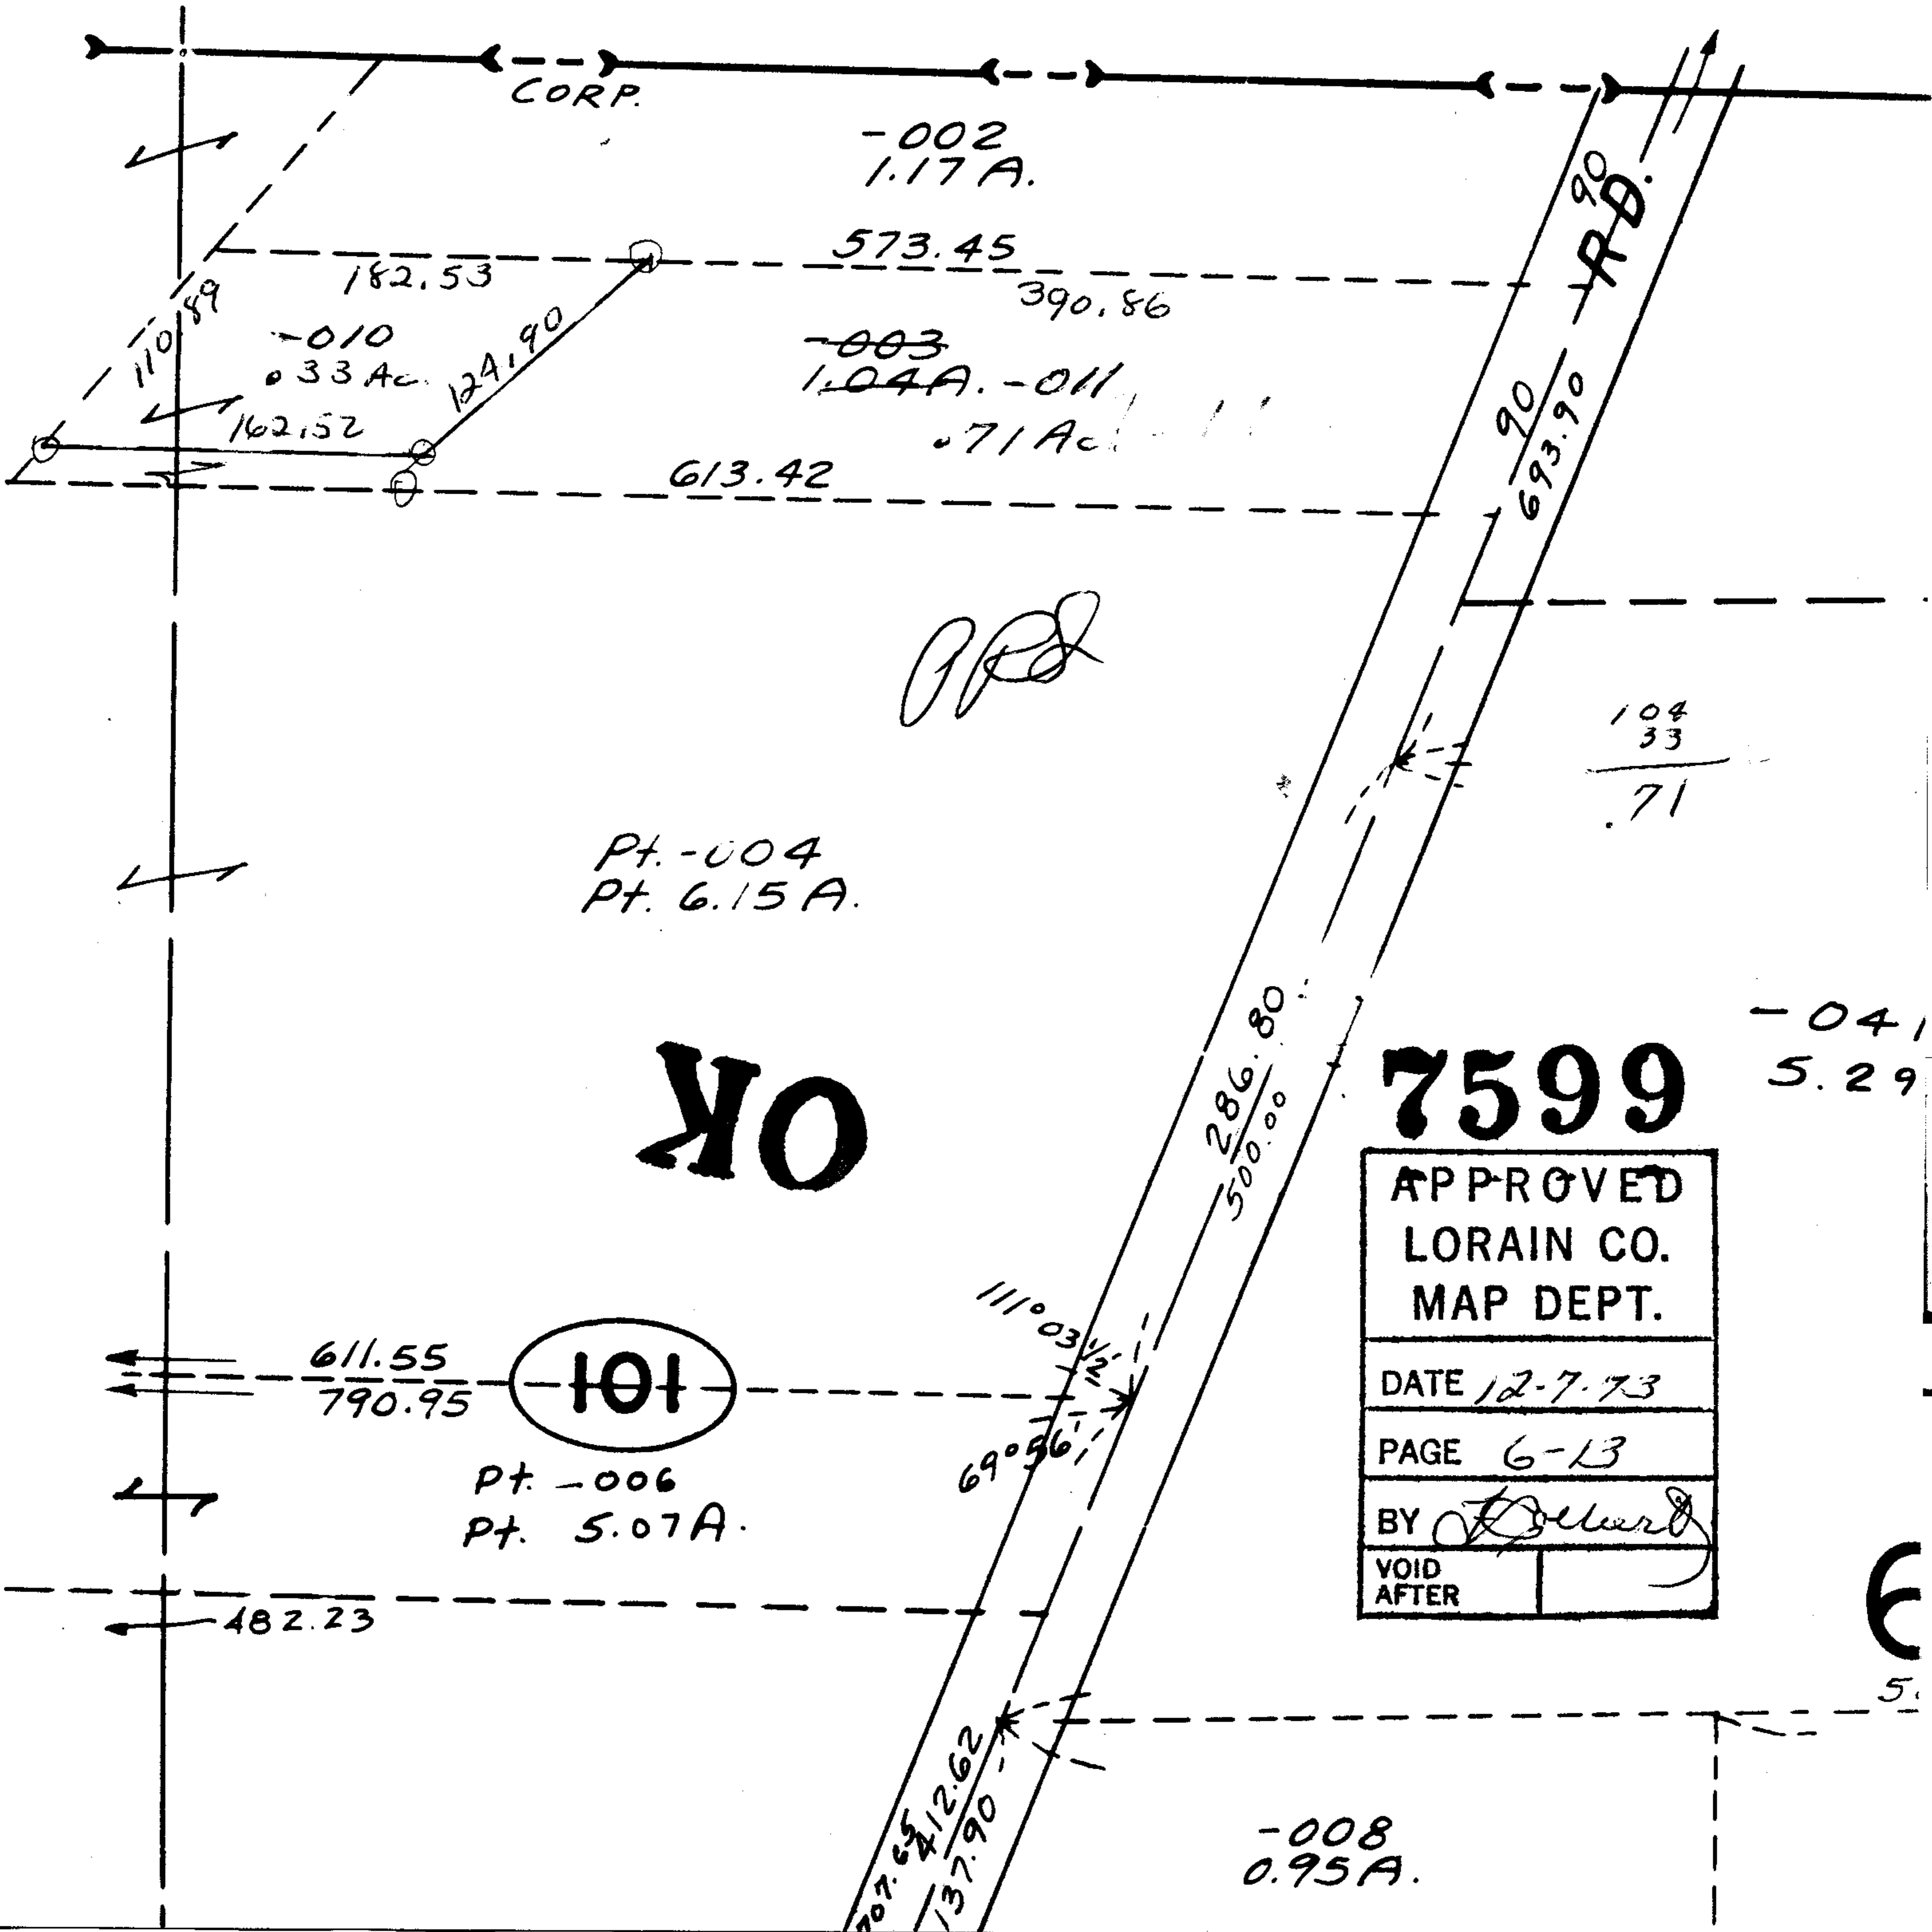

OK

7599

APPROVED LORAIN CO. MAP DEPT.	
DATE 12-7-73	
PAGE 6-13	
BY <i>[Signature]</i>	
VOID AFTER	

-041  
5.29

6  
5.