


7602

107

-007  
3.02 A.

OK

*[Handwritten signature]*  
-028  
6.41 A.  
-036  
4.37

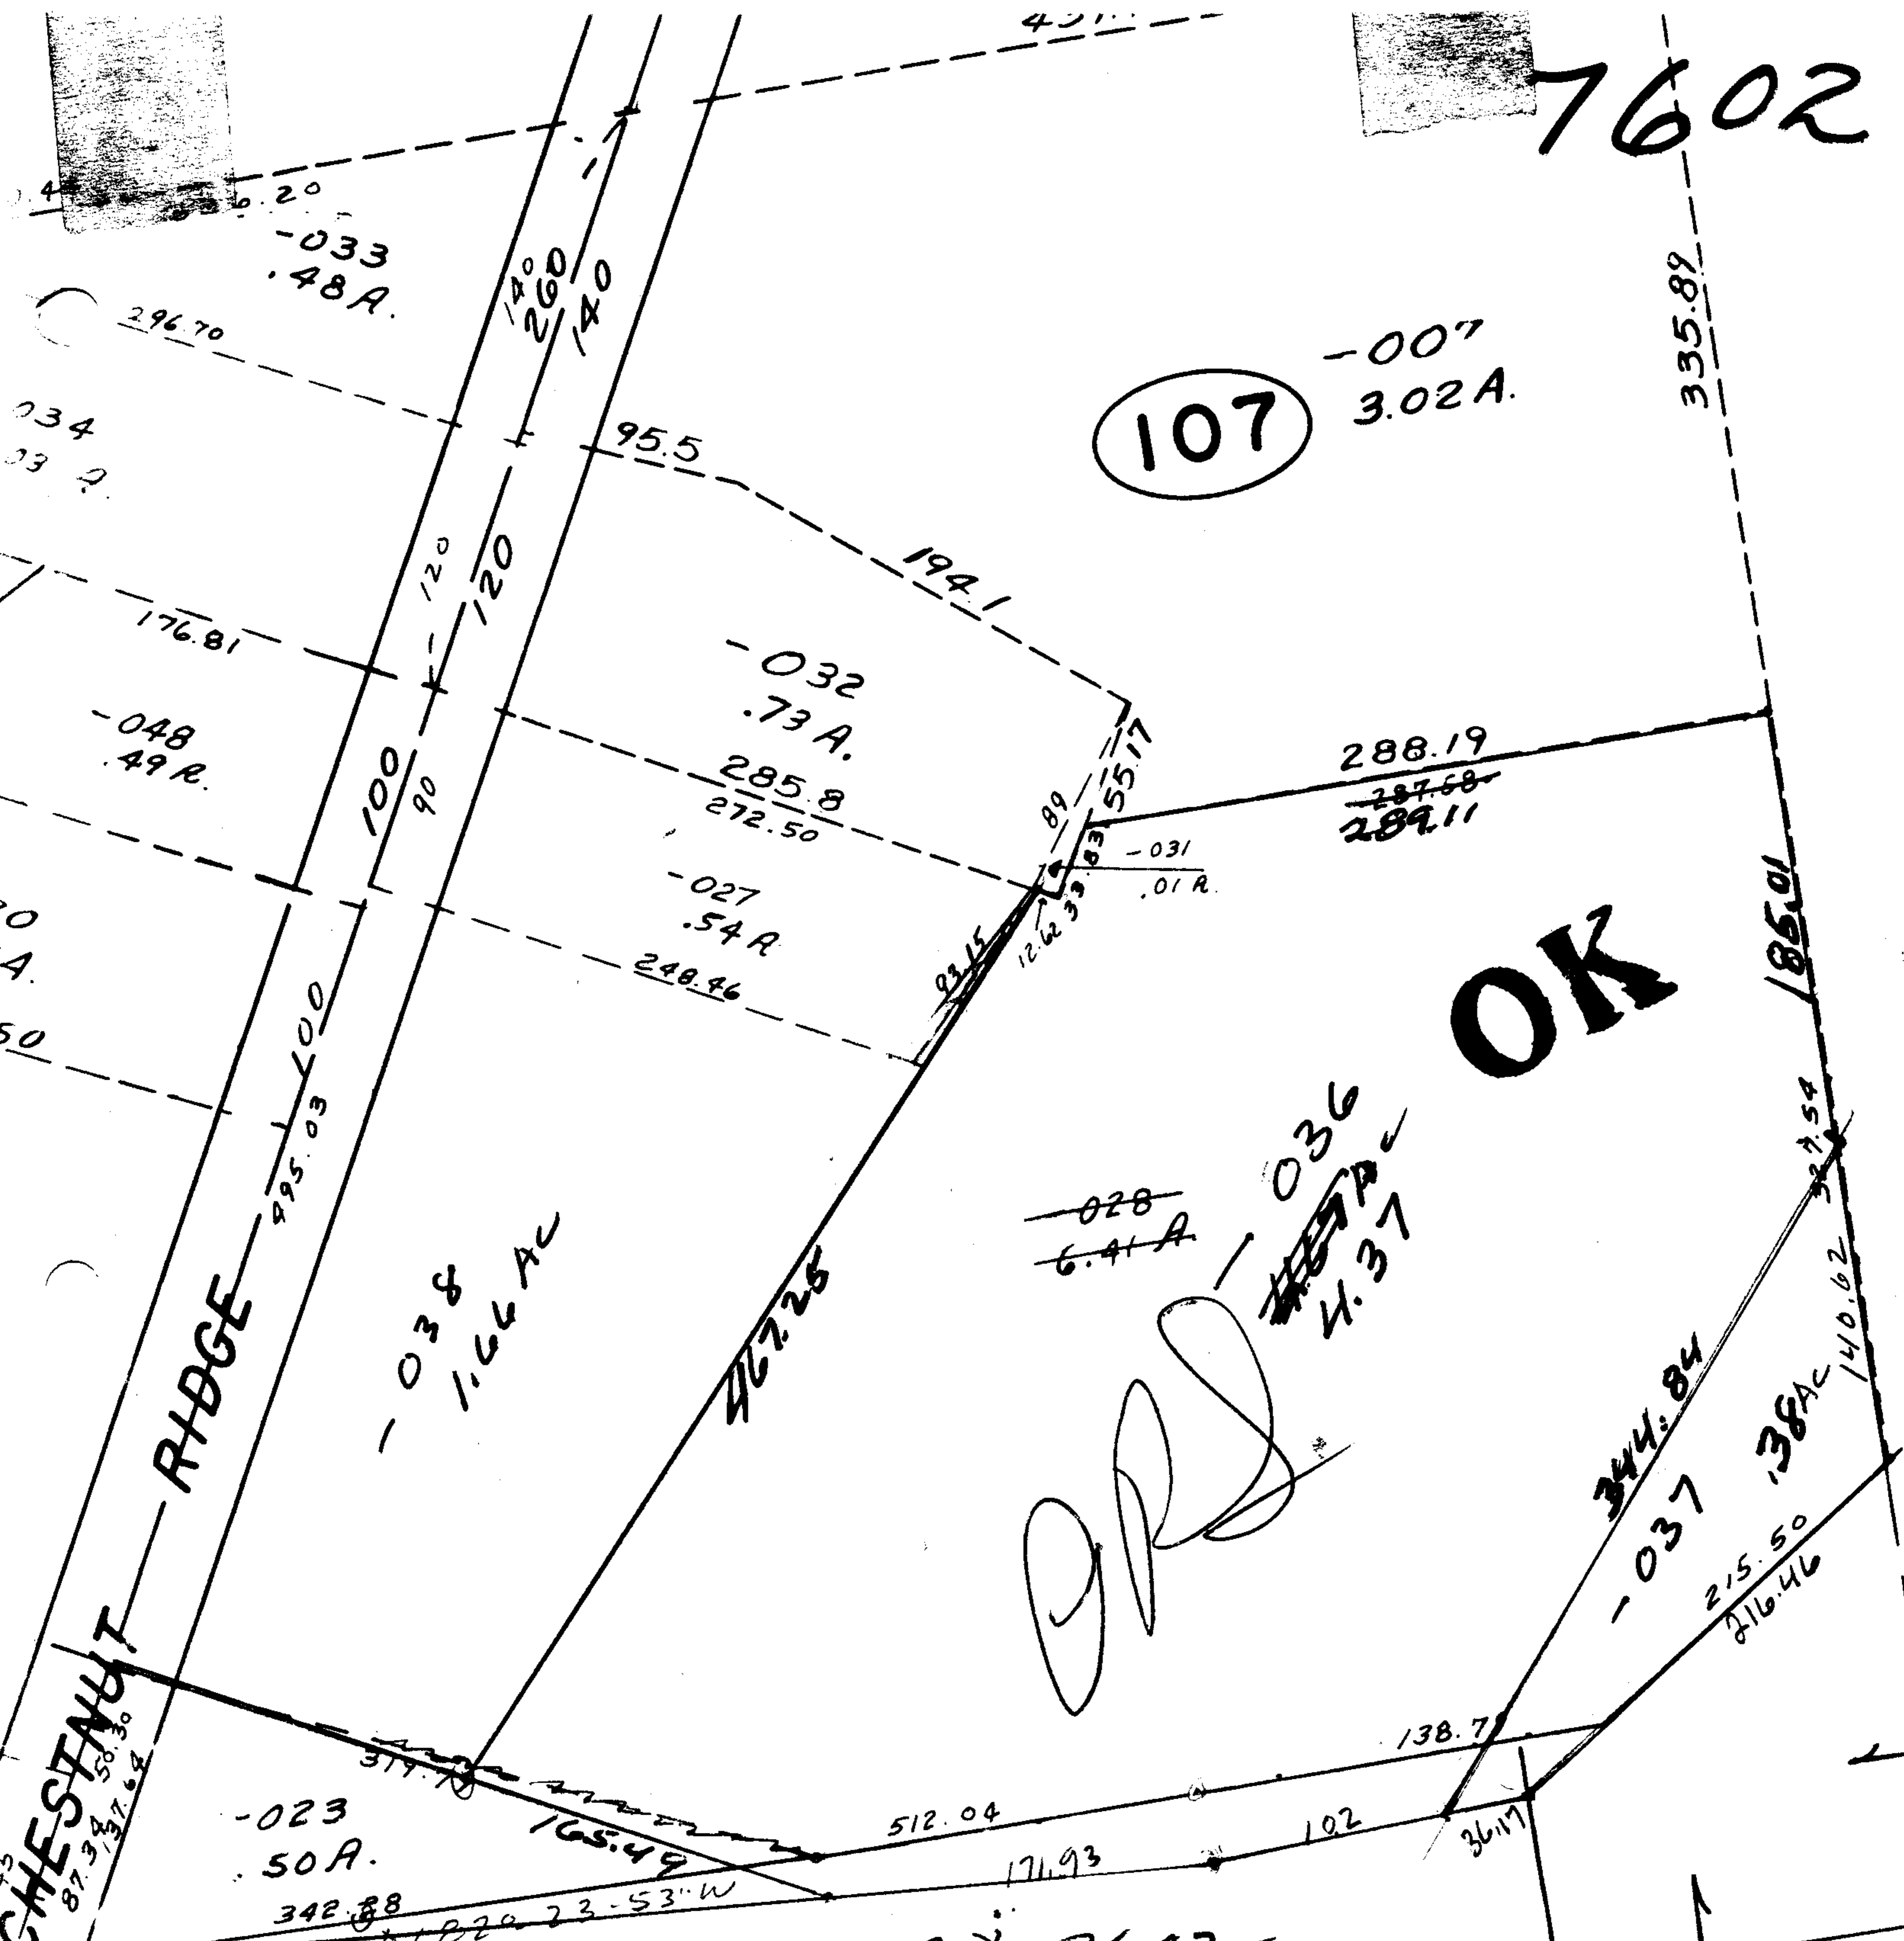

SEE 7-00-010-C

7-30-86 L.L. 7602

APPROVED
LORAIN CO.
MAP DEPT.
DATE 12-12-73
PAGE 07-00-010A
BY L.W. Hall
VOID AFTER

*[Handwritten initials]*

LOT 10