

7638

7638
 APPROVED
 LORAIN CO.
 MAP DEPT.
 DATE
 PAGE 1-00-018-B
 BY P.M.H.
 VOID AFTER

1255.29

2654.52

2084.76

Pt. 7044


Pt. 4174

67.62
 By Survey
 M. Hora
 4712

Pt. 7094

Pt. 4178A

BRIDGE

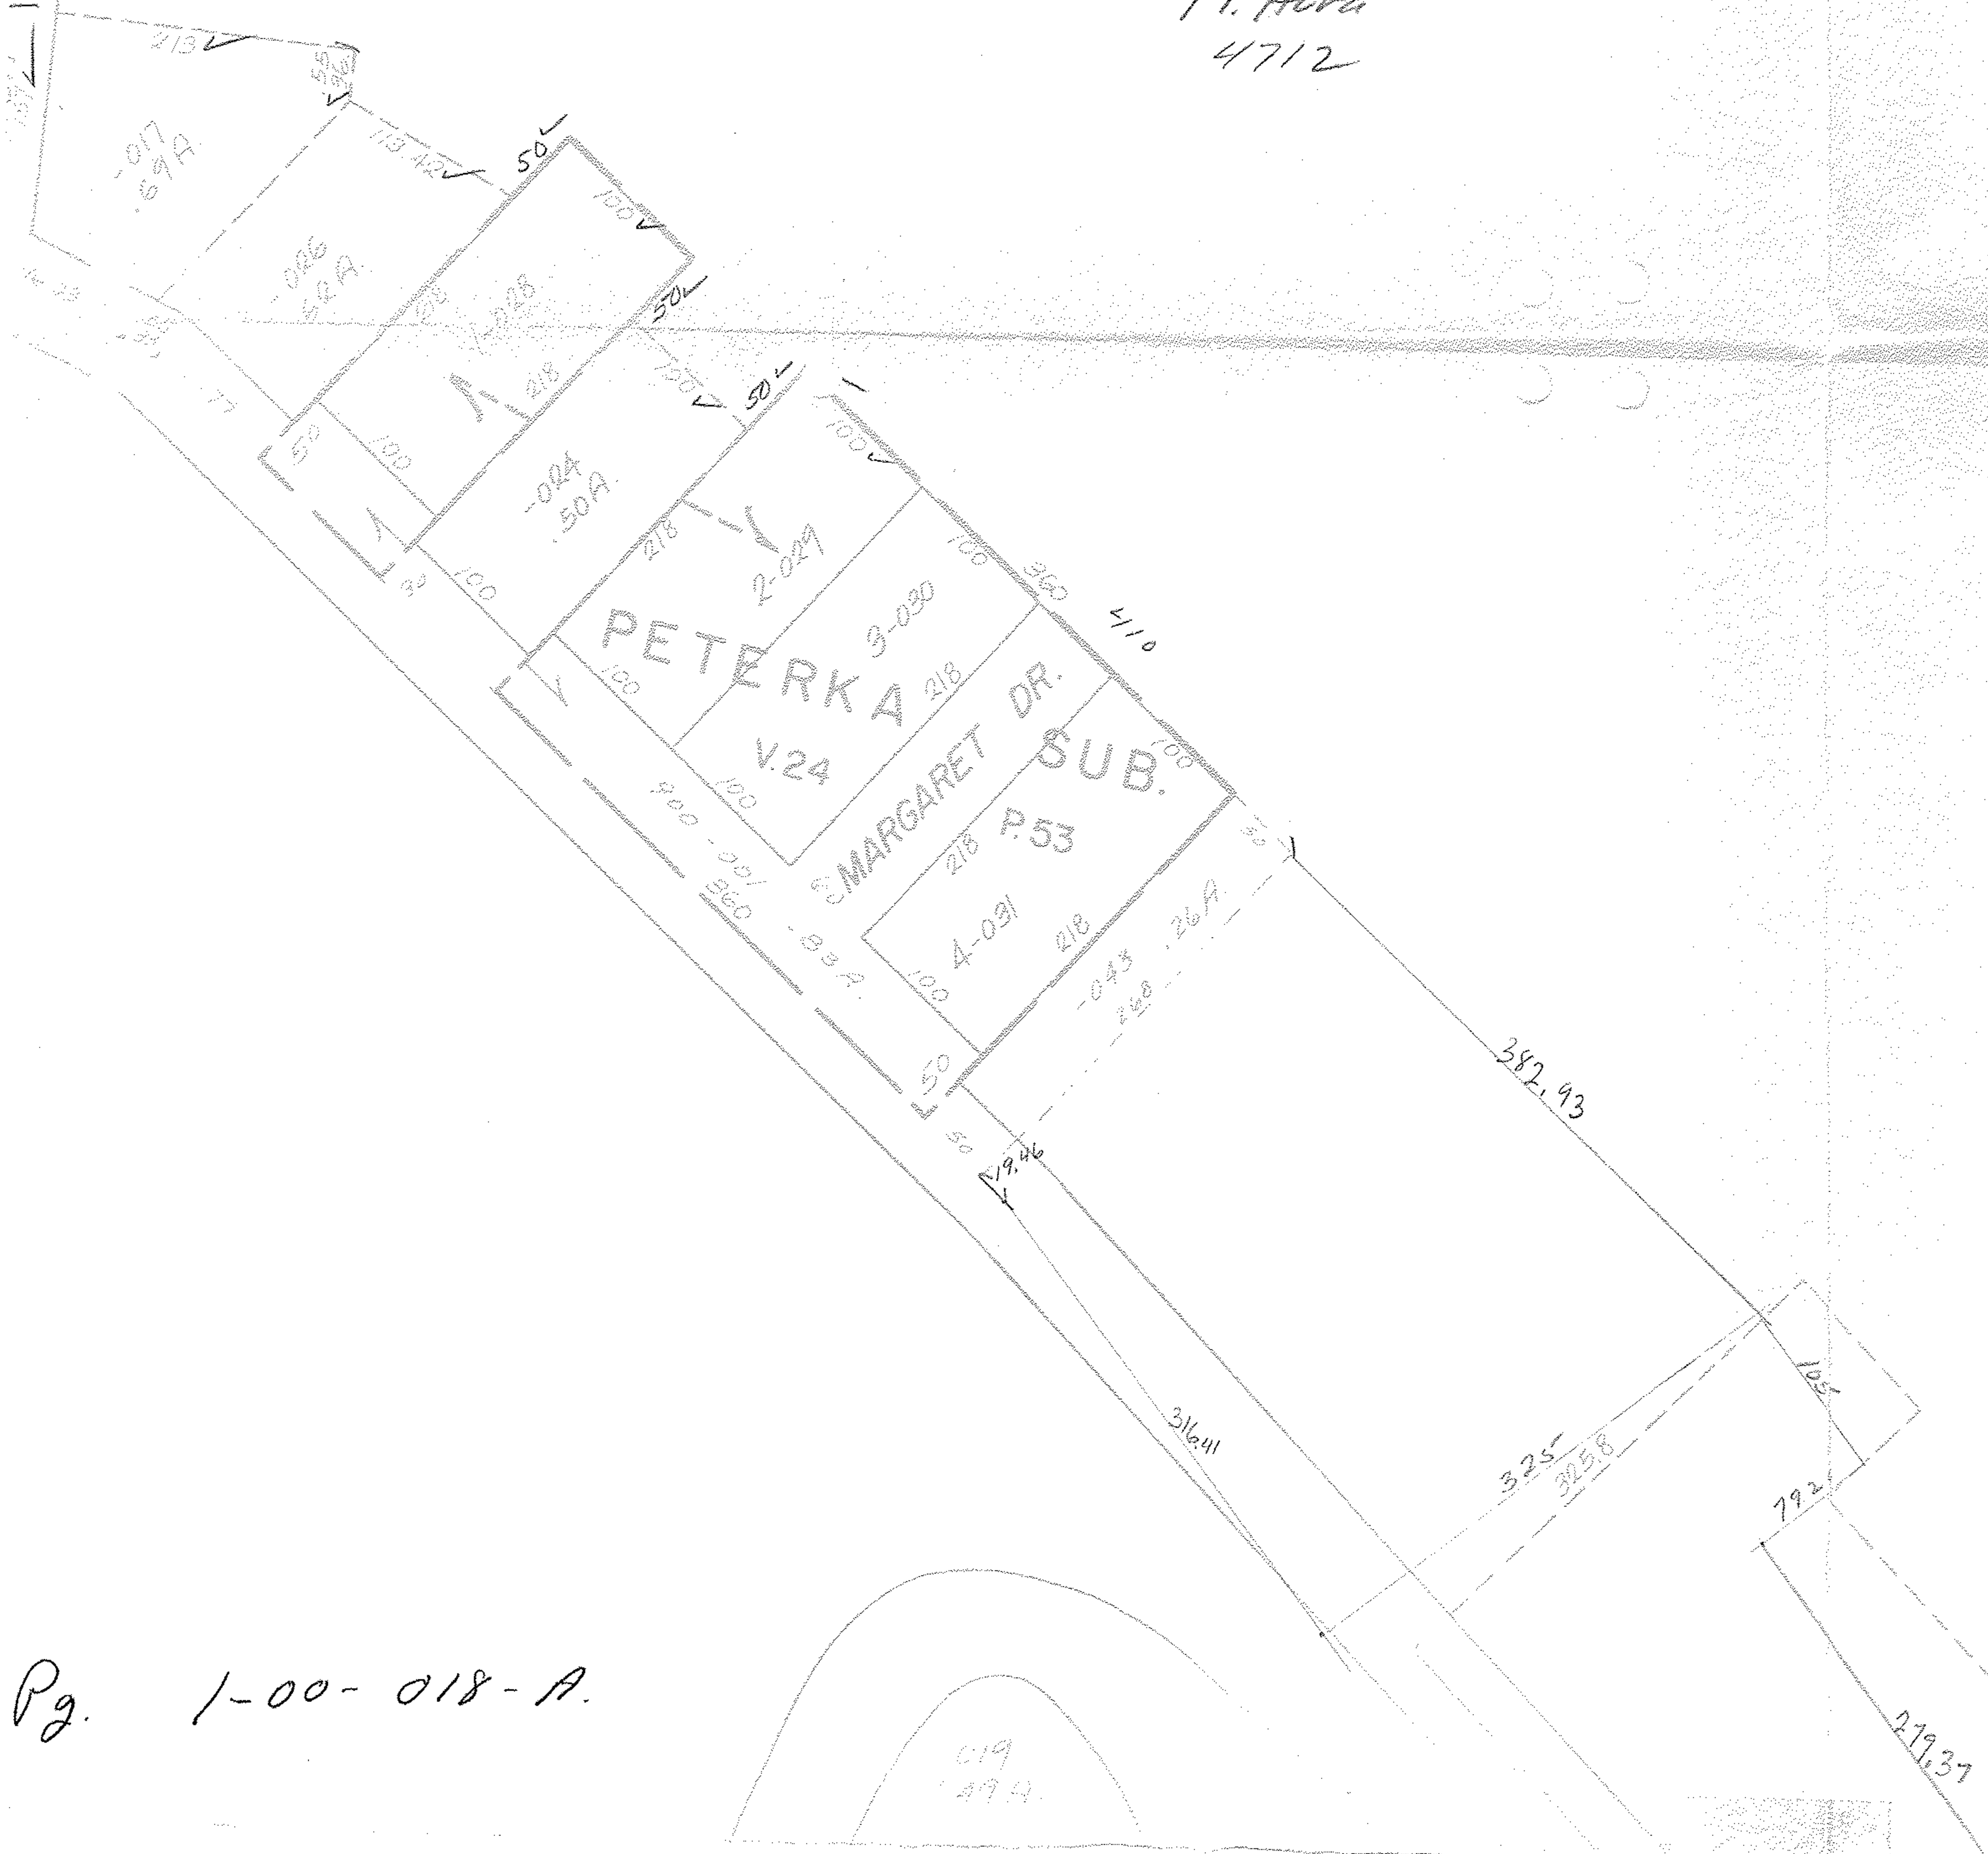

PRR