


849.75

-003  
7.50A.

-004  
69.00A.

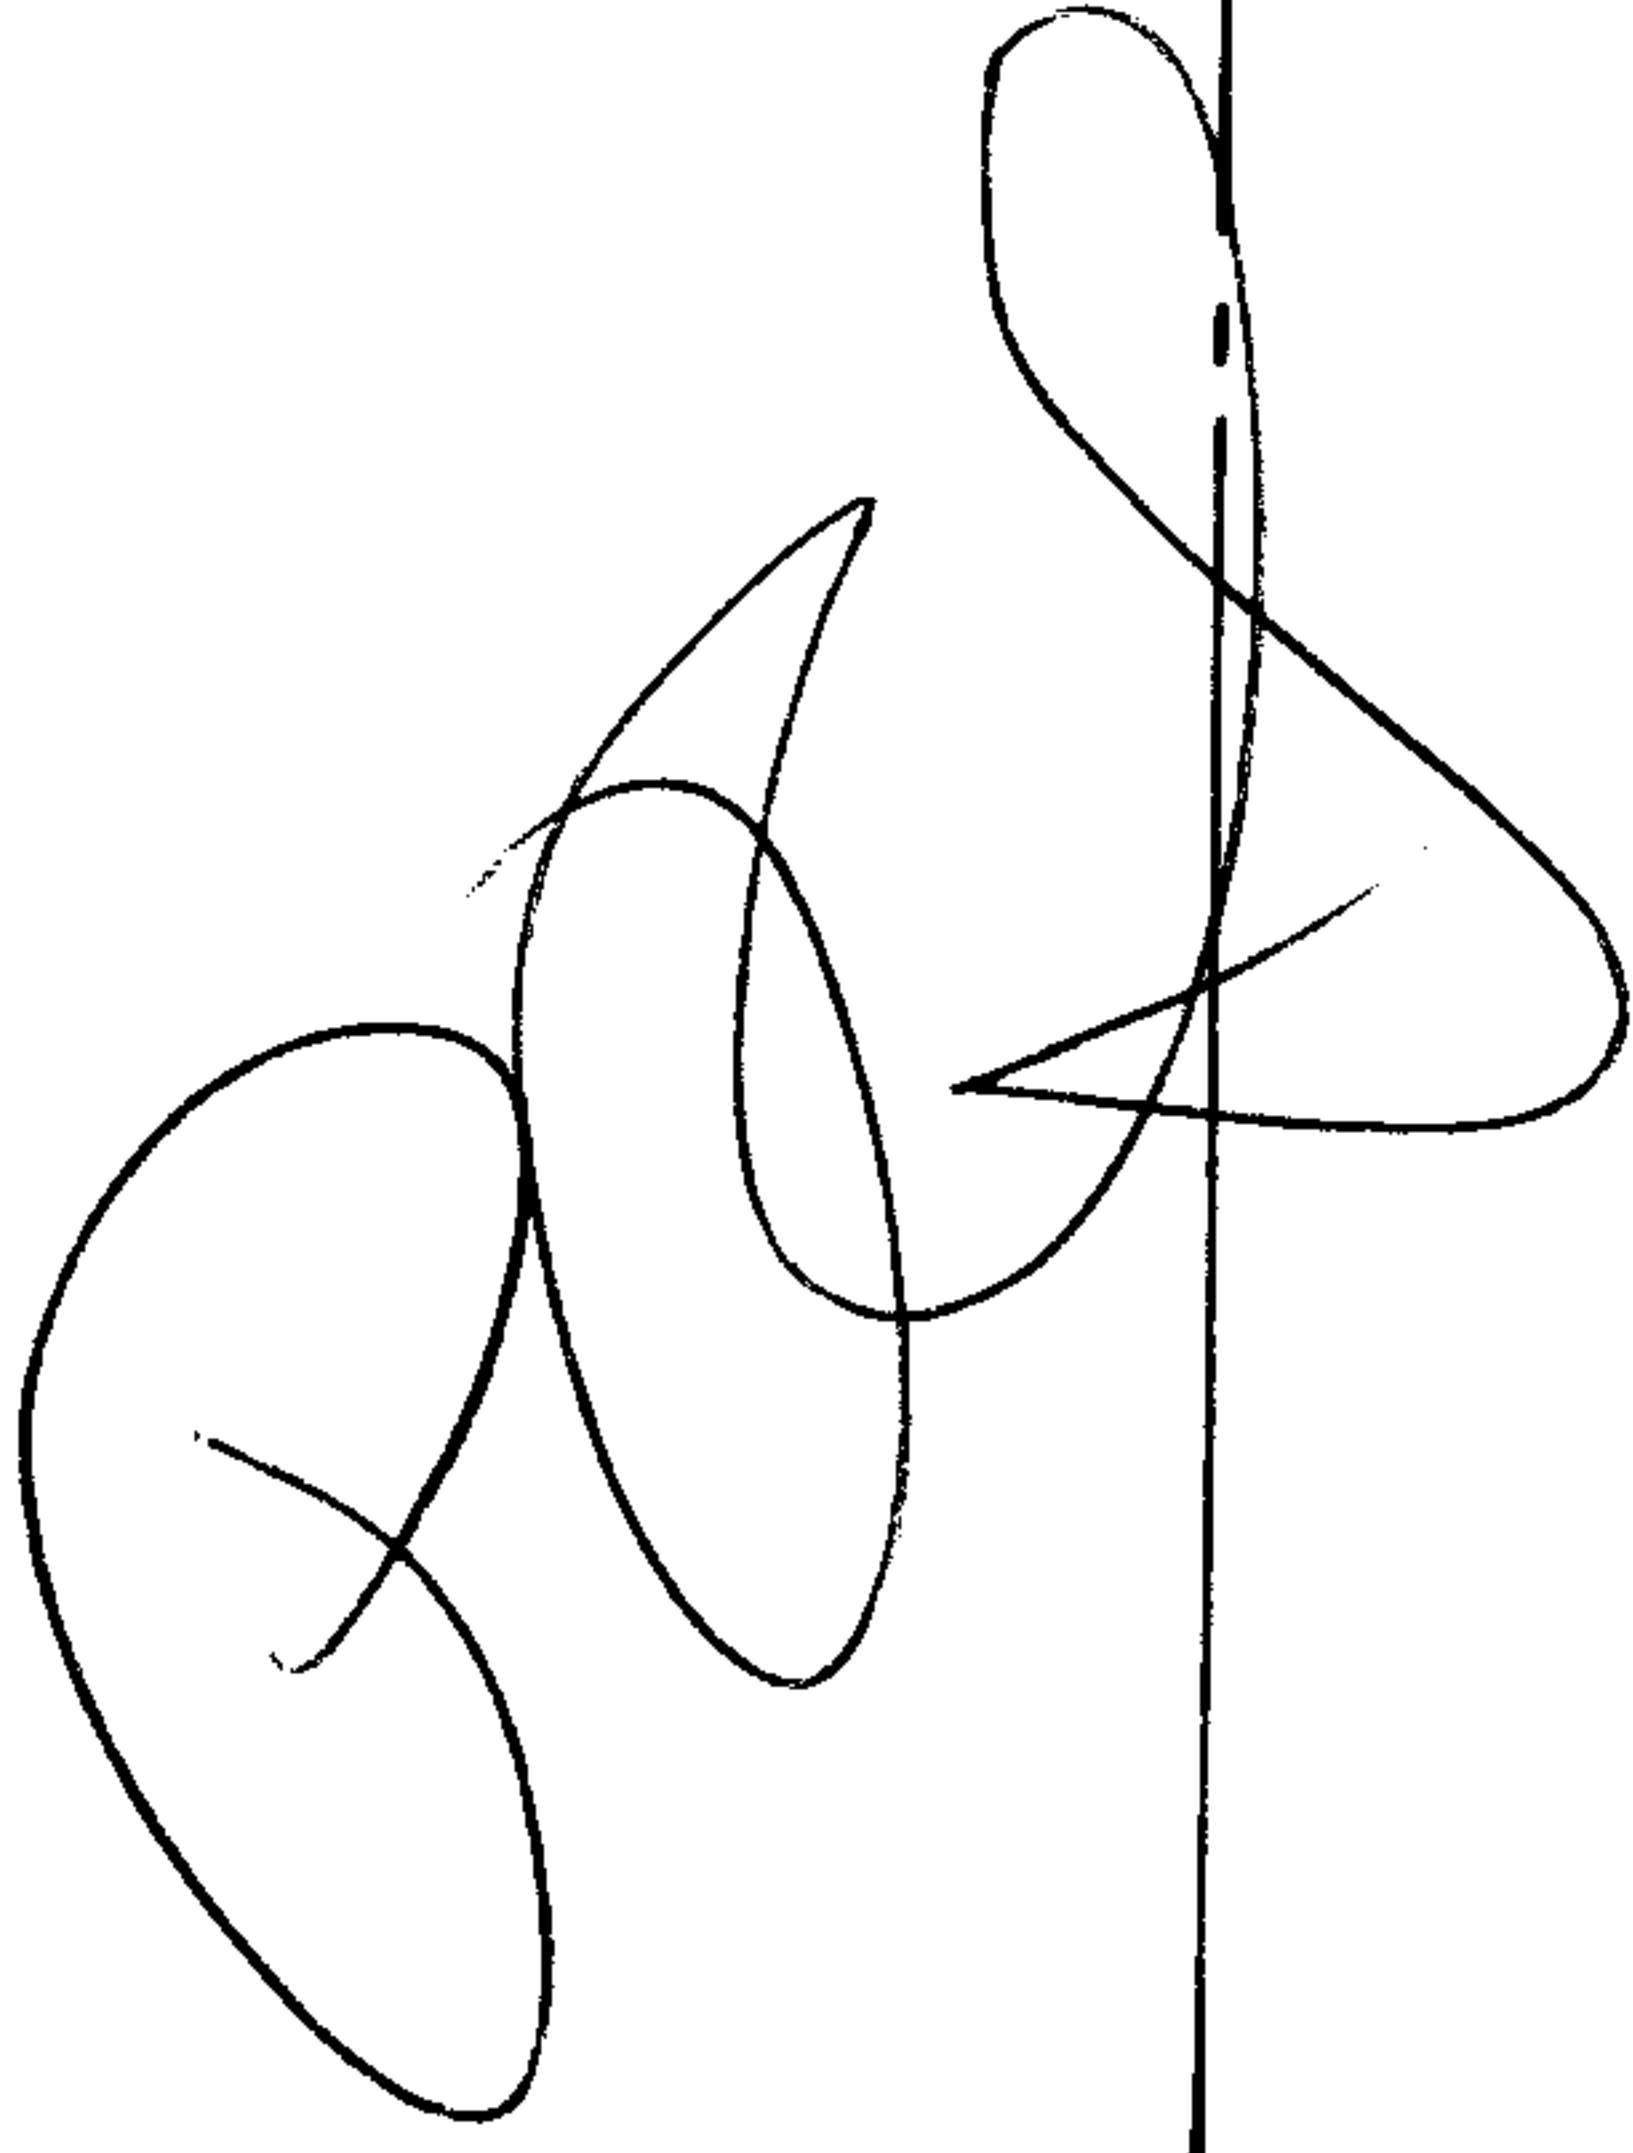

**OK**

-001  
54.00A.

7645  
APPROVED  
LORAIN CO.  
MAP DEPT.

DATE 1-7-74

SCALE 1/50

L.A. H. H.

7-30-86 L.L.

-002  
27.75A.

**94**

R

139.8719

369.25

270.52

6.55A

768.22

-004  
6.55A.

1052.59

1082.45

-004  
5.01A.

1190.18


-005  
10.37A

1187.04

010

~~-008~~  
53.37A.

50.47A

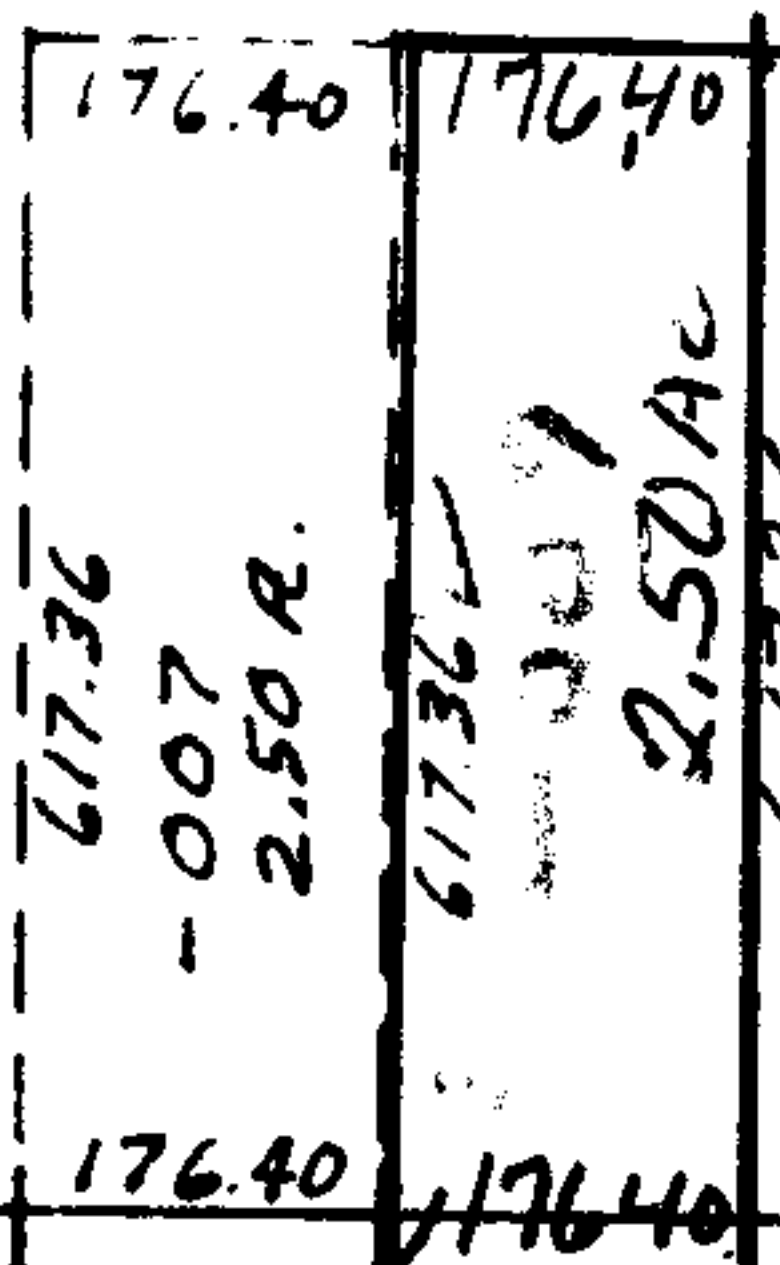

RD.

(50? 60?)

955.43  
1131.33 Webster