


7663

7663

SEE 6-142

1089

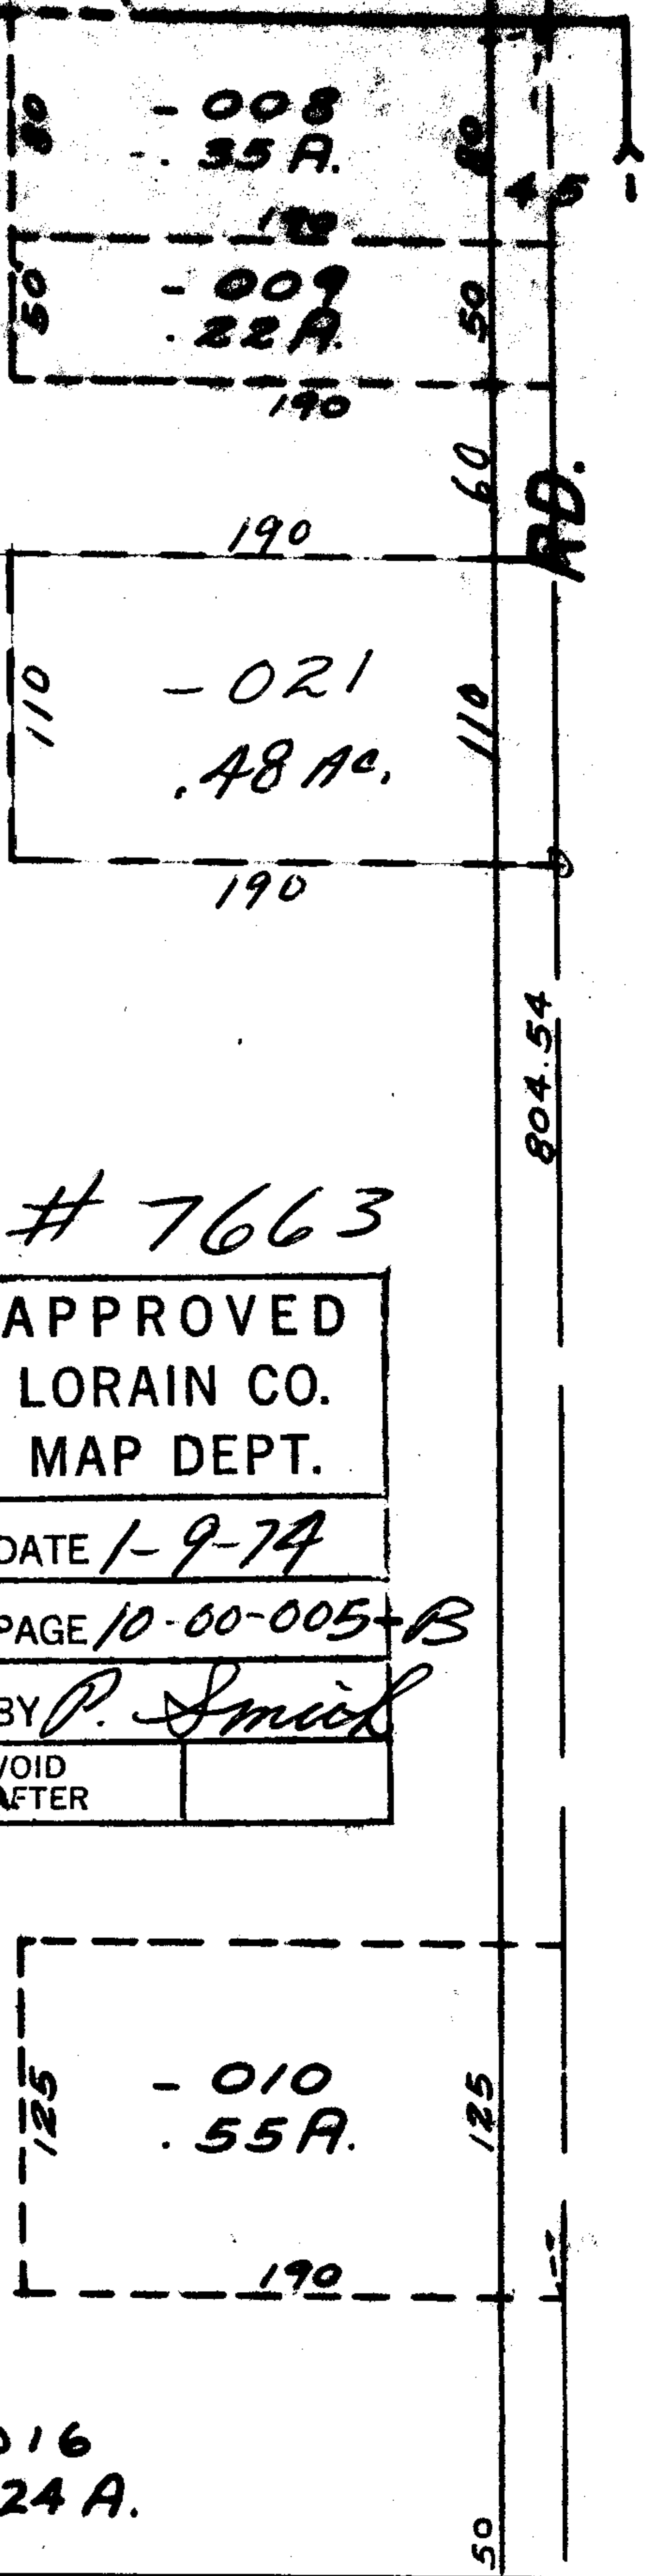

PKS

X

~~0.22~~
18.05 A.

- 022
18.07 Ac.

7663

APPROVED LORAIN CO. MAP DEPT.	
DATE 1-9-74	
PAGE 10-00-005-B	
BY <i>P. Smith</i>	
VOID AFTER	

804.54

RD.

110

50

80

190

190

190

110

50

80

360

150

50

- 016
1.24 A.