

760

22.6 A.

34.87 chs

142.46
-003
140.4

-001
7.70 A.

252.2

-001
21.00 A.

A

-004
24.3 A.

225
-002
2.19 A.

227


202.3

225

270.2

400

OK

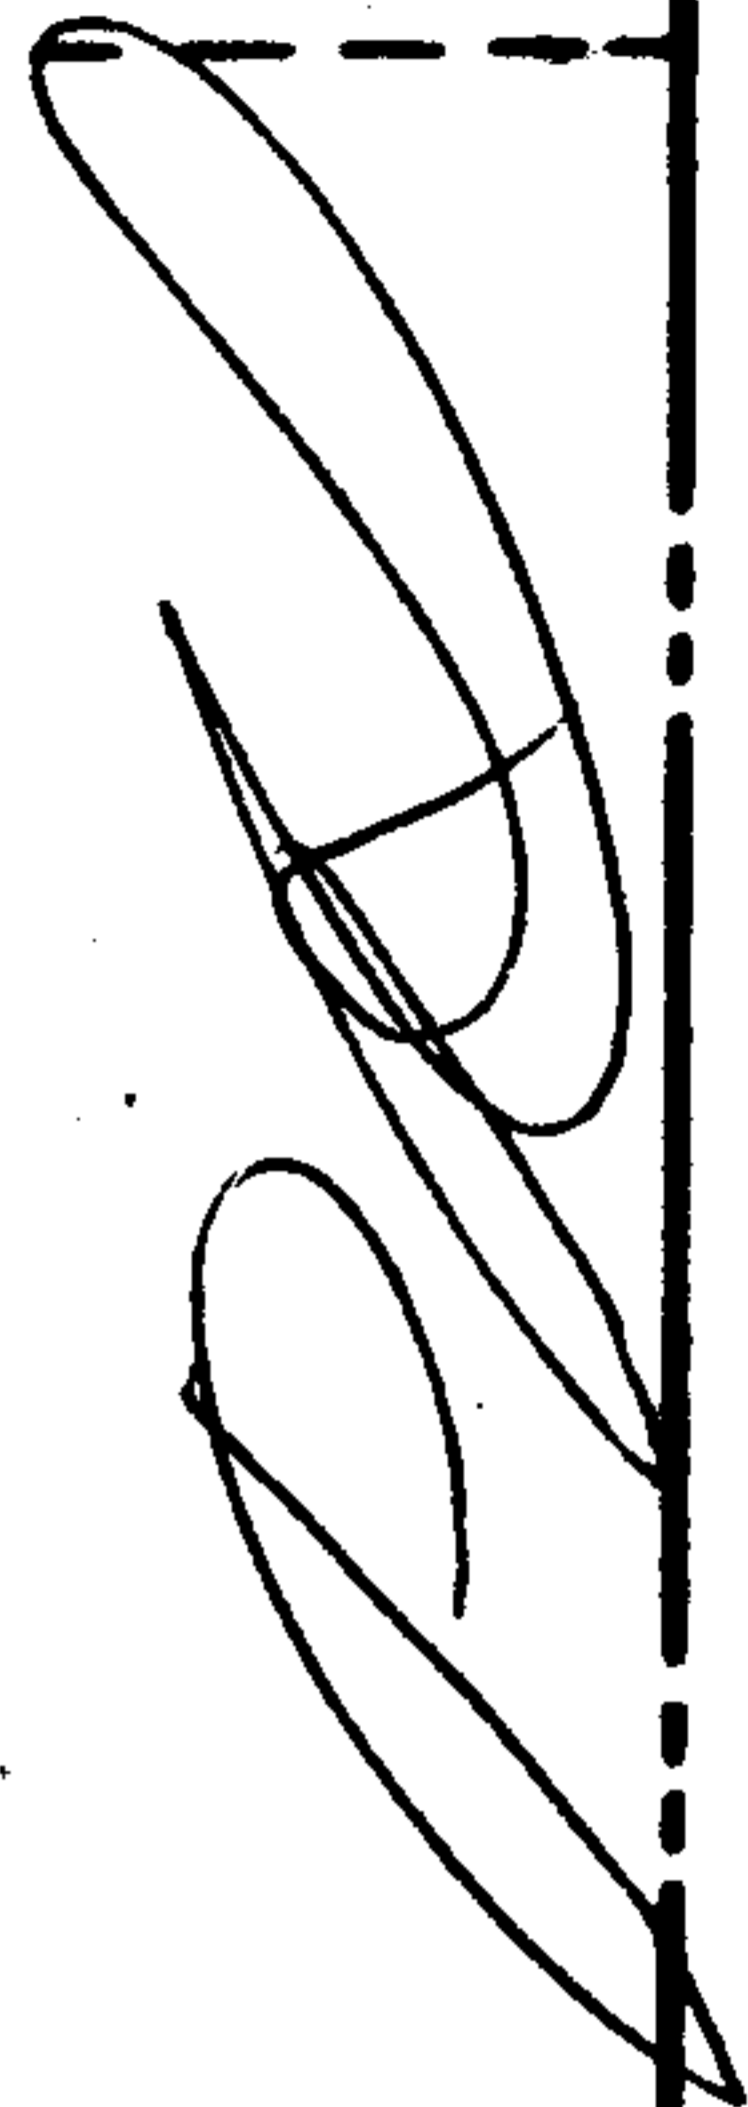

T

49

50

-010
34.71 A.

-012
25.00 Ac.

~~-005~~
50.00 A.

2742

-011
25.00 Ac.

2735

-002
99.57 A.

#7665

APPROVED LORAIN CO. MAP DEPT.	
DATE 1-9-74	
PAGE 19-D	
BY P. Smith	
VOID AFTER	

B

RD