


Pt 067  
Pt 10.37 Ac

7666

1324.68

1524.68

3-B

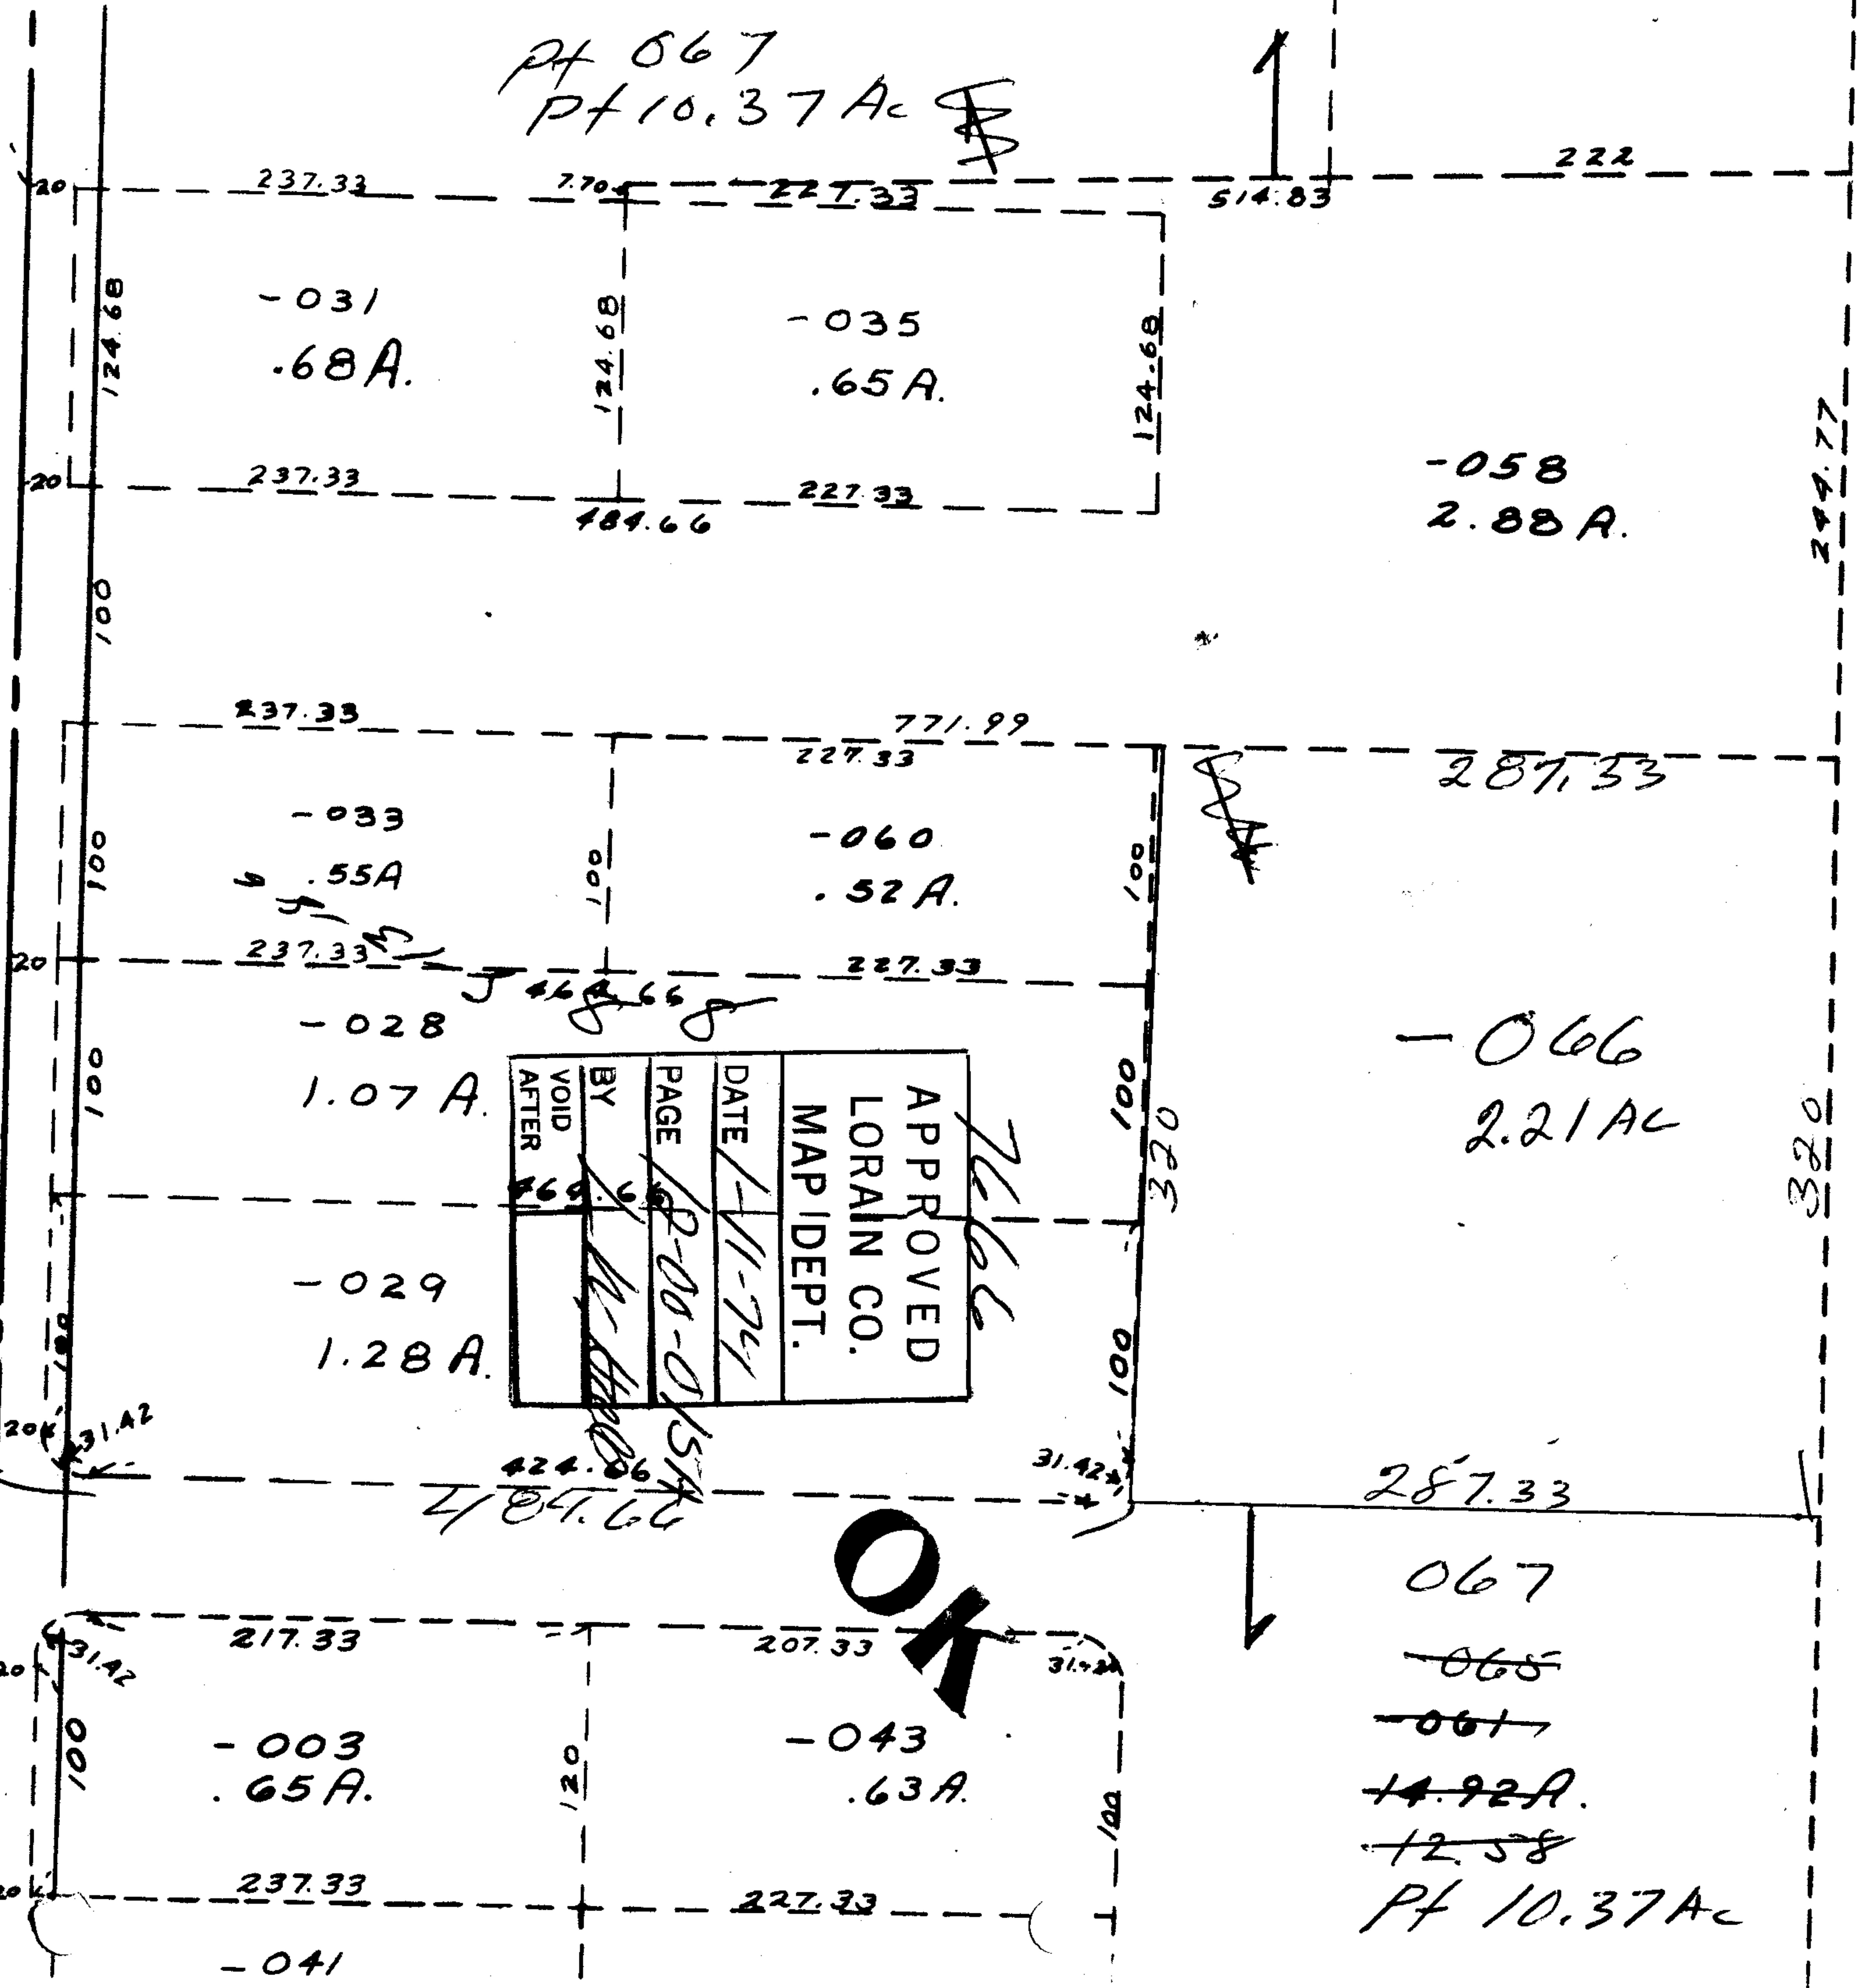

APPROVED
LORAIN CO.
MAP DEPT.
DATE 1-11-74
PAGE 12-00-015A
BY [Signature]
VOID AFTER [Signature]

OK

[Large Signature]

287.33

067

~~068~~

~~061~~

~~14.92A.~~

~~12.58~~

Pt 10.37 Ac

-005

5.82A.

1250.84

1226.44