

7680

YO

# 7680

102

Pt -040  
Pt 79.30 Ac.

change #  
NUMBER &  
PAGE  
ON Pg. 7-H


RD.

REED

# 7680

APPROVED LORAIN CO. MAP DEPT.
DATE 1-21-74
7-00-012-A PAGE 4-7-H
BY Paul Smith
VOID AFTER

103

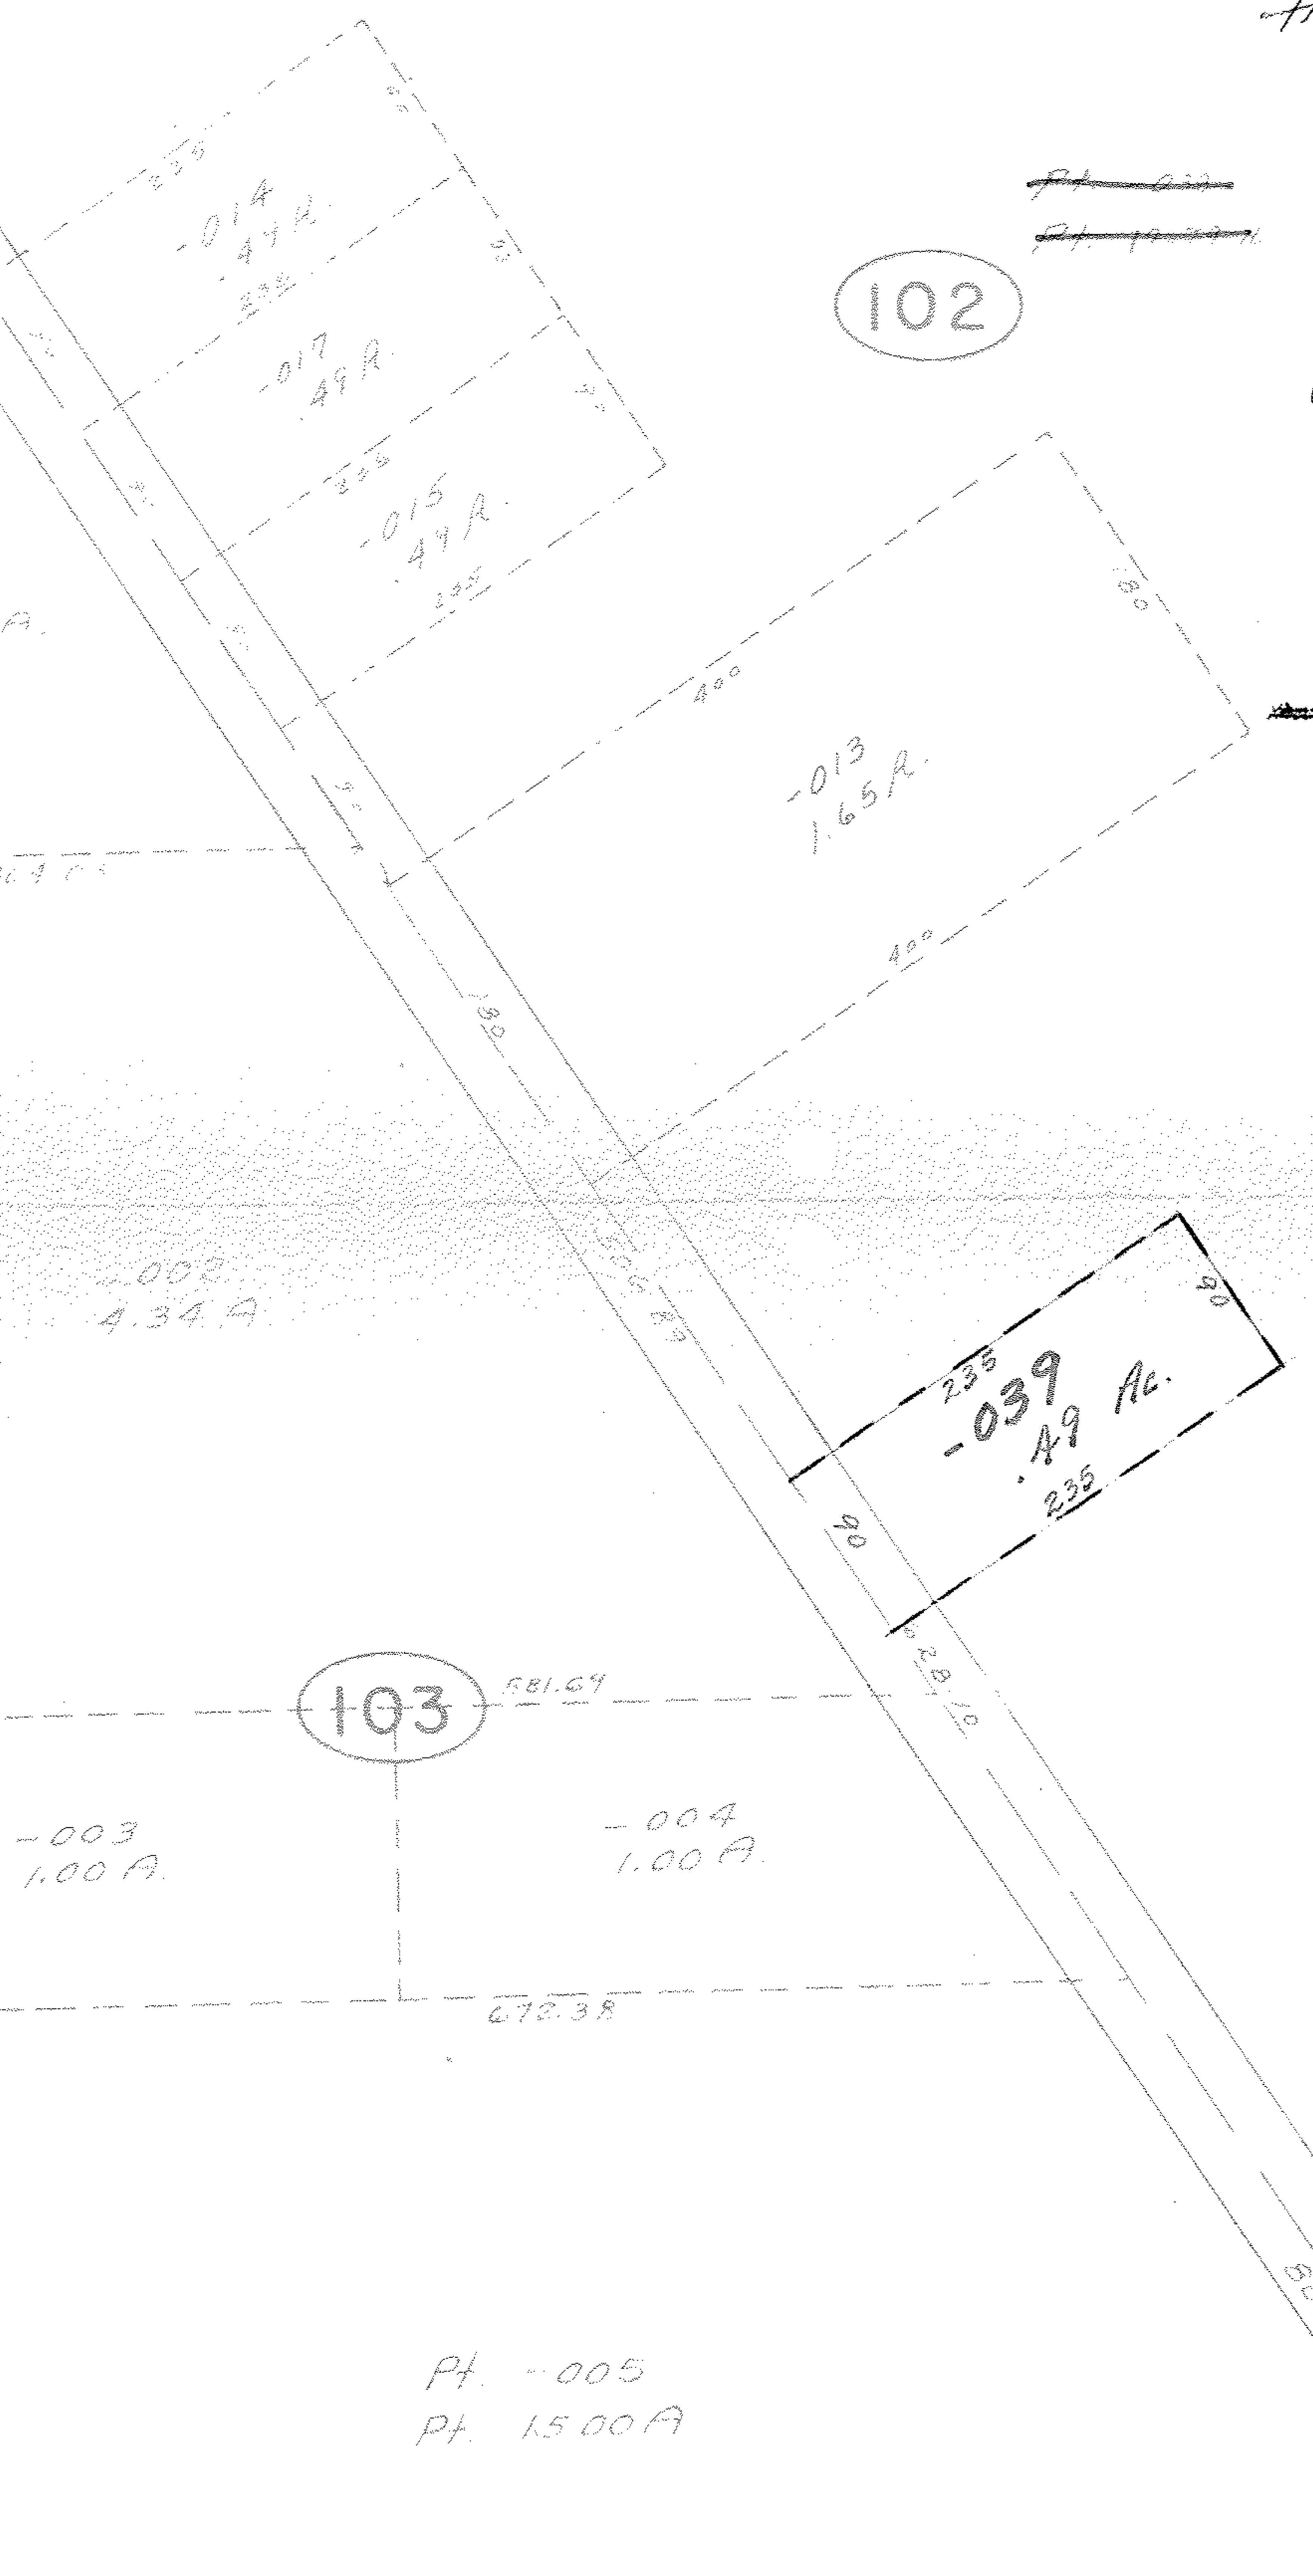

PPB

Pt. -005  
Pt. 15.00 Ac.

-031  
1.04 Ac.

286.90  
288.20

RD.