

756  
174R

1.44F.

-055  
.52A.  
323

1343.93

-061  
.99A.

070  
~~068~~  
8.47A  
~~064~~  
9.15R.  
7.95AC

**OK**

*[Handwritten signature]*

7694  
7695

130.94  
89  
341.49  
-063  
1.38A.

-067  
68Ac


-069  
**30**  
52Ac

175

-058  
5.03A

APPROVED	
LORAIN CO.	
MAP DEPT.	
DATE	PAGE 6-65
BY <i>S.W. McCall</i>	VOID AFTER

*#7698*

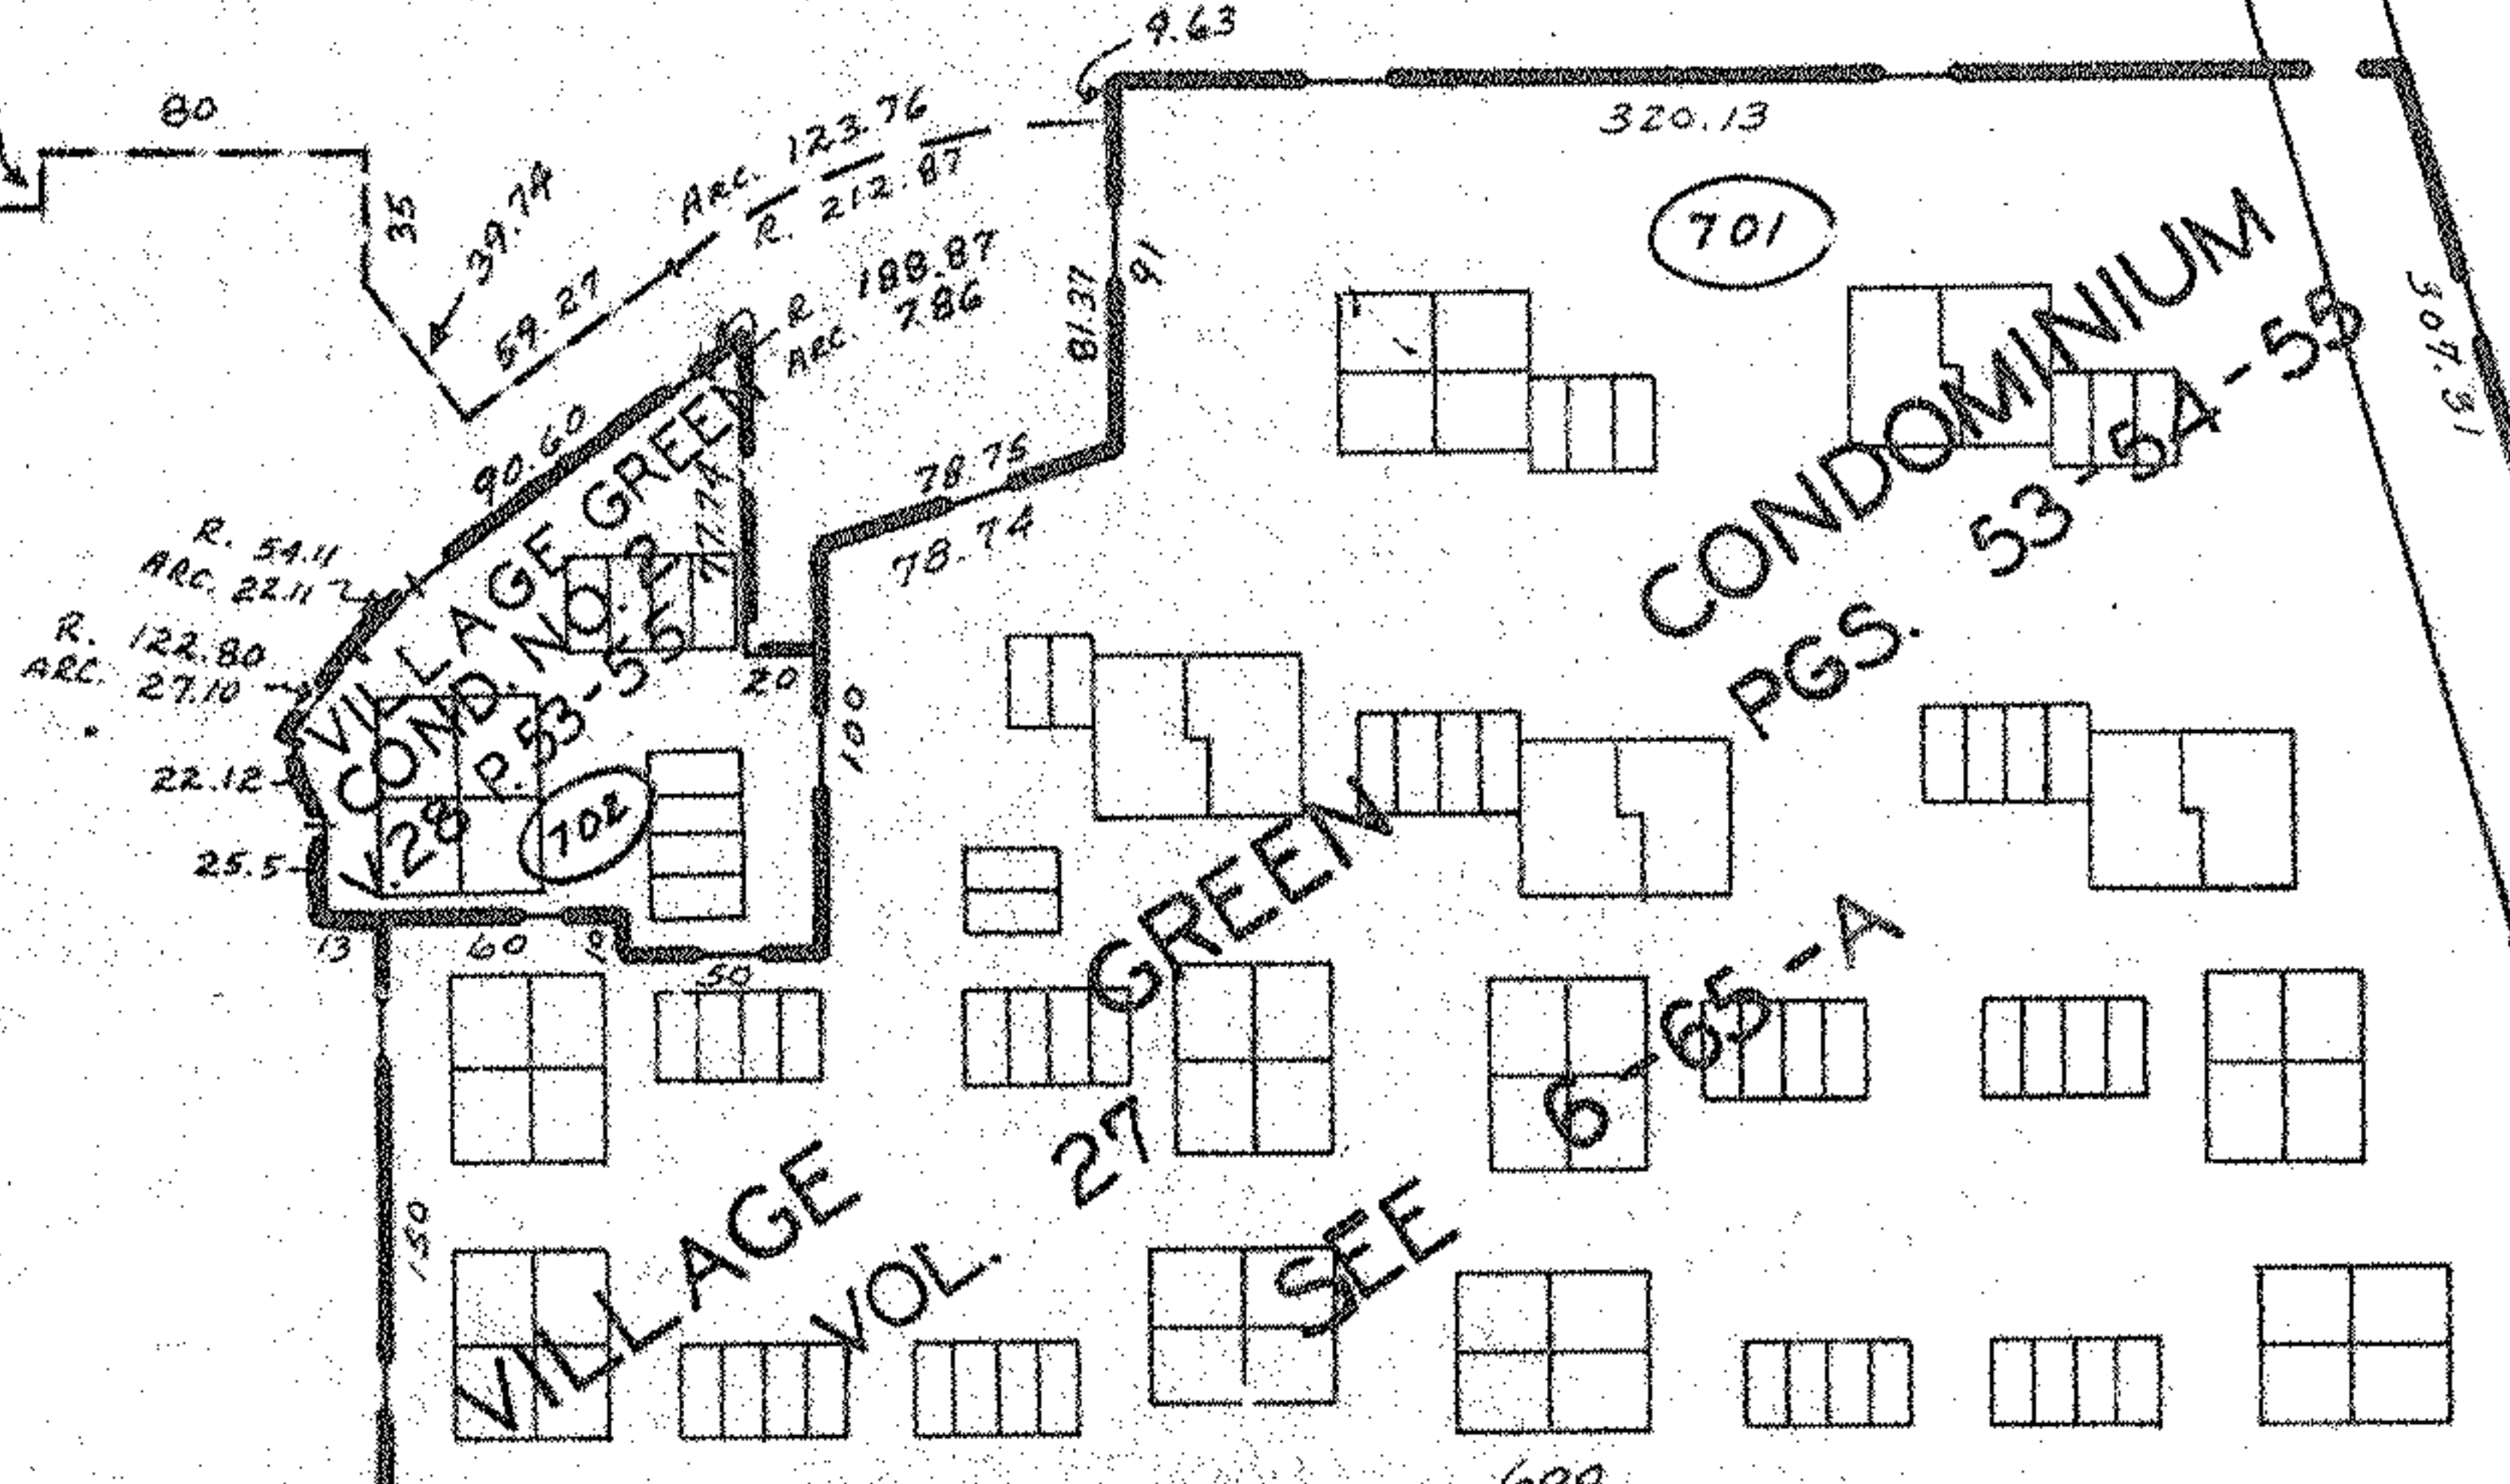

CONDOMINIUM  
PGS. 53-54-55

*#7698*

628.63

1157.51

486.88

584.86

426.11

1390.73

477.74

105°09'

60.75

307.31

285

717  
25  
RD.

701

6-65-A

SEE  
VILLAGE  
VOL. 27  
GREEN

VILLAGE GREEN  
COND. NO. 2  
PGS. 53-55

R. 54.11  
ARC. 22.11  
R. 122.80  
ARC. 27.10

A. 39.74  
ARC. 123.76  
R. 212.87  
R. 188.87  
ARC. 7.86

78.75  
78.74

320.13

122.68

80

14.12

106.89

320

148.49

159.94

120.19

134.75

134.54

470

320

335

300

66

135

89

39.03

162.91

175.75

17

127.24

65.56

245.47

308.97

22.12

25.5

13

60

8

50

20

100

100

