


257
185
72

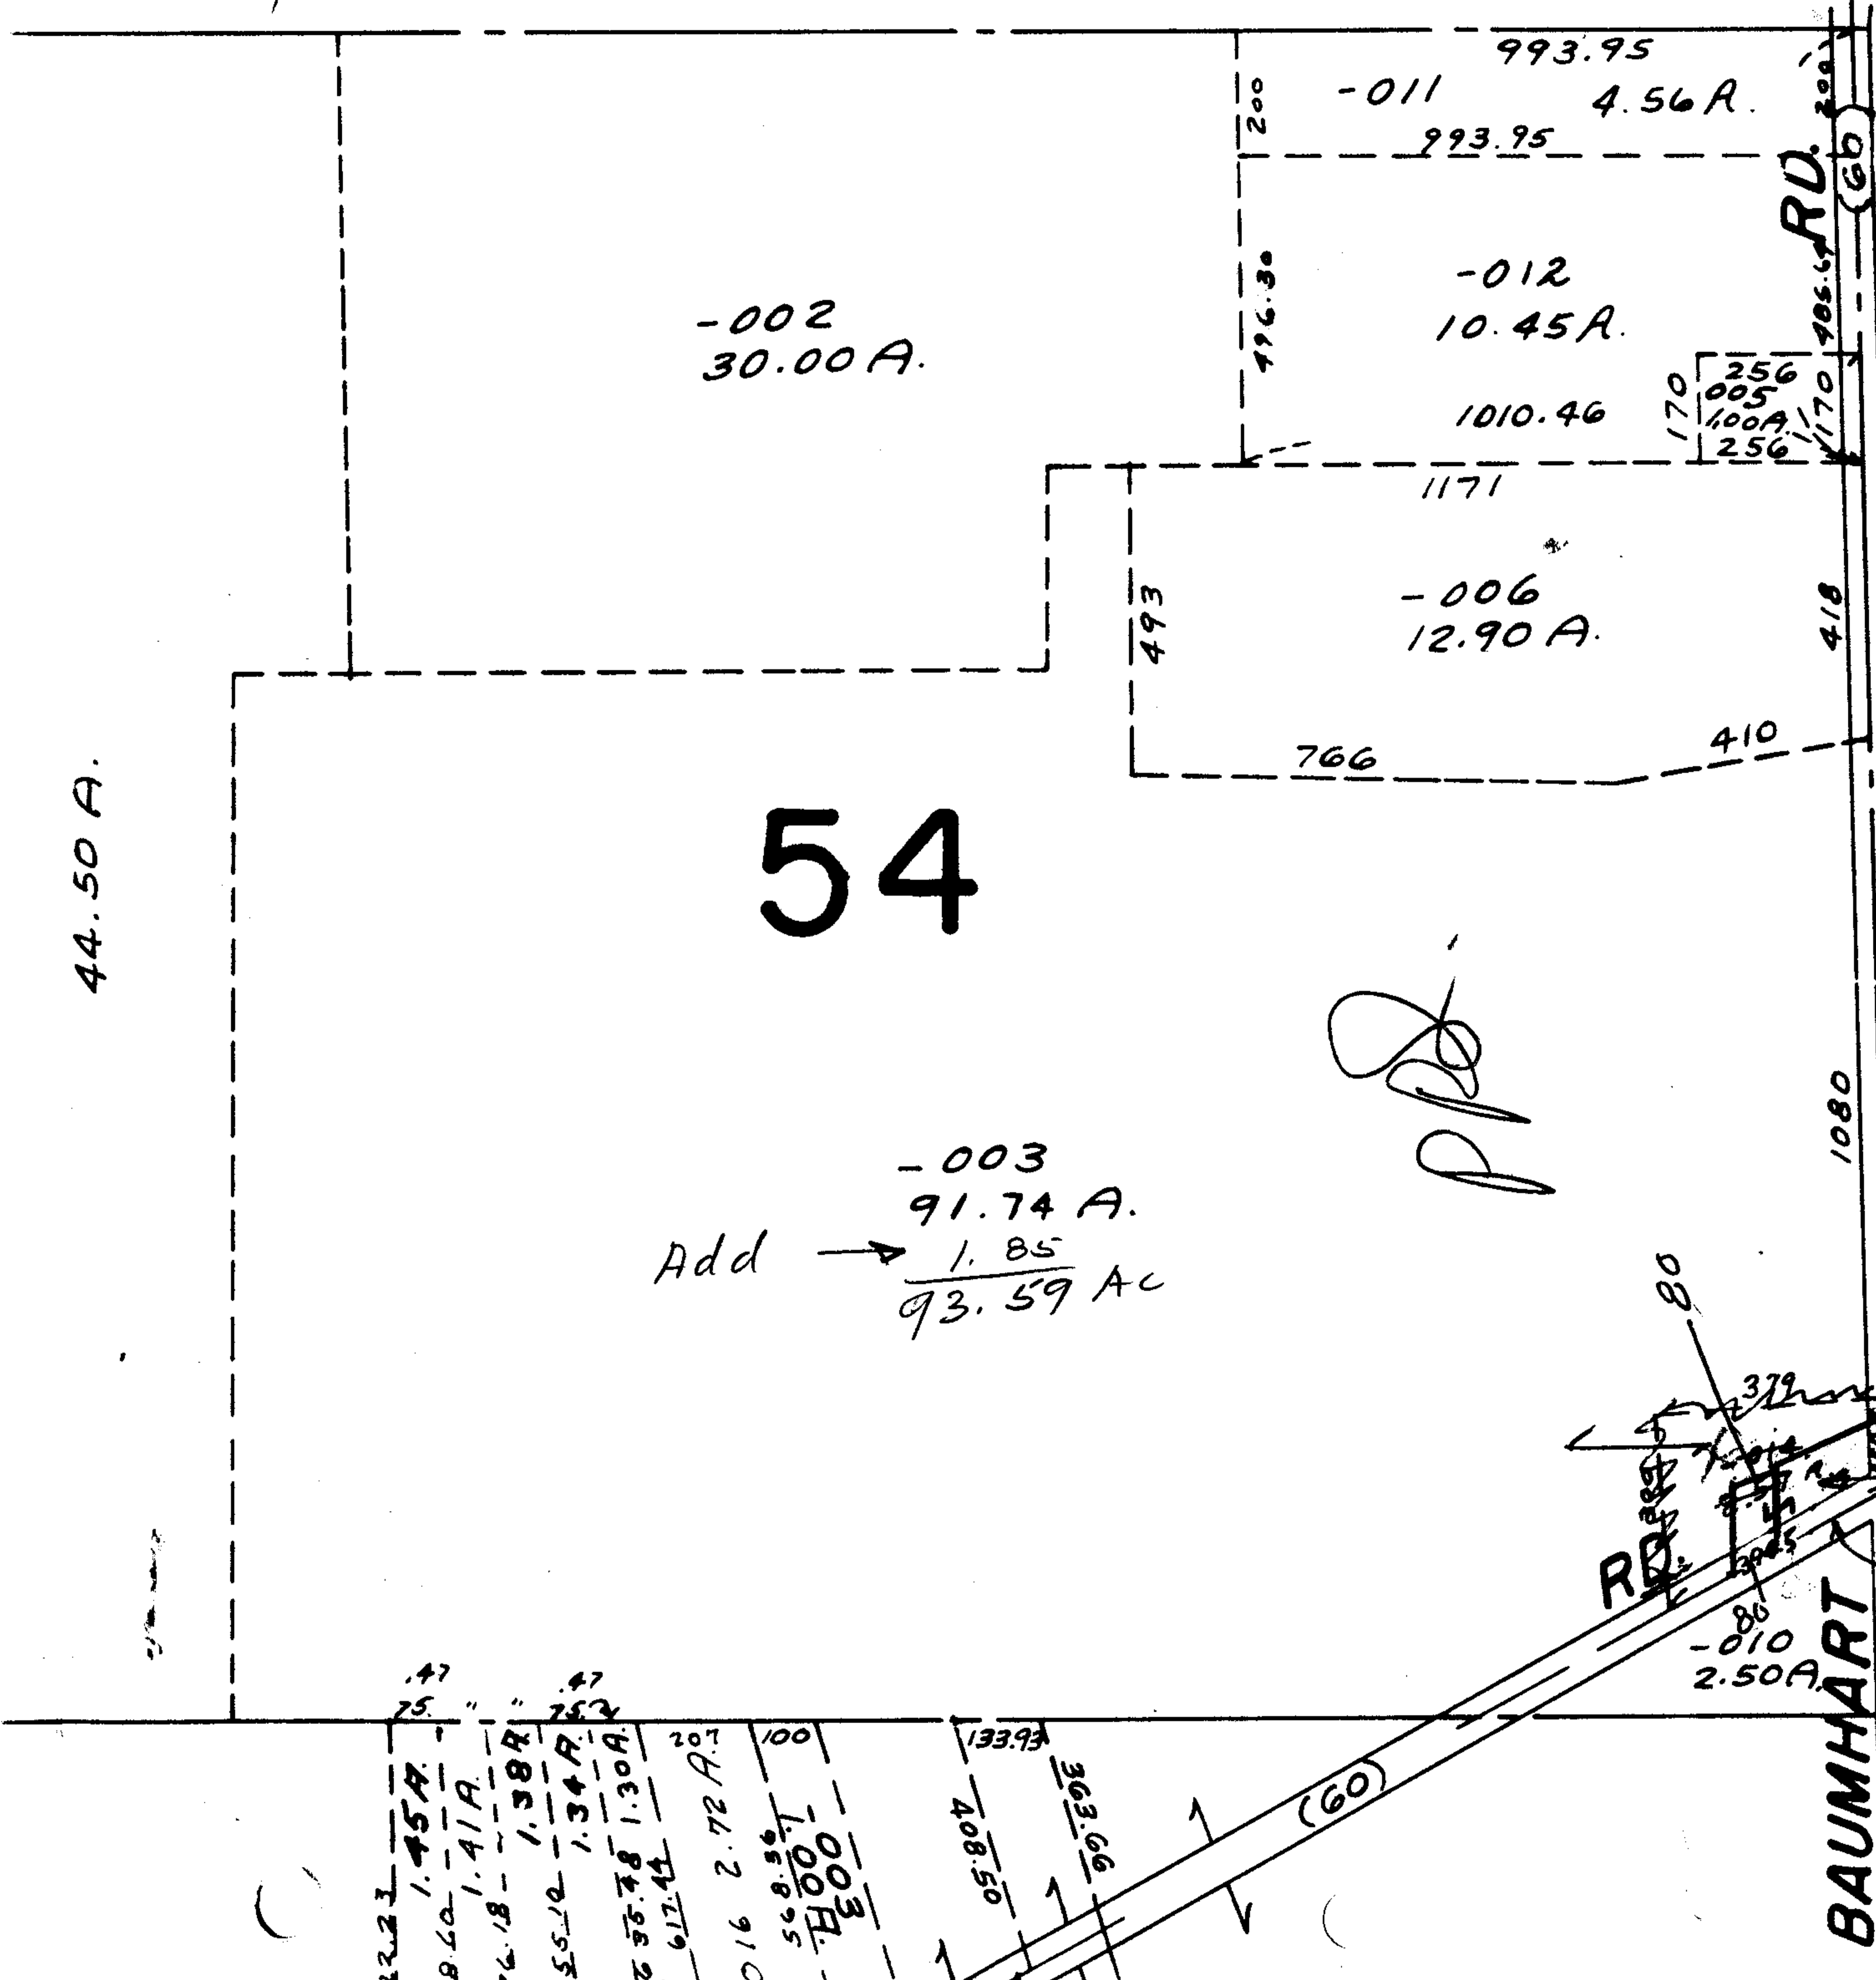

6970 **OK**

Map Correction

8-8-13-56

7701

APPROVED
LORAIN CO.
MAP DEPT.
DATE 1-28-74
SHEET 1-K
BY LWHall
VOID AFTER

Handwritten signature

44.50 A.

54

-003
91.74 A.
Add -> 1.85
93.59 AC

2223
1.45 A.
1.41 A.
1.38 A.
1.34 A.
1.30 A.
2.72 A.
1.00 A.
1.00 A.
1.00 A.

BAUMHART

214.50

172 AC
014

1080

-010
2.50 A.

(60)

(60)

200

196.30

493

766

1171

-006
12.90 A.

410

418

80

125.5

379

392.5

80

-010
2.50 A.

408.50

363.66

100

568.96

1000

100

568.96

1000

