


085
7792

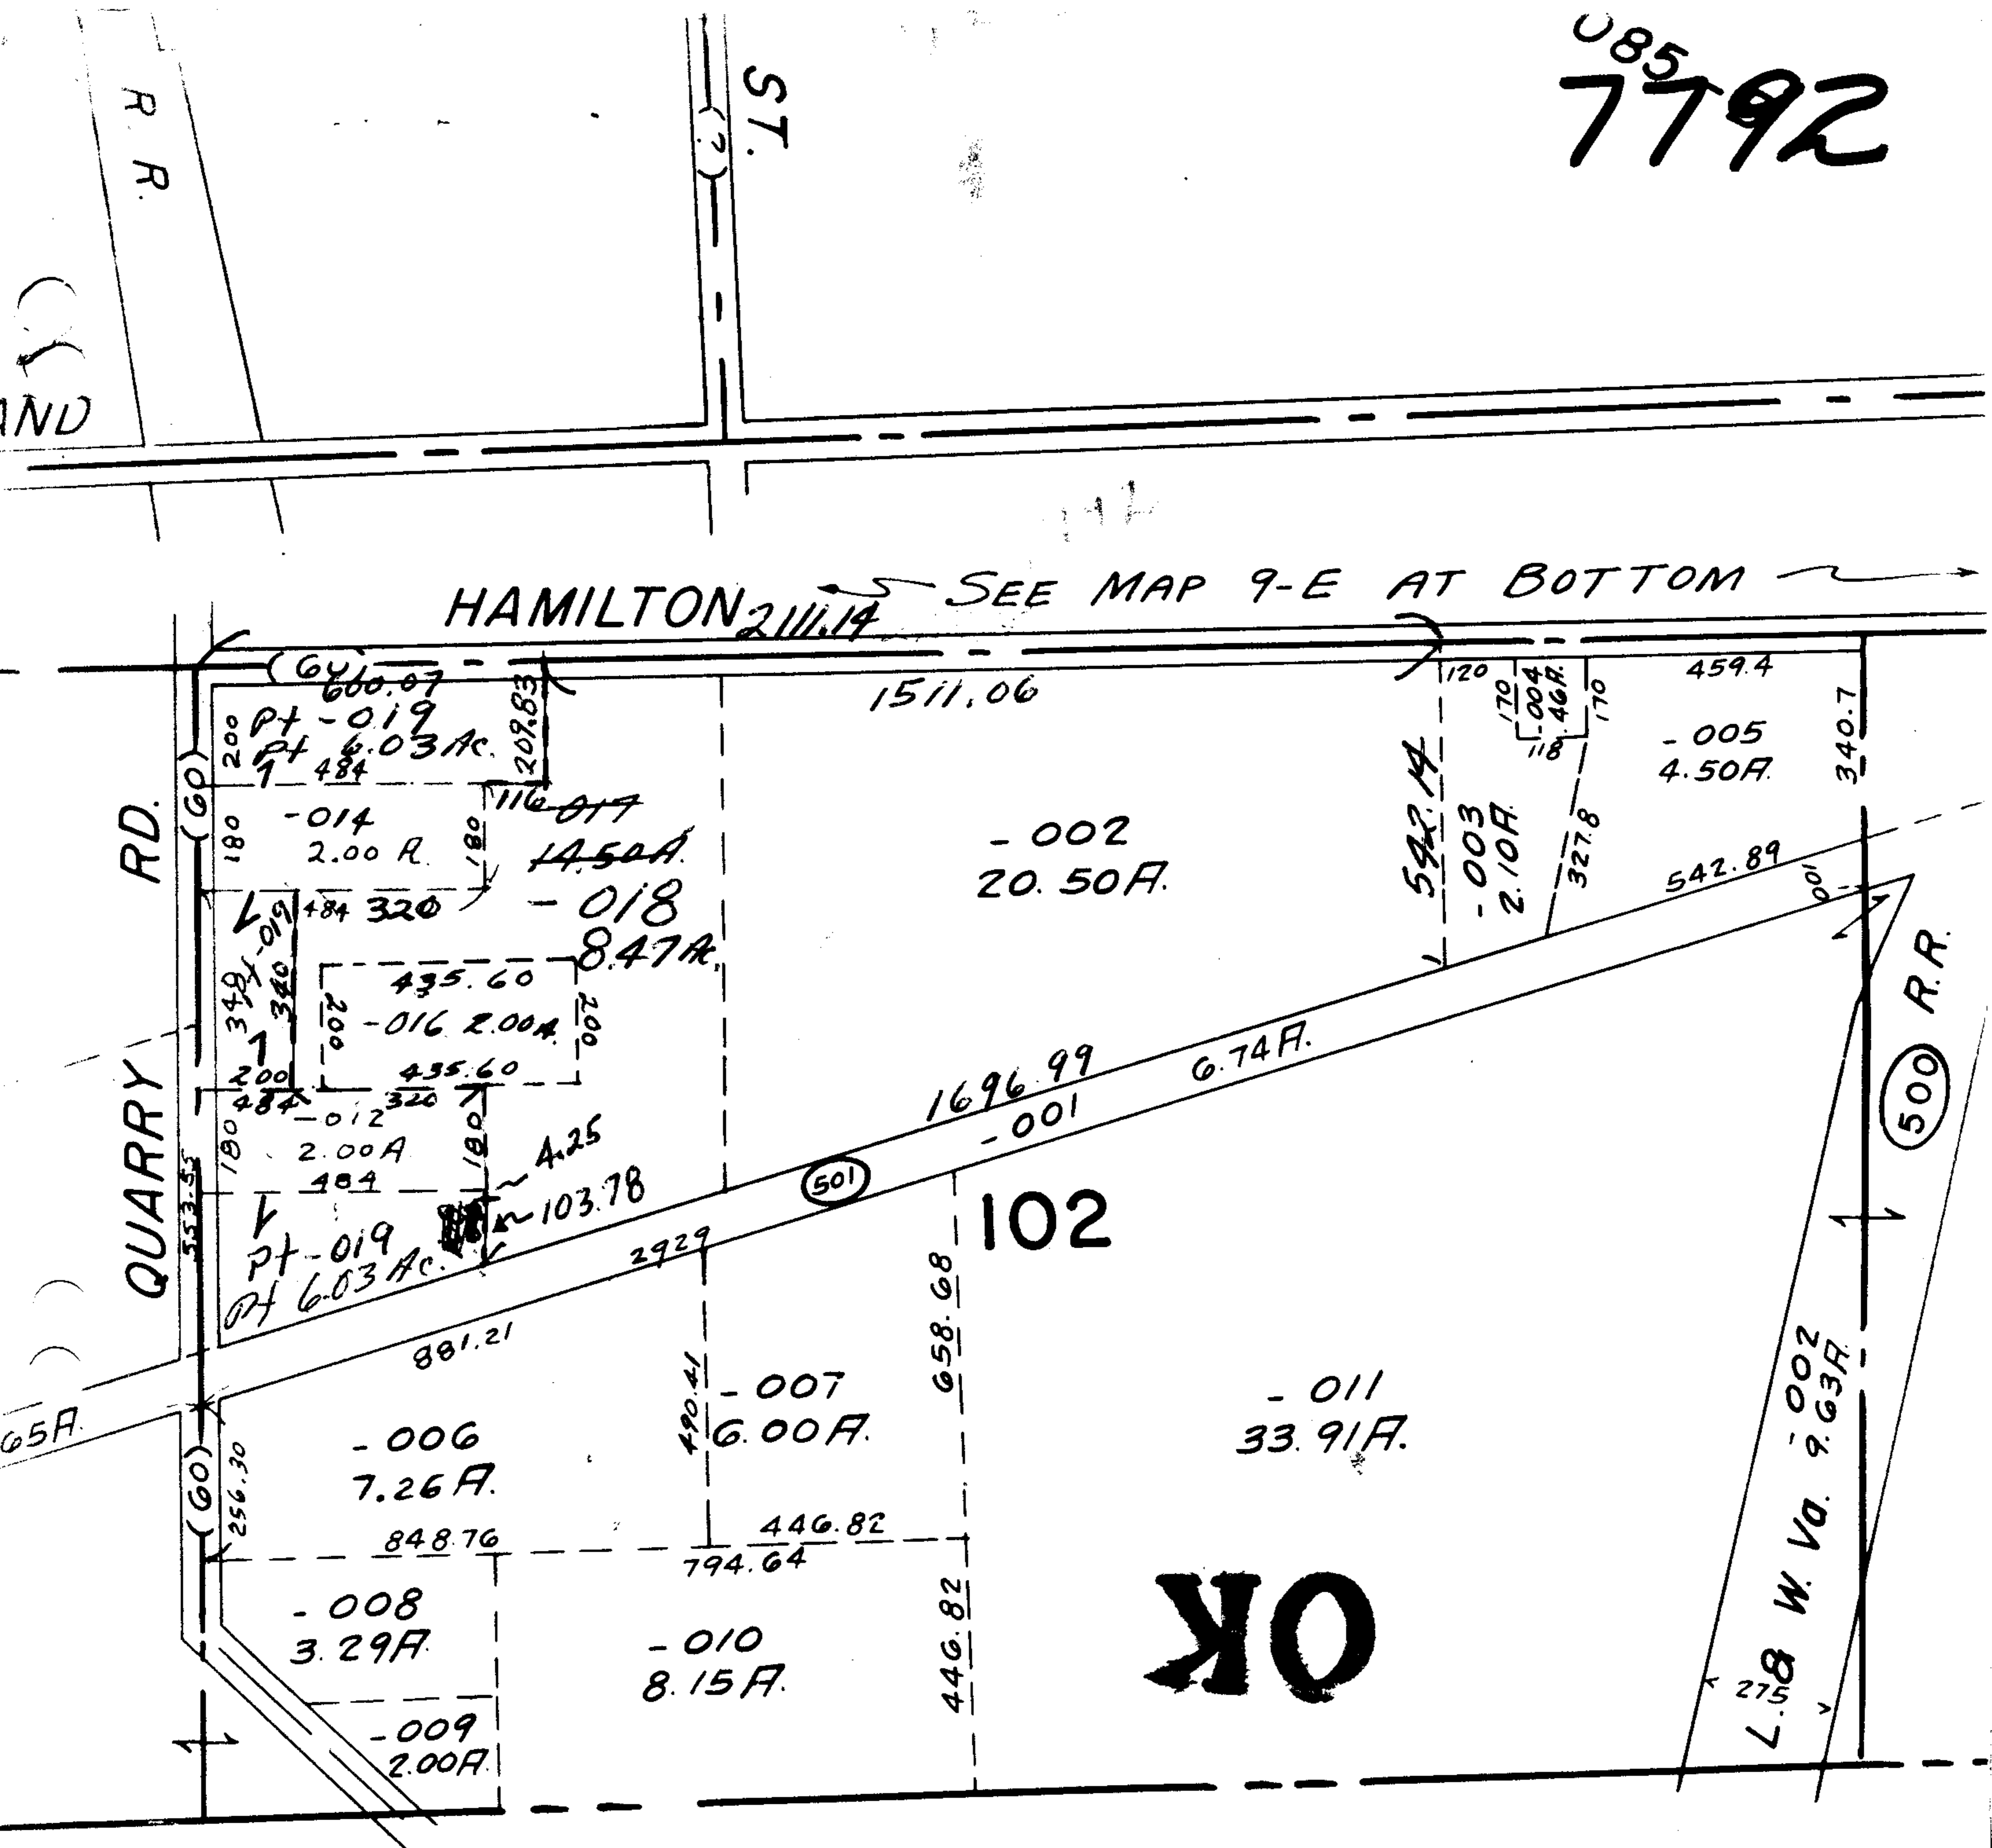

HAMILTON \rightarrow SEE MAP 9-E AT BOTTOM \leftarrow

OK

Paul

$$\begin{array}{r} 14.50 \\ 8.47 \\ \hline 6.03 \end{array}$$

$$\begin{array}{r} 1450 \\ 2050 \\ \hline 35 \\ 28 \end{array}$$

7792

APPROVED	
LORAIN CO.	
MAP DEPT.	
DATE	3-1-74
PAGE	9-A
BY	Paul
VOID AFTER	