

7797

ake

Correction Acreage
By Survey

Low Water Mark



E r i e

OK

7797

APPROVED
LORAIN CO.
MAP DEPT.
DATE 3-6-74
PAGE 3-00-049A
BY L.W. Hall
VOID AFTER

S.S. 81388

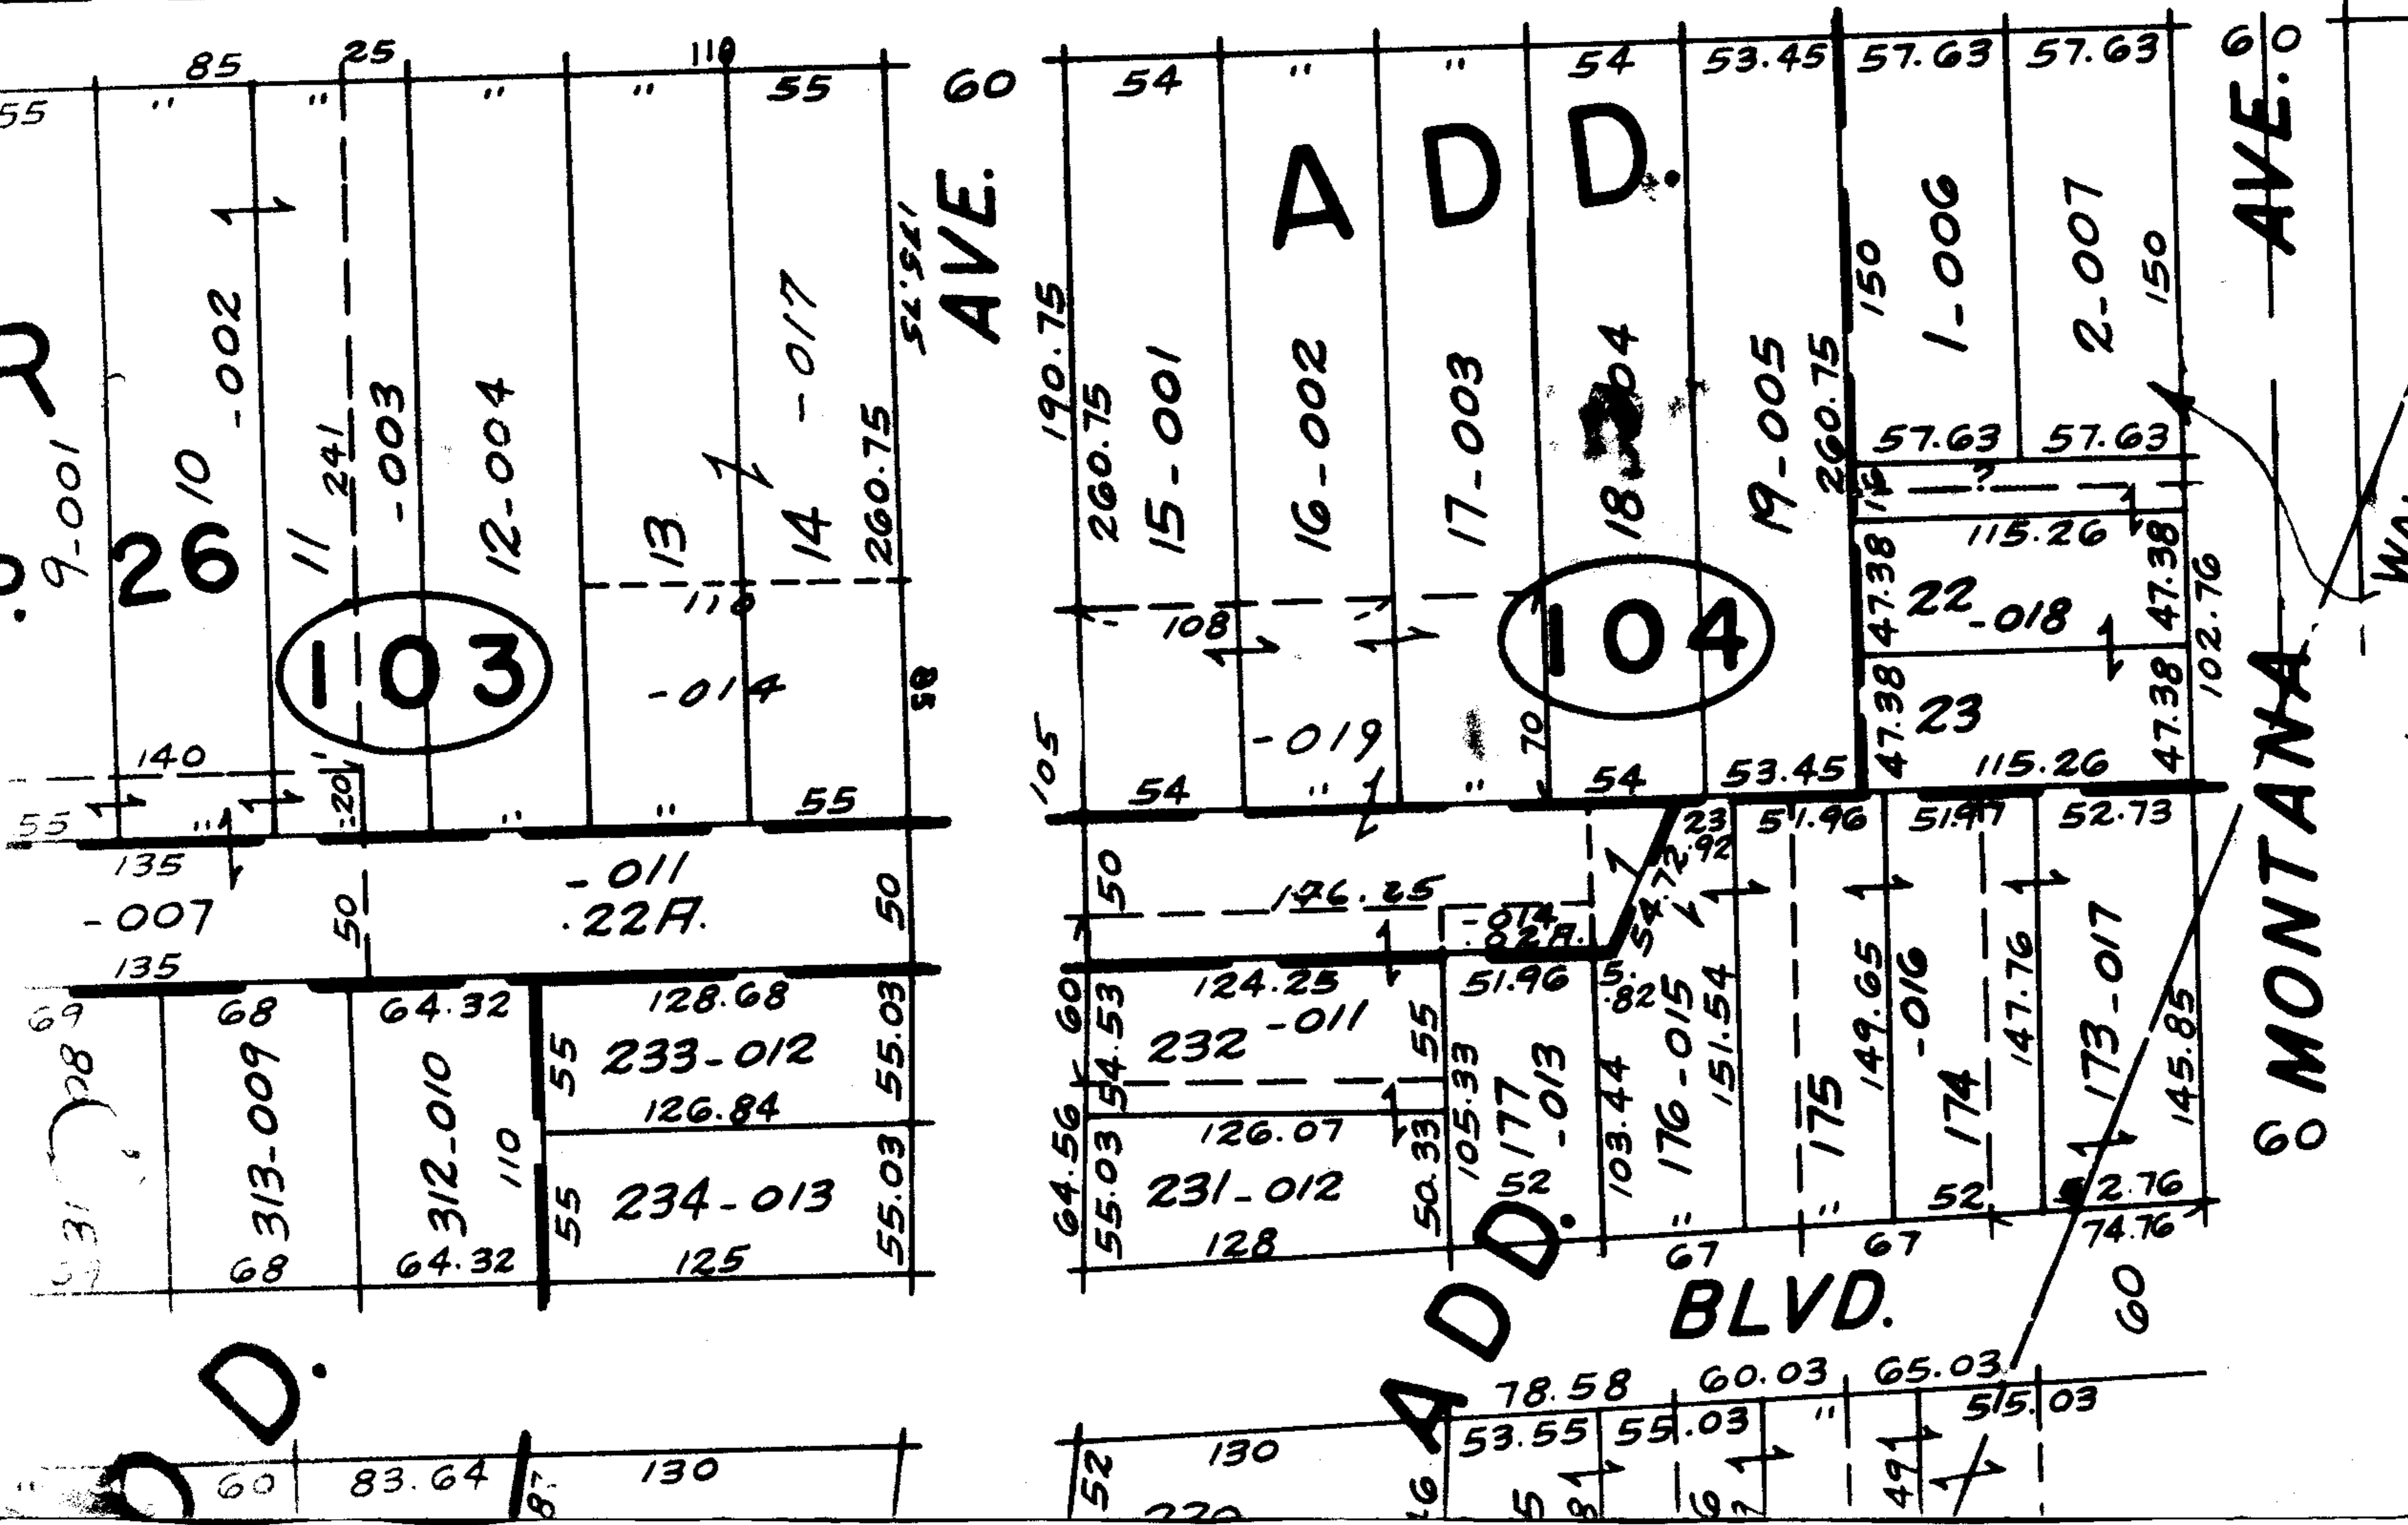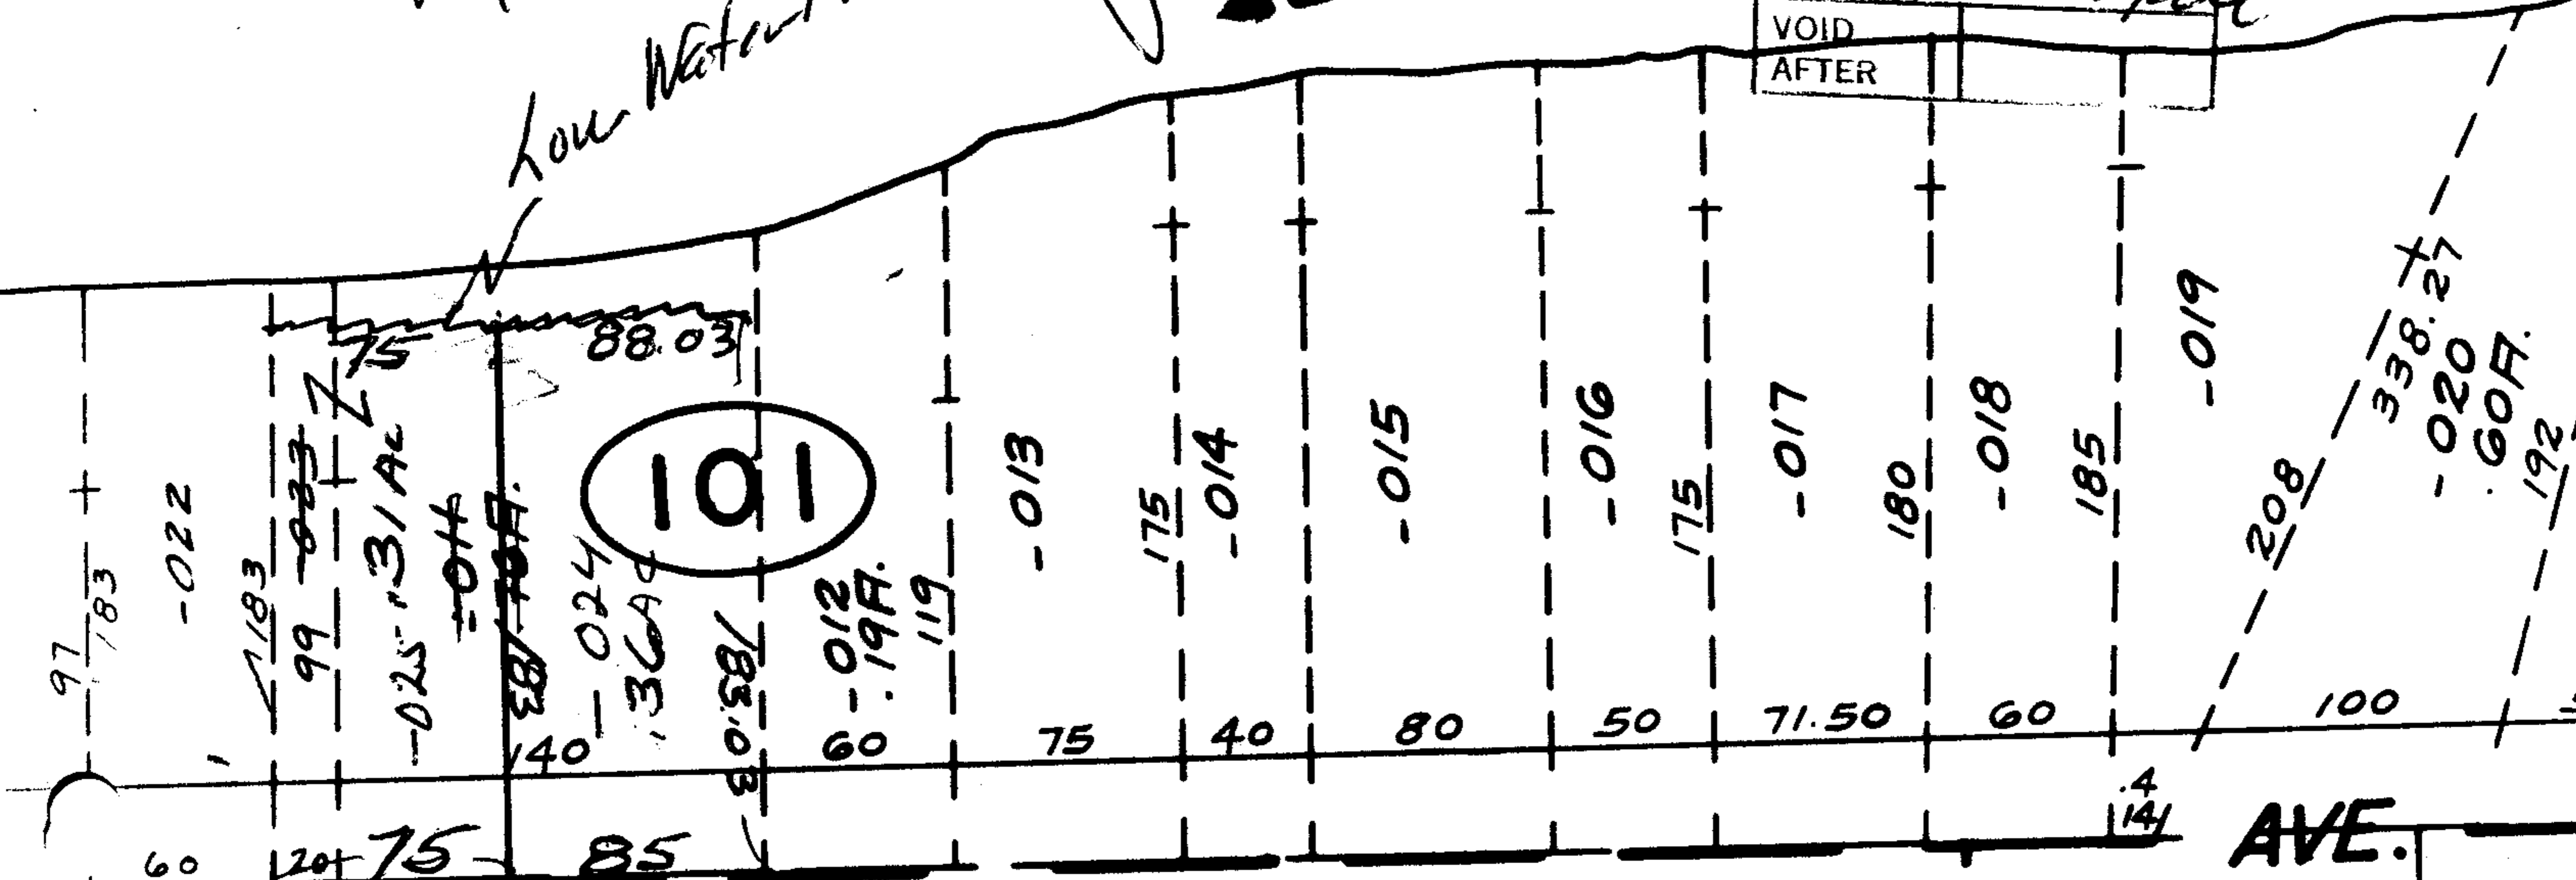

D.

ADD.

BLVD.

MONTANA

AVE. 0