



7812

-009
26.95 A.

29

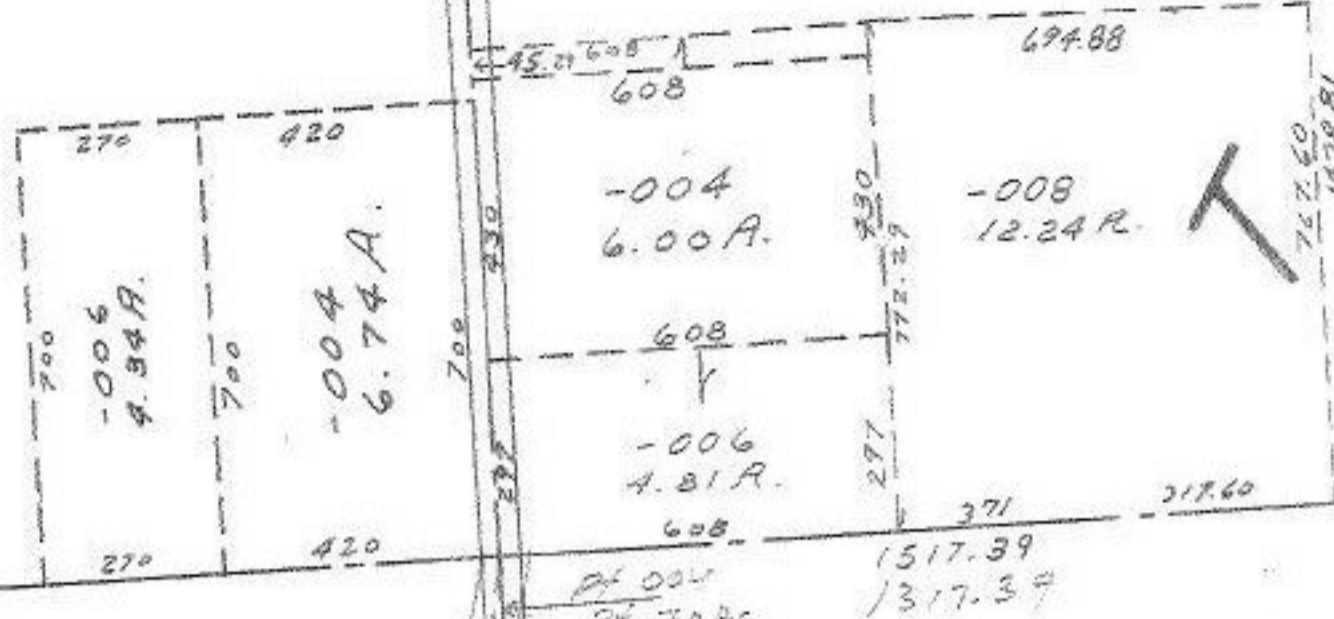

7812
 APPROVED
 LORAIN CO.
 MAP DEPT.
 DATE ~~4-16-74~~
 7-5-84
 PAGE 21A
 BY L.W. Hall
 VOID
 AFTER

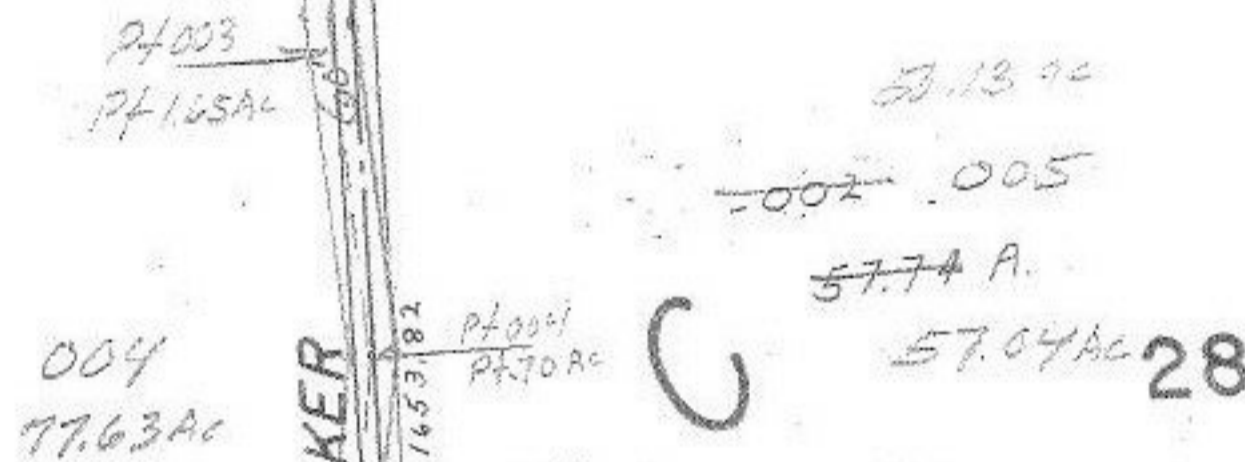

2.8.
 8-5-86
 Pt 003
 Pt 1.65 AC

BAKER



A

NO

PR

SE