


7820

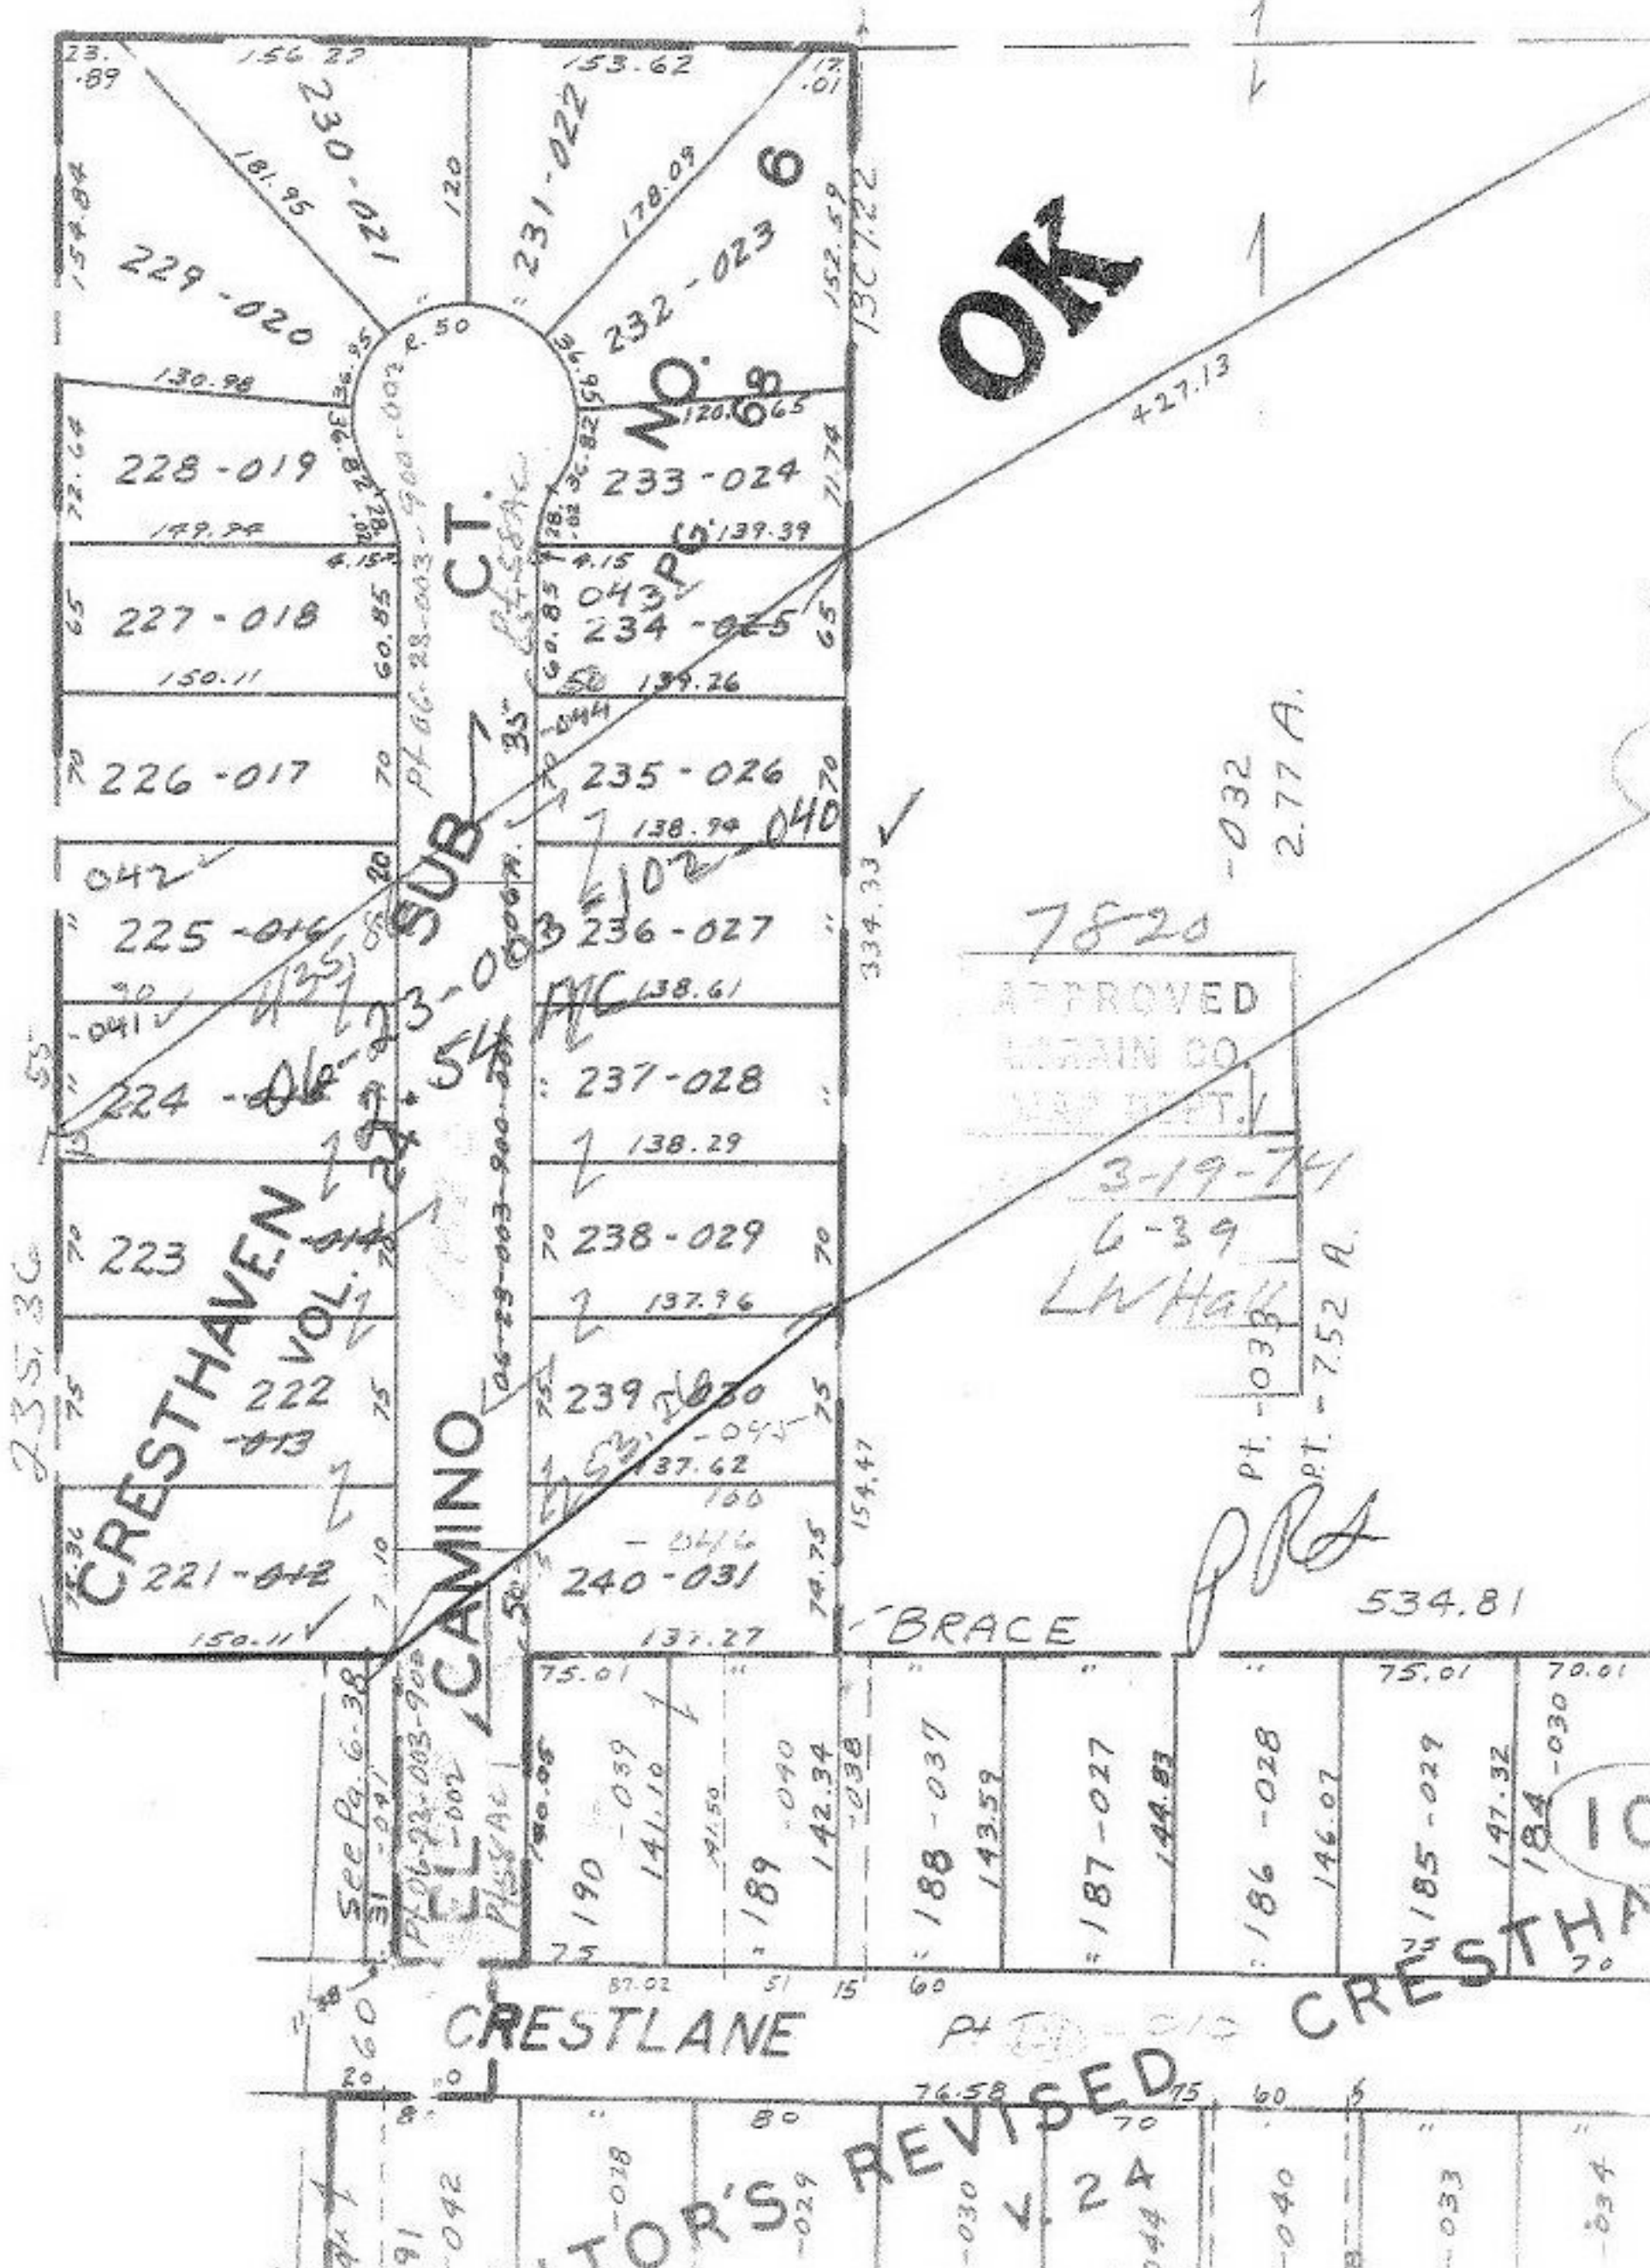

OK

7820
 APPROVED
 LORAIN CO.
 MAP DEPT.

3-19-74
 6-39
 LW Hall

PT. -038
 PPT. -7.52 A.

CRESTLANE

CRESTHAVEN

REVISOR'S
 4-030
 4-2A
 044
 -040
 -033
 -034

10