

500


7827

#7866

771

-031
15.00 A.

also number
corrected
#7866
4-5-79.

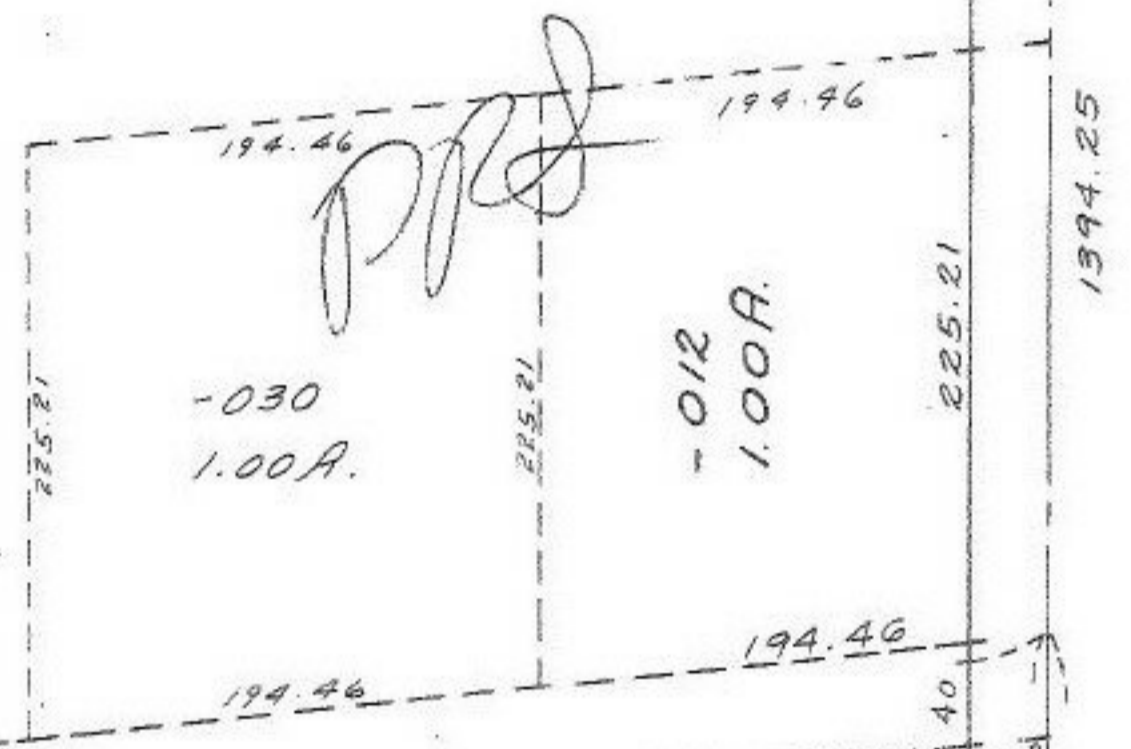

027
1.20 A

689


158

-035 Corrected No

-032 +

5.00 A.

4.73 A.

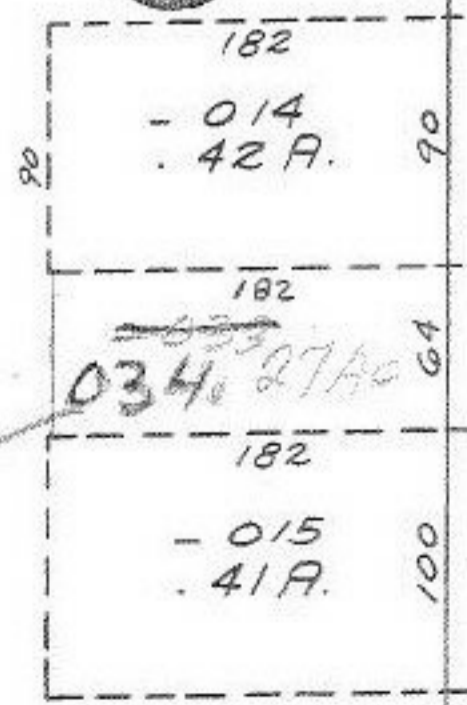

JAGUAY 455

650

7827

APPROVED
LORAIN CO.
MAP DEPT.

DATE 3-20-79

PAGE 1 of 26

BY [Signature]

VOID
IF CUT

g. g.
7-29-86

684

7827