


7833

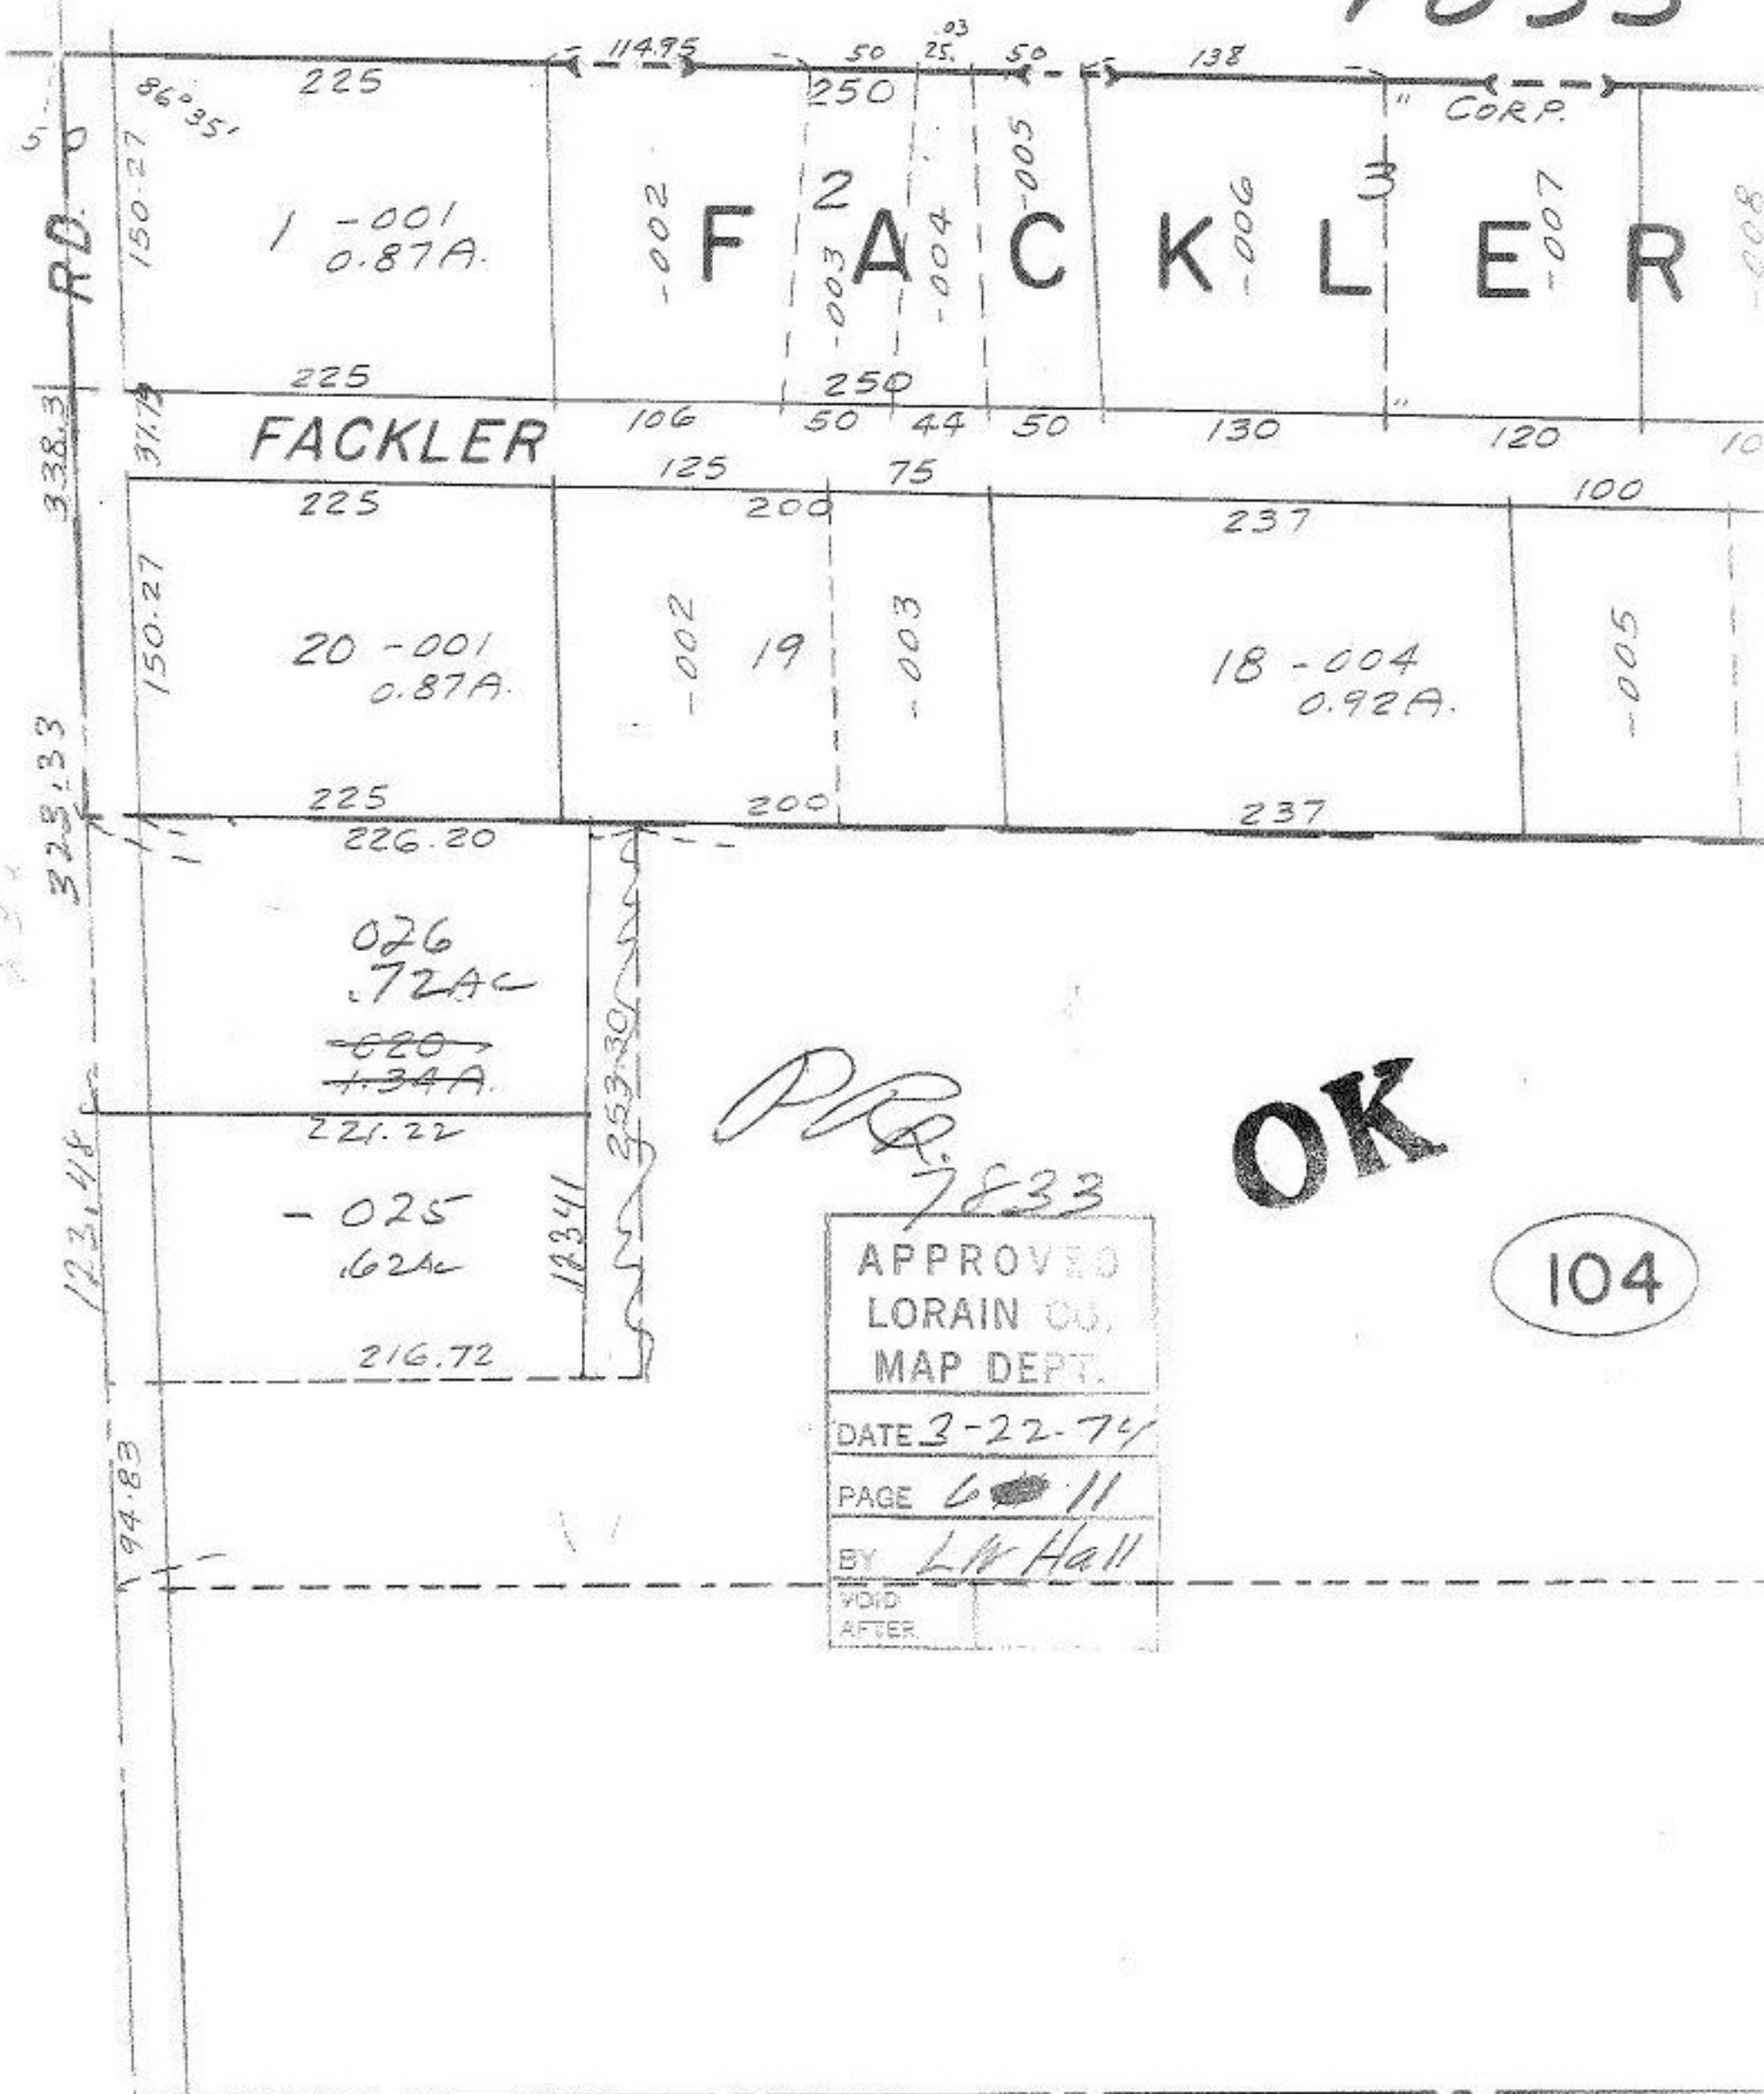

FACKLER

FACKLER

OK

*PP*  
7833

104

APPROVED  
 LORAIN CO.  
 MAP DEPT.  
 DATE 3-22-74  
 PAGE 6 of 11  
 BY L.W. Hall  
 VOID  
 AFTER

RD. 0  
 5'  
 338.3  
 328.33  
 123.48  
 94.83

150.27  
 37.75  
 150.27  
 11'

226.20  
 221.22  
 216.72

123.41  
 253.30

225  
 225  
 225  
 225

114.95  
 50  
 25<sup>03</sup>  
 50  
 138  
 106  
 50  
 44  
 50  
 130  
 120  
 100  
 200  
 75  
 237  
 100  
 200  
 237

86°35'  
 1 -001  
 0.87A.  
 20 -001  
 0.87A.  
 026  
 72AC  
~~620~~  
~~134A~~  
 -025  
 62AC

-002  
 -003  
 -004  
 -005  
 -006  
 -007  
 -008

" CORP.  
 " " " " " "