



8.71  
.48  
7.63

7332


7330

SEE 5-00-032-A

**OK**

APPROVED  
LORAIN CO.  
MAP DEPT.  
DATE 5-24-73  
5-00-029B  
BY L.W. Hall

*L.W. Hall*

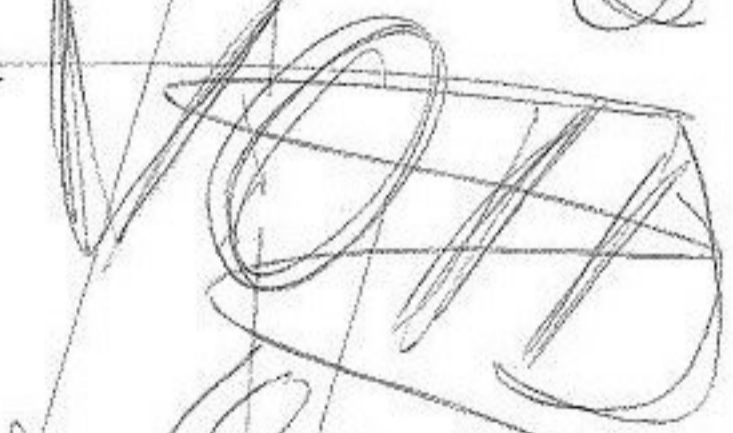

2-19-74

VA. 500 R.R.

-039  
1.21 AC.

274  
H&AK  
051

352  
1.64 AC  
8-11-74

Spur Road  
3-19-74

-041  
4.38 A.

799.93  
121.66

340.32

552.57

375.58  
464.75

446.41

631

575.47

635.5

195.84

15.45

150

360

329.53

423.50

210

7331

7-31-86 L.L.

2-19-74