


7840

SEE 7-00-027-B

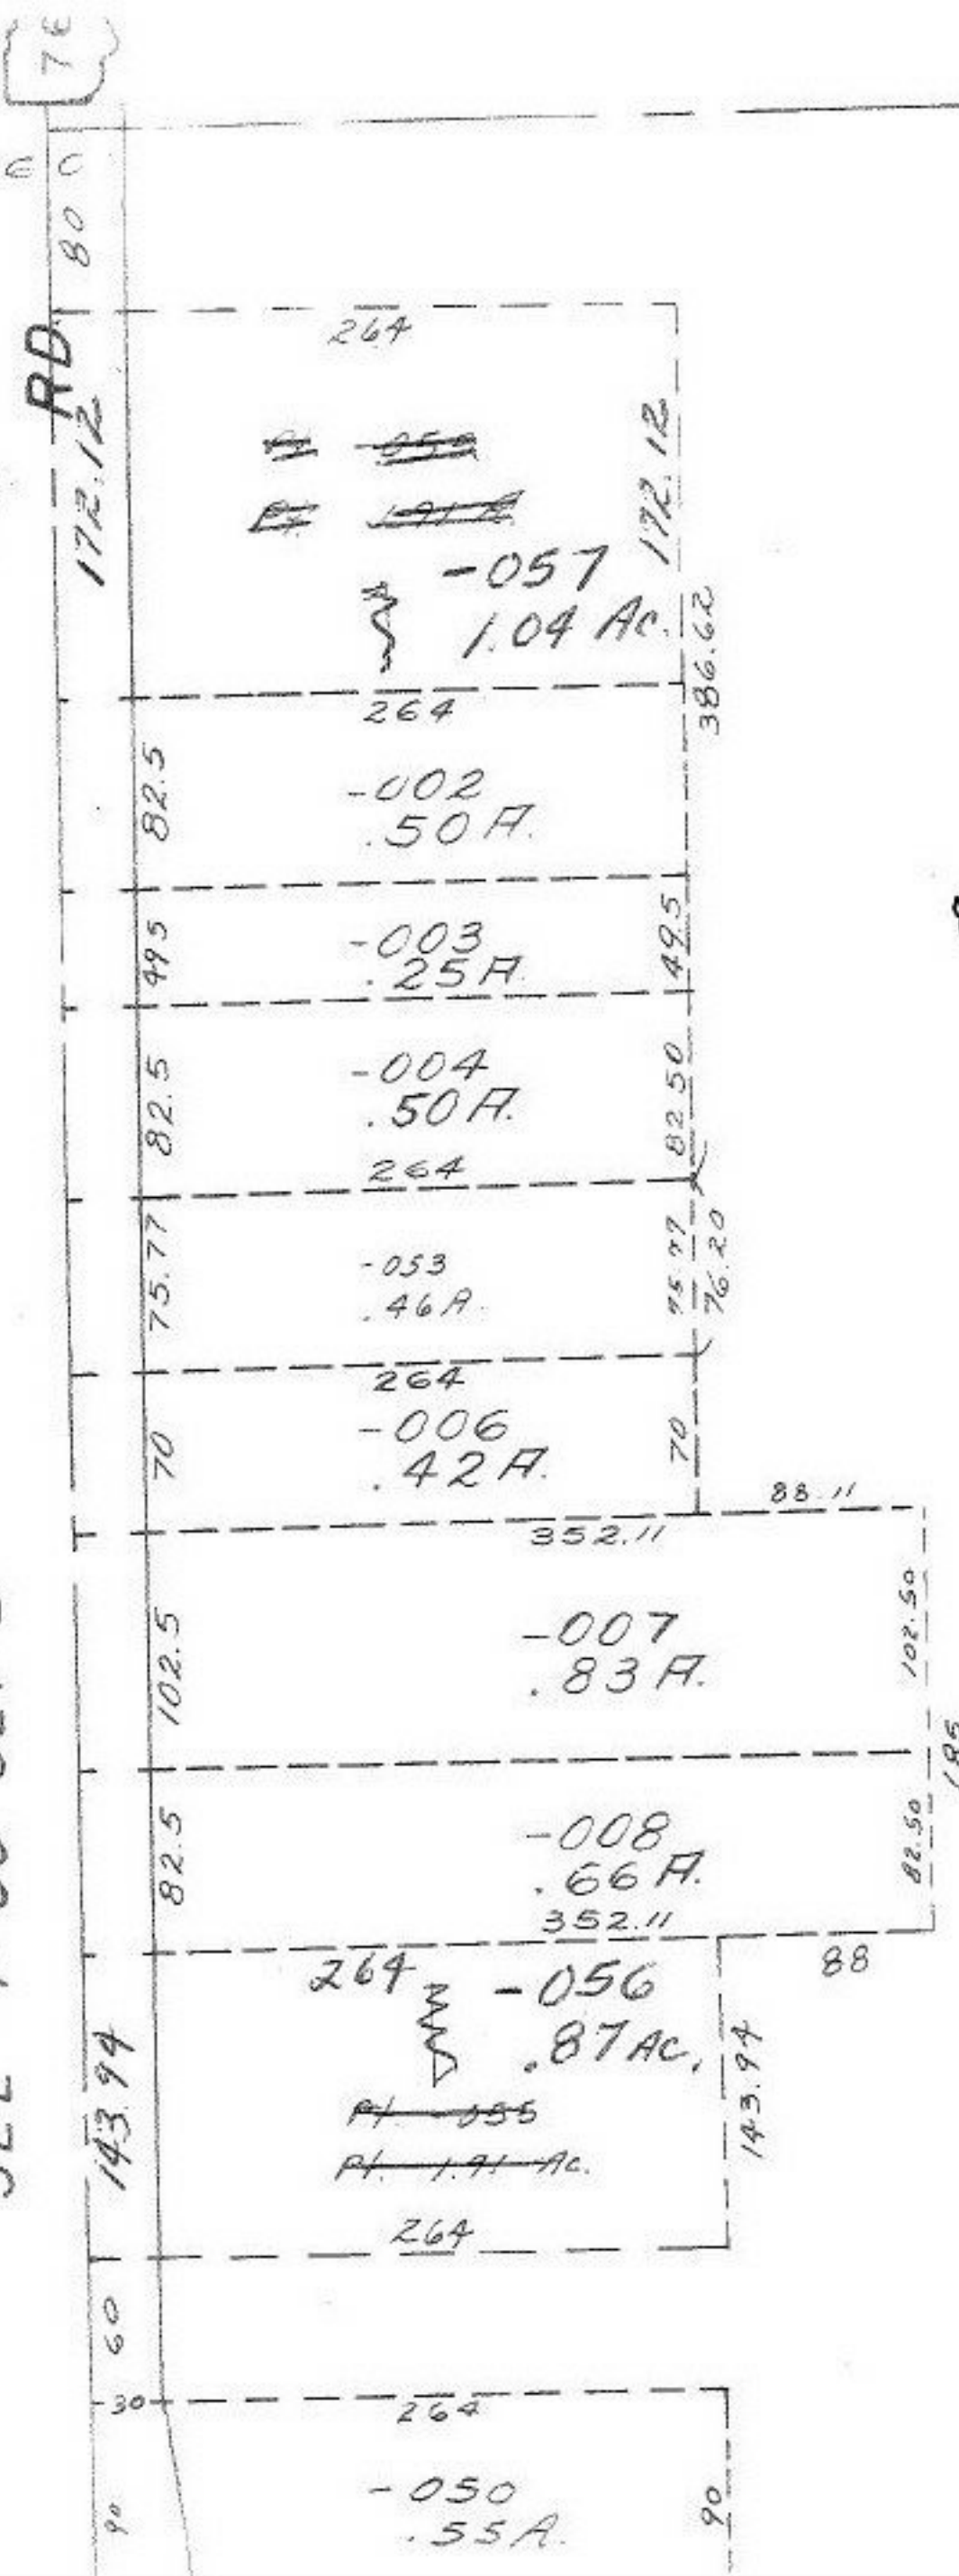

[Handwritten signature]

see survey

OK

7840

7-31-81a k.k.	APPROVED	
	LORAIN CO.	
	MAP DEPT.	
	DATE 3-28-74	
	PAGE 7-00-022-A	
BY	Paul	
VOID AFTER		