


7844


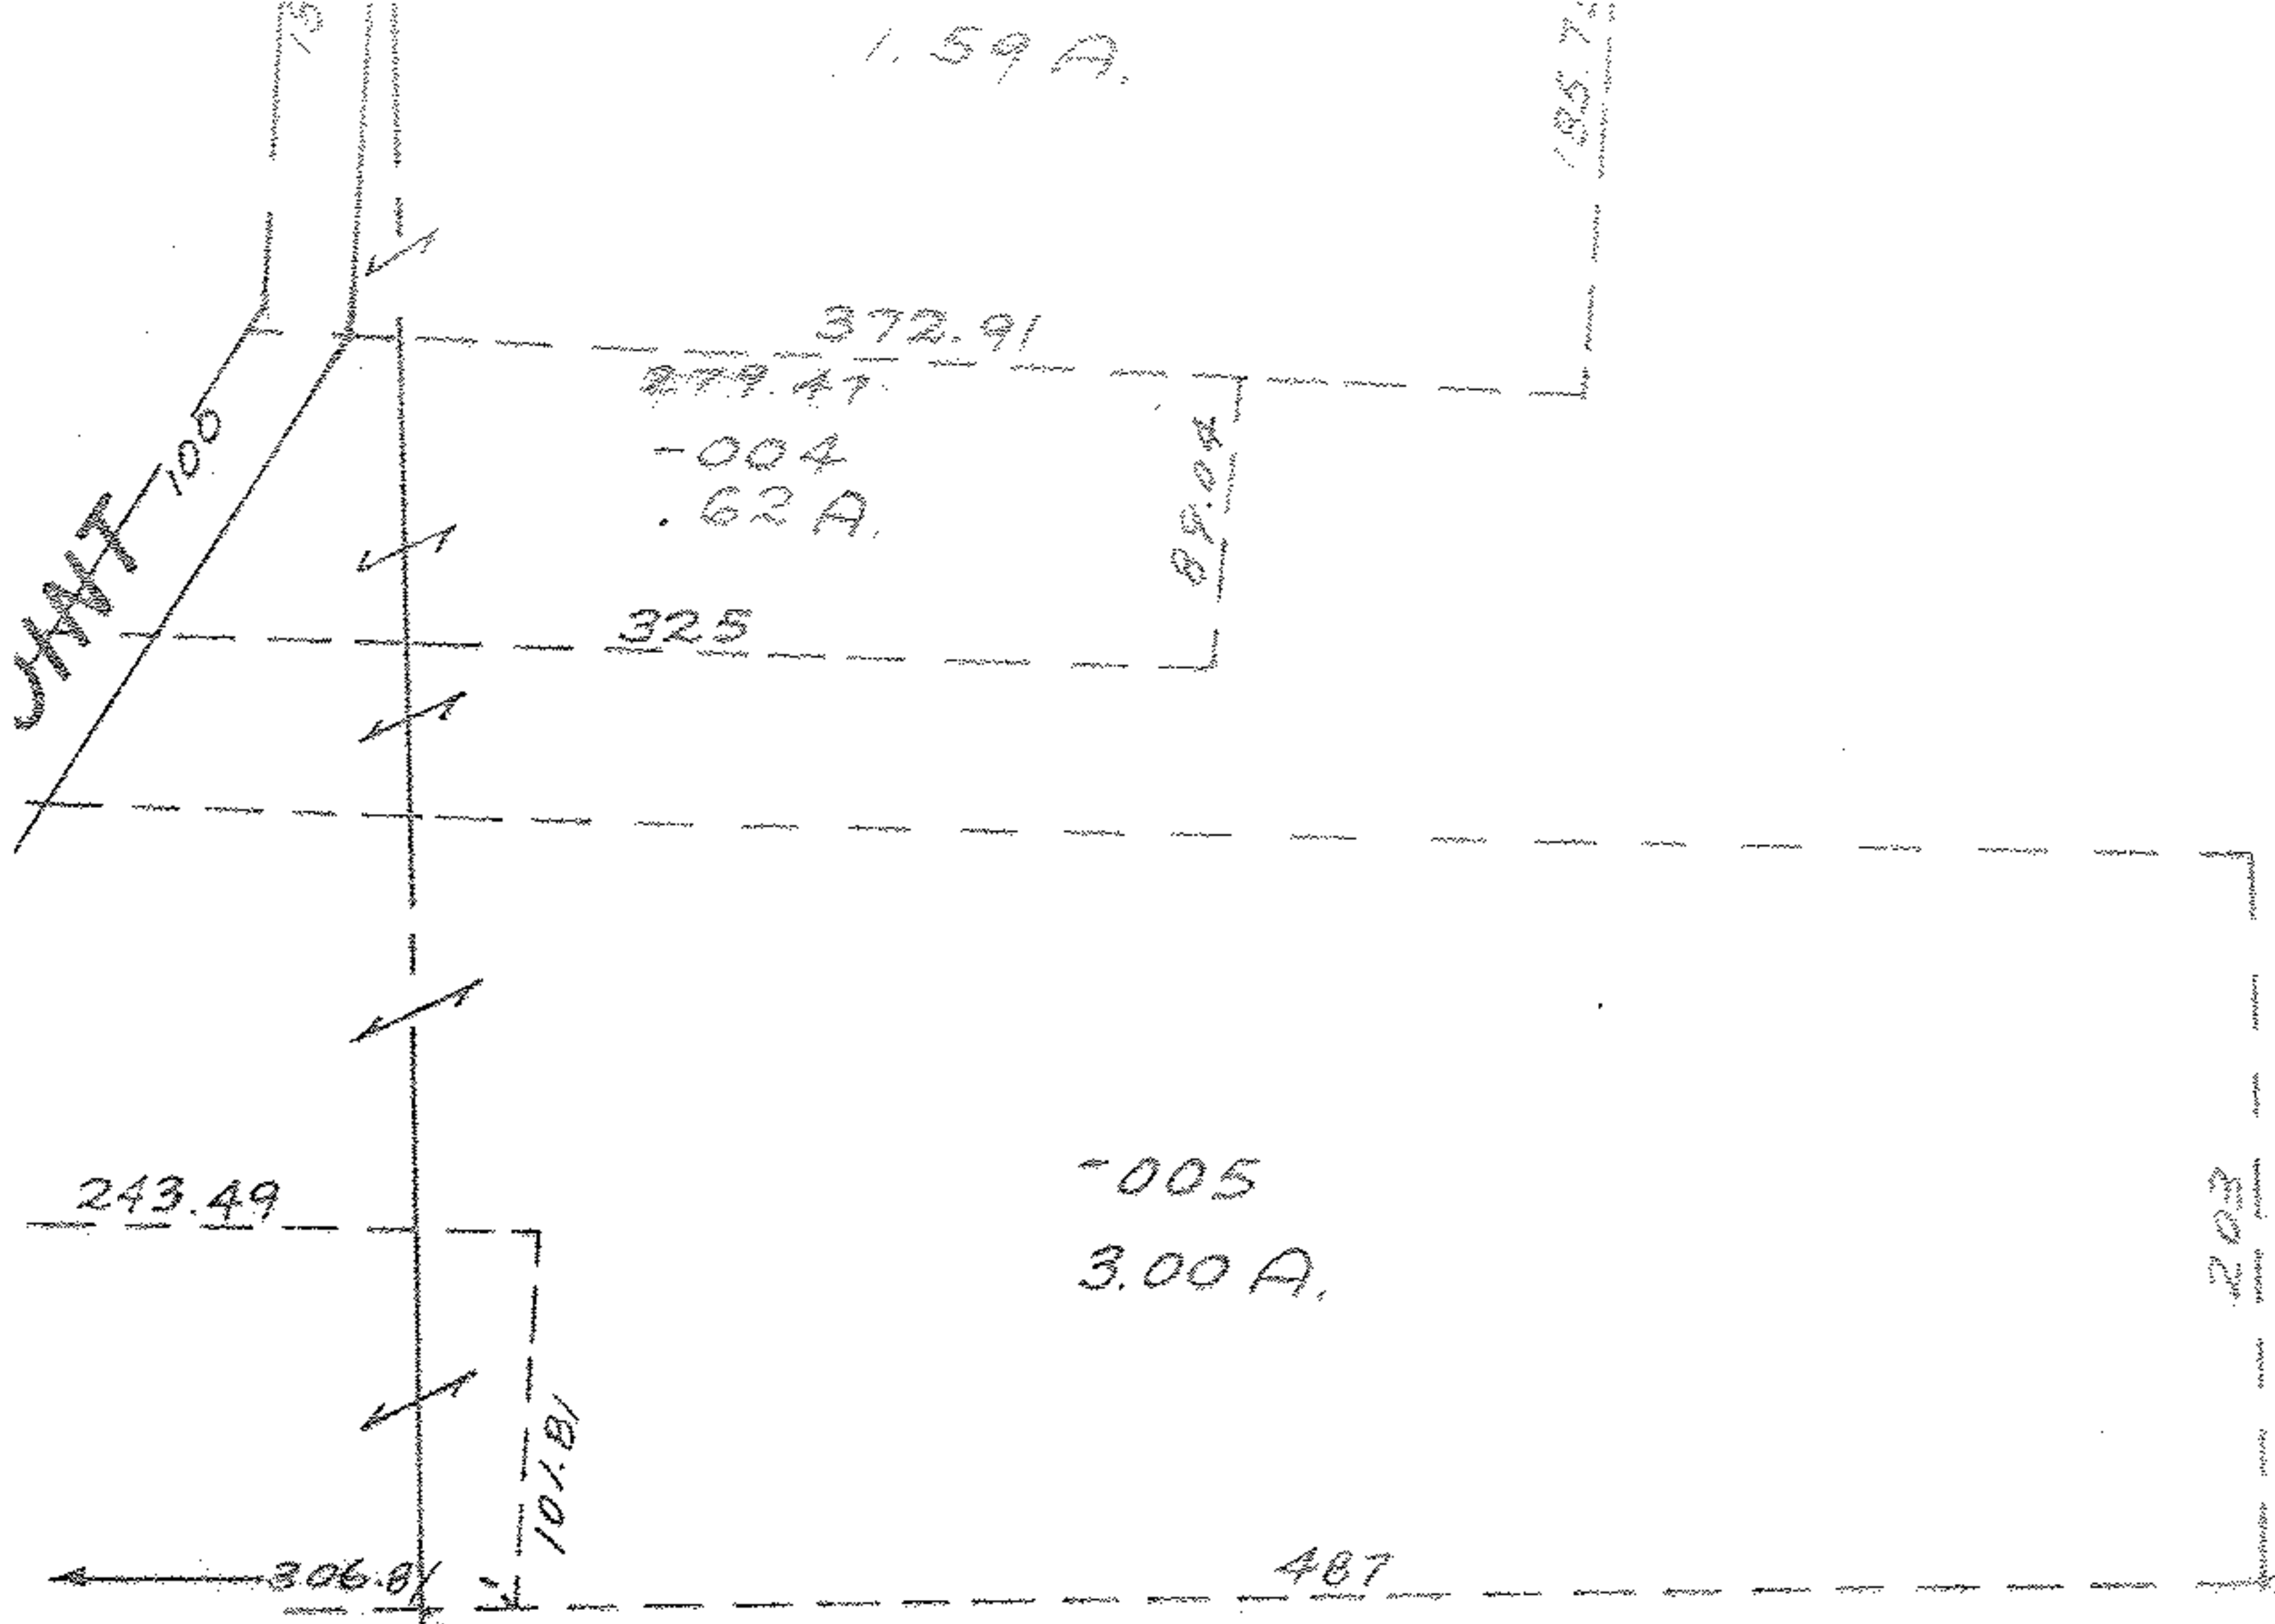


7844

7844

101

050
PT. -006
PT. 10-35 A.
8.74 AC

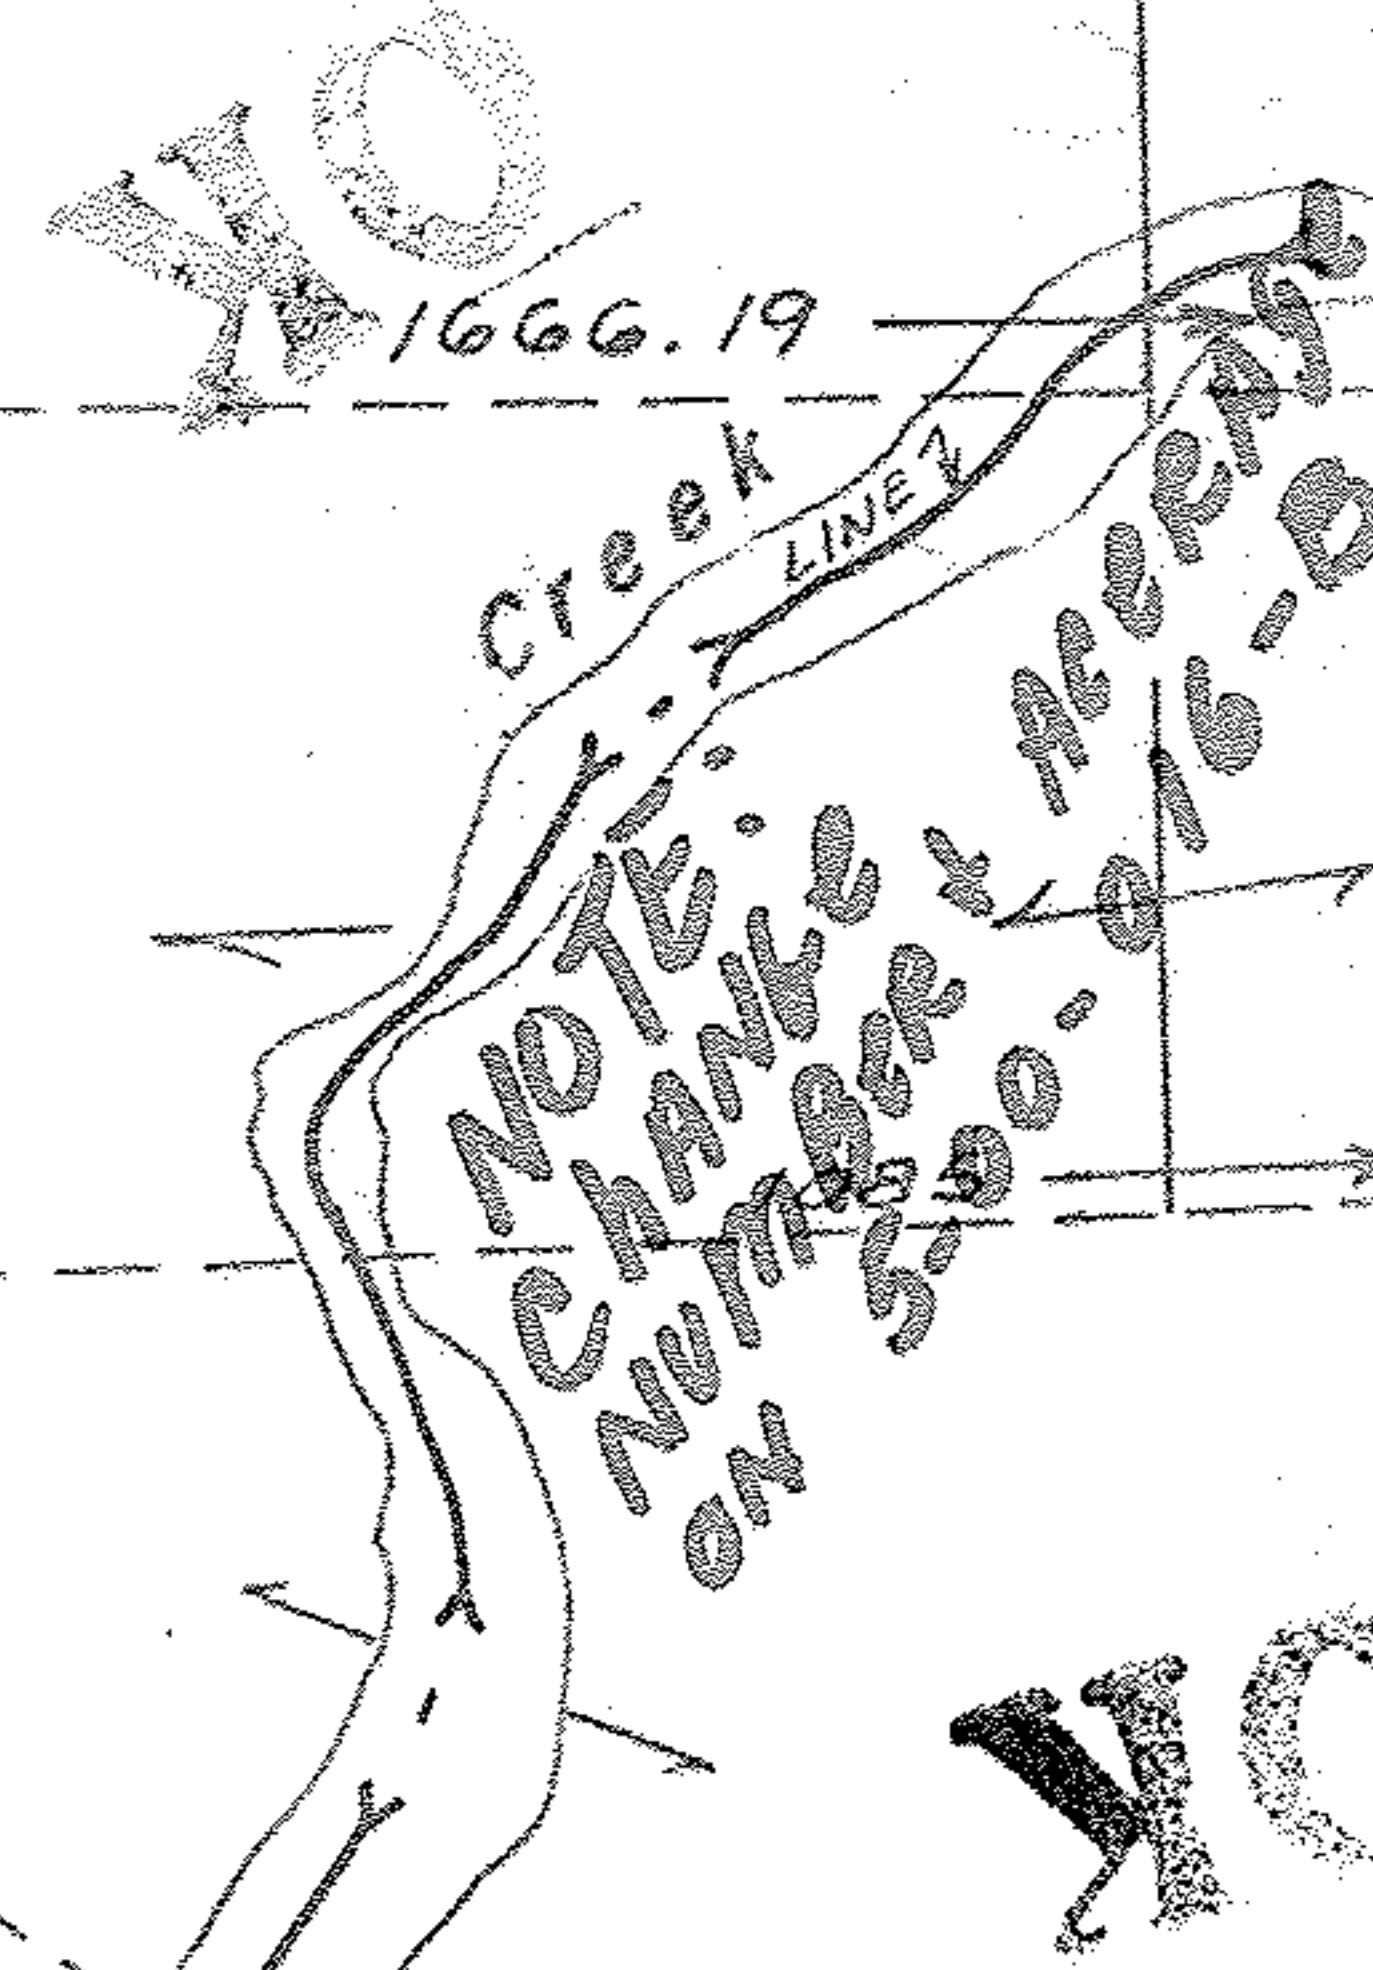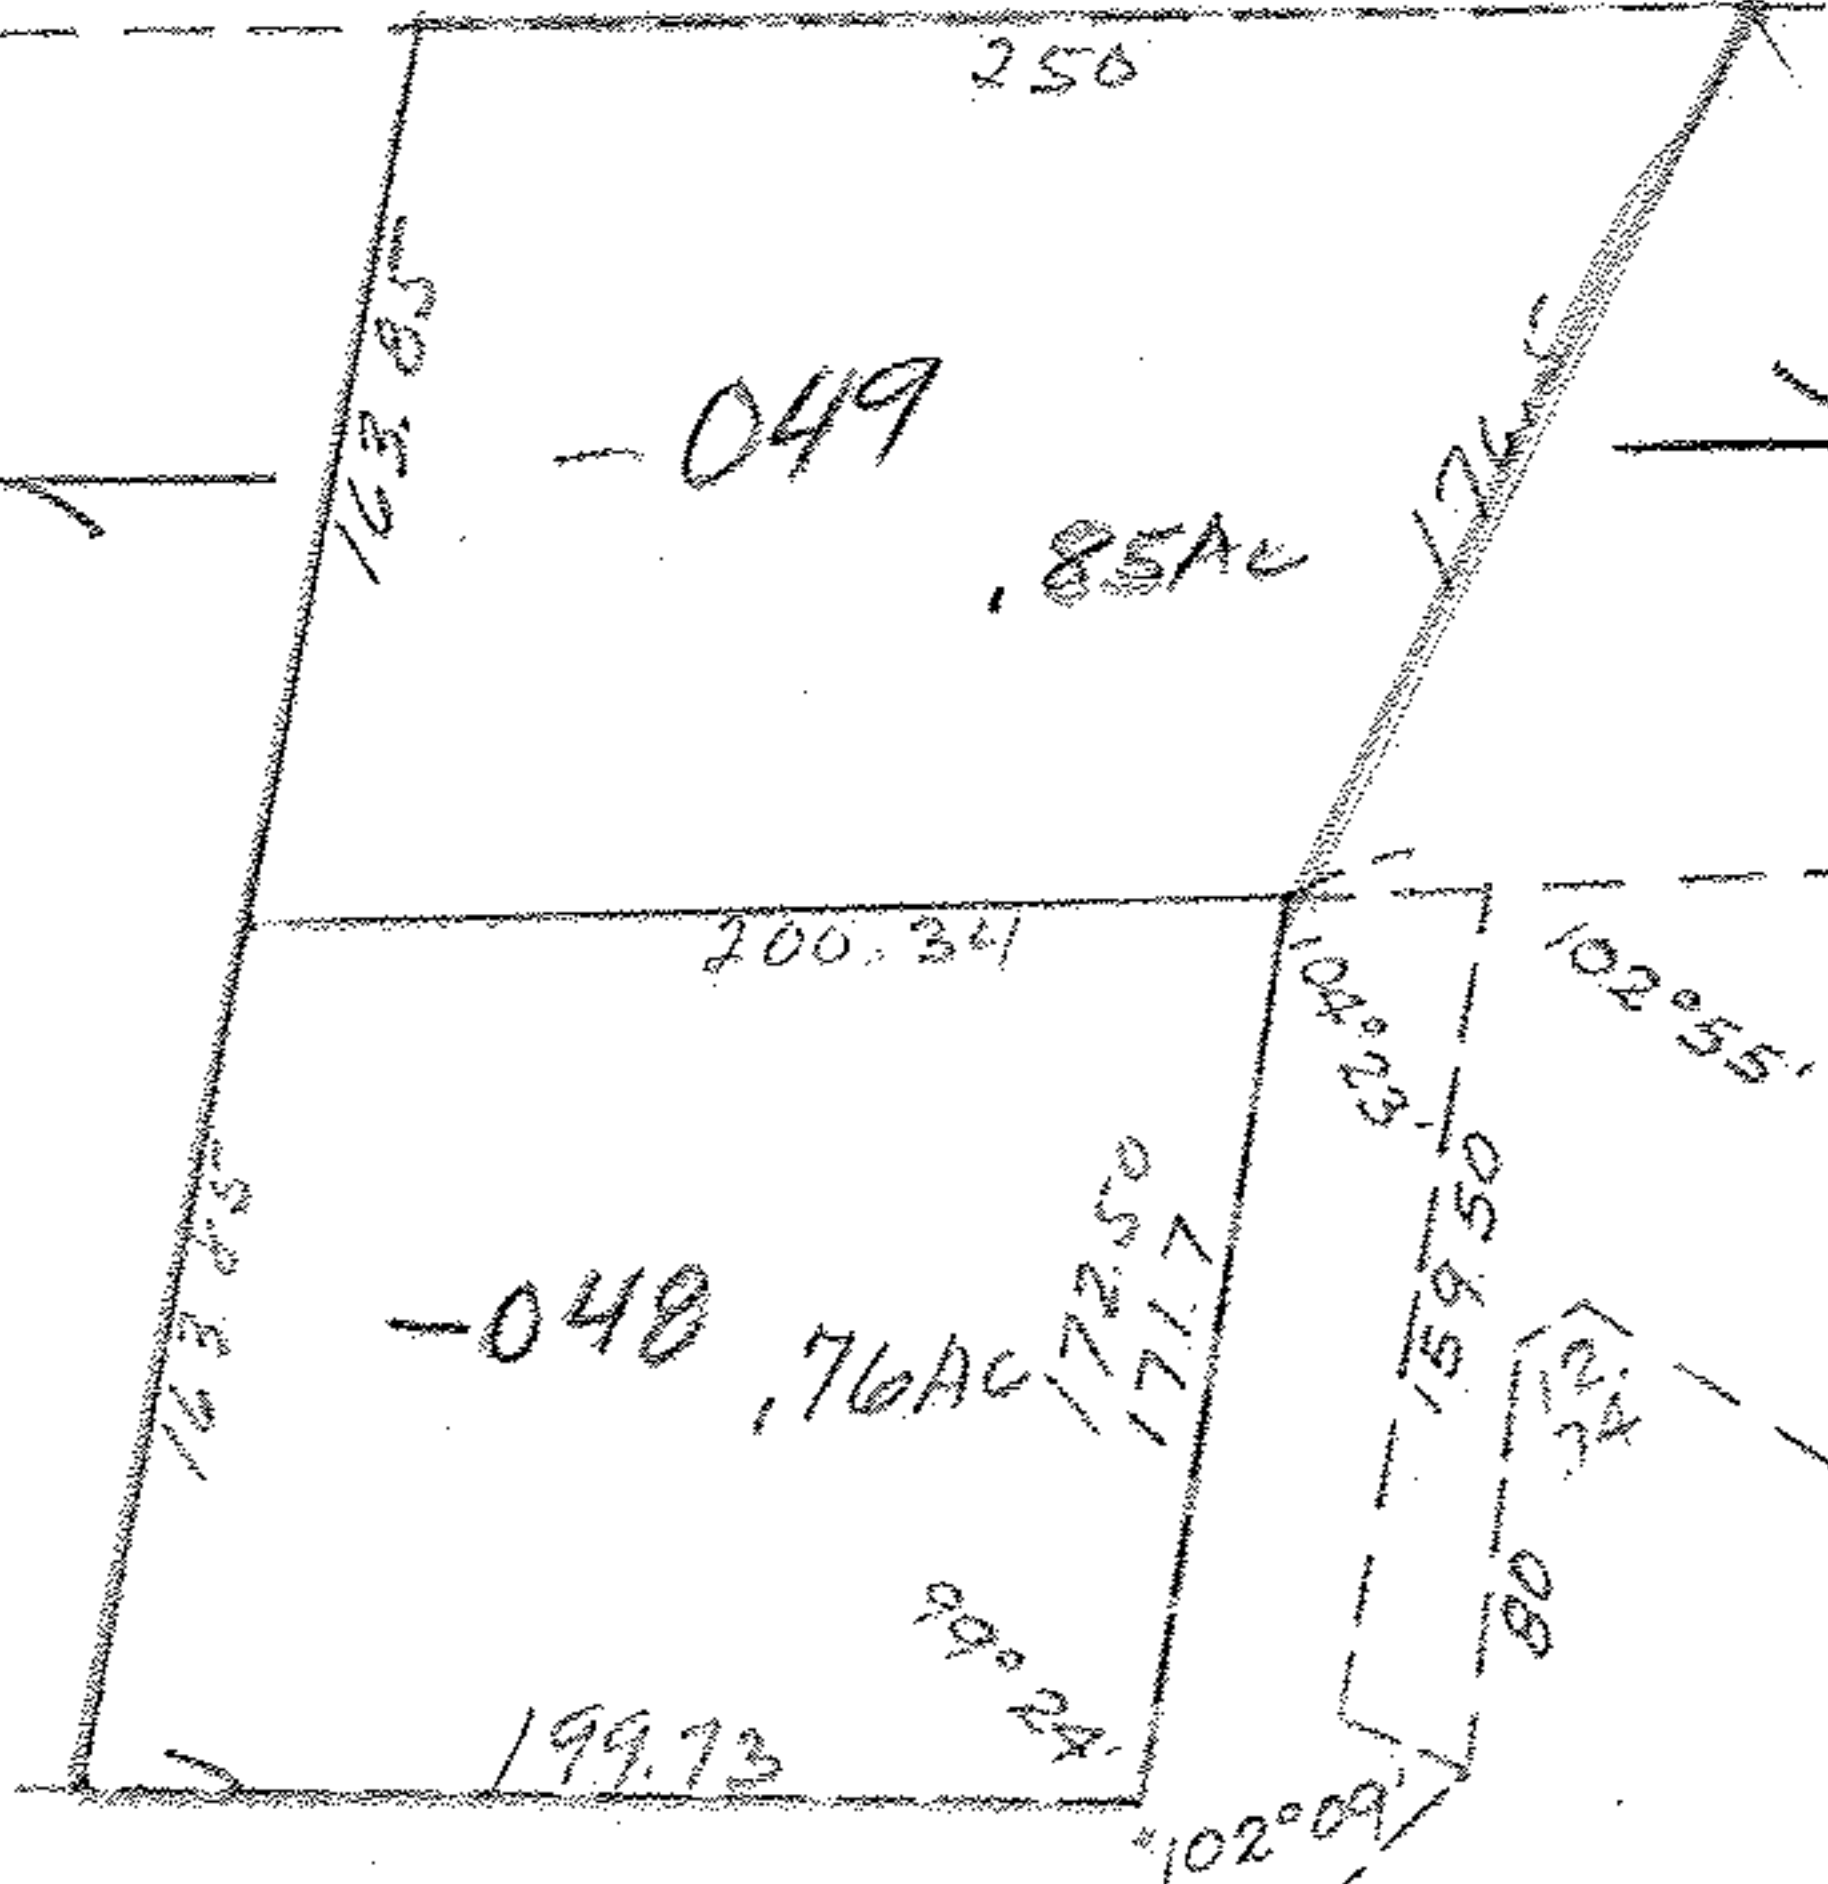

1525.0
1454.0

-007
7.22 A. - Dup #1
5.00 A. - Dup 2
12.22 A. - Total

7844
APPROVED
LORAIN CO.
MAP DEPT.
DATE 3-28-74
PAGE 05-00-016 A
BY
VOID
AFTER

7-31-86 L.L.

PKL

7-26-75