


#7845

SEE 5-00-045-A

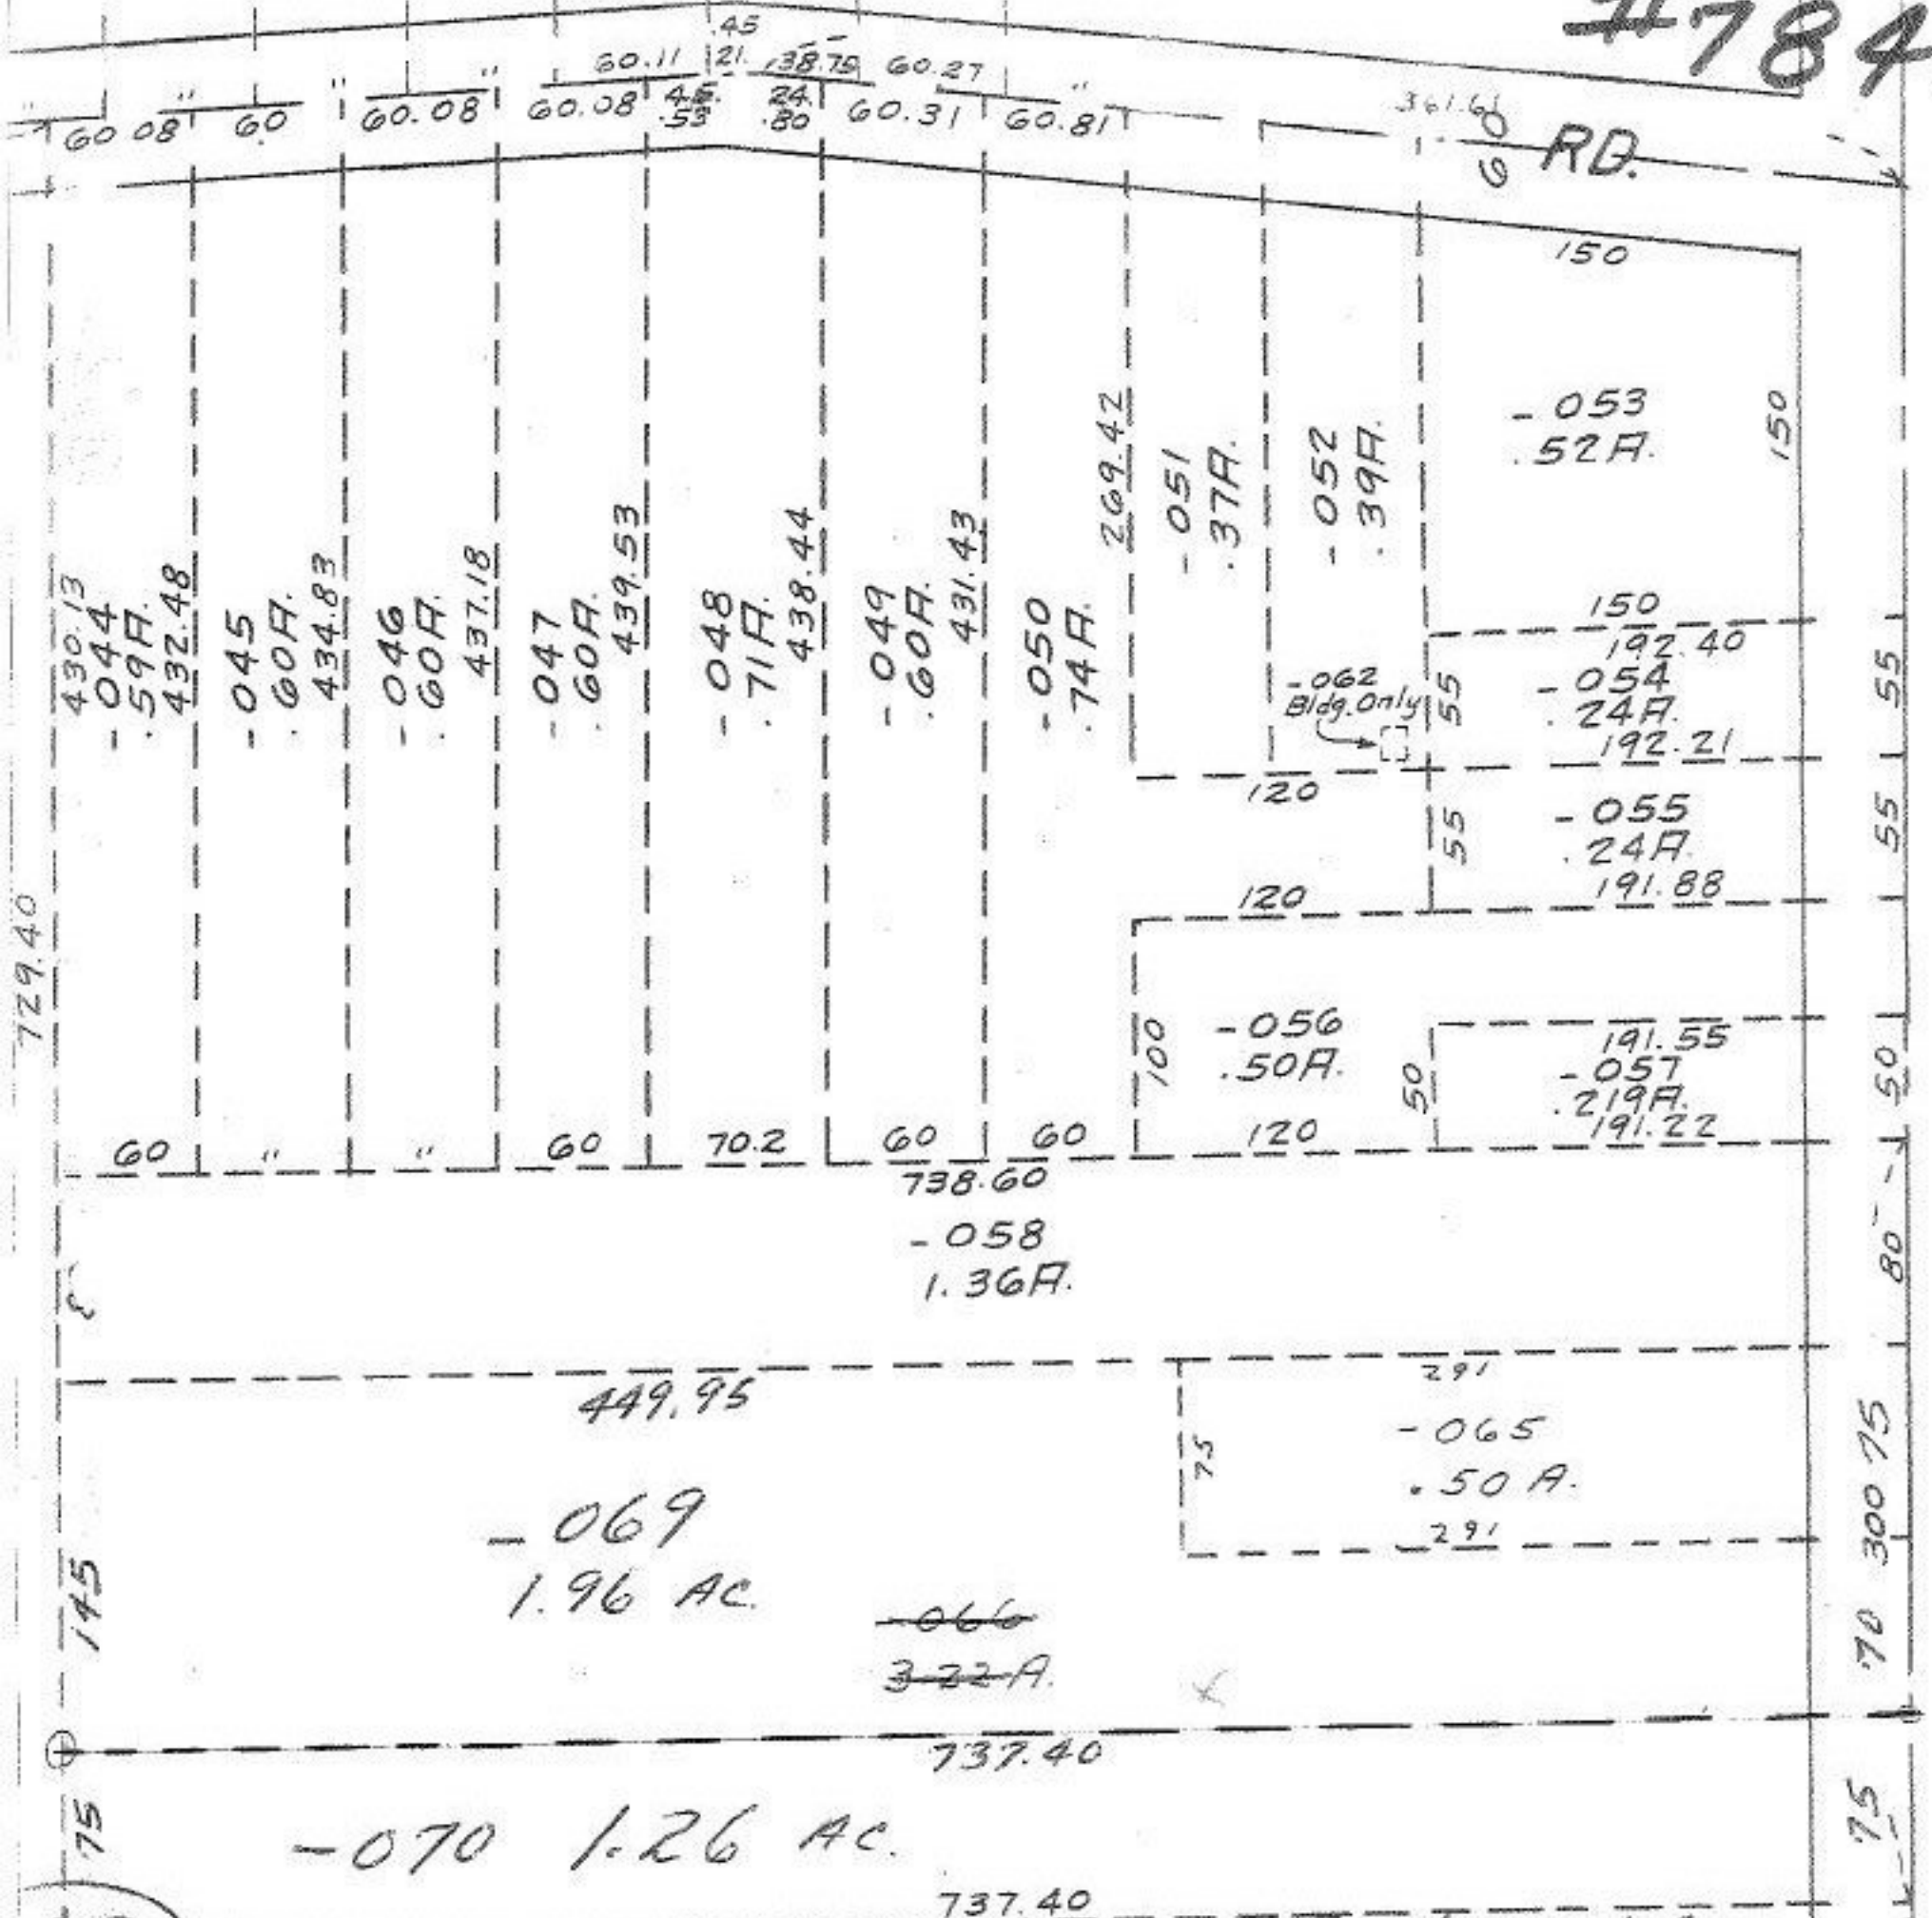

OK

[Handwritten signature]

-061

#7845

APPROVED
LORAIN CO.
MAP DEPT.

DATE 3-28-74

PAGE 500-036-B

BY Paul

VOID AFTER

[Handwritten notes]
3.28.74
1.96
1.26